

HC Fed 31-31B-45-14 & HC Fed 31-32-45-14 Multi-Well Plan

Red Lines

OIL AND GAS WELLS

- Oil and Gas Wells
- x Temporary Point

Well Name

CITIES TOWNS PLACES

- Towns and Places

ROADS AND RRS

- Major Highways


BLM O&G/LAND INFO

- QQS GCDB

SAN JUAN BASIN

- Fruitland PC

MUNICIPAL BOUNDARIES

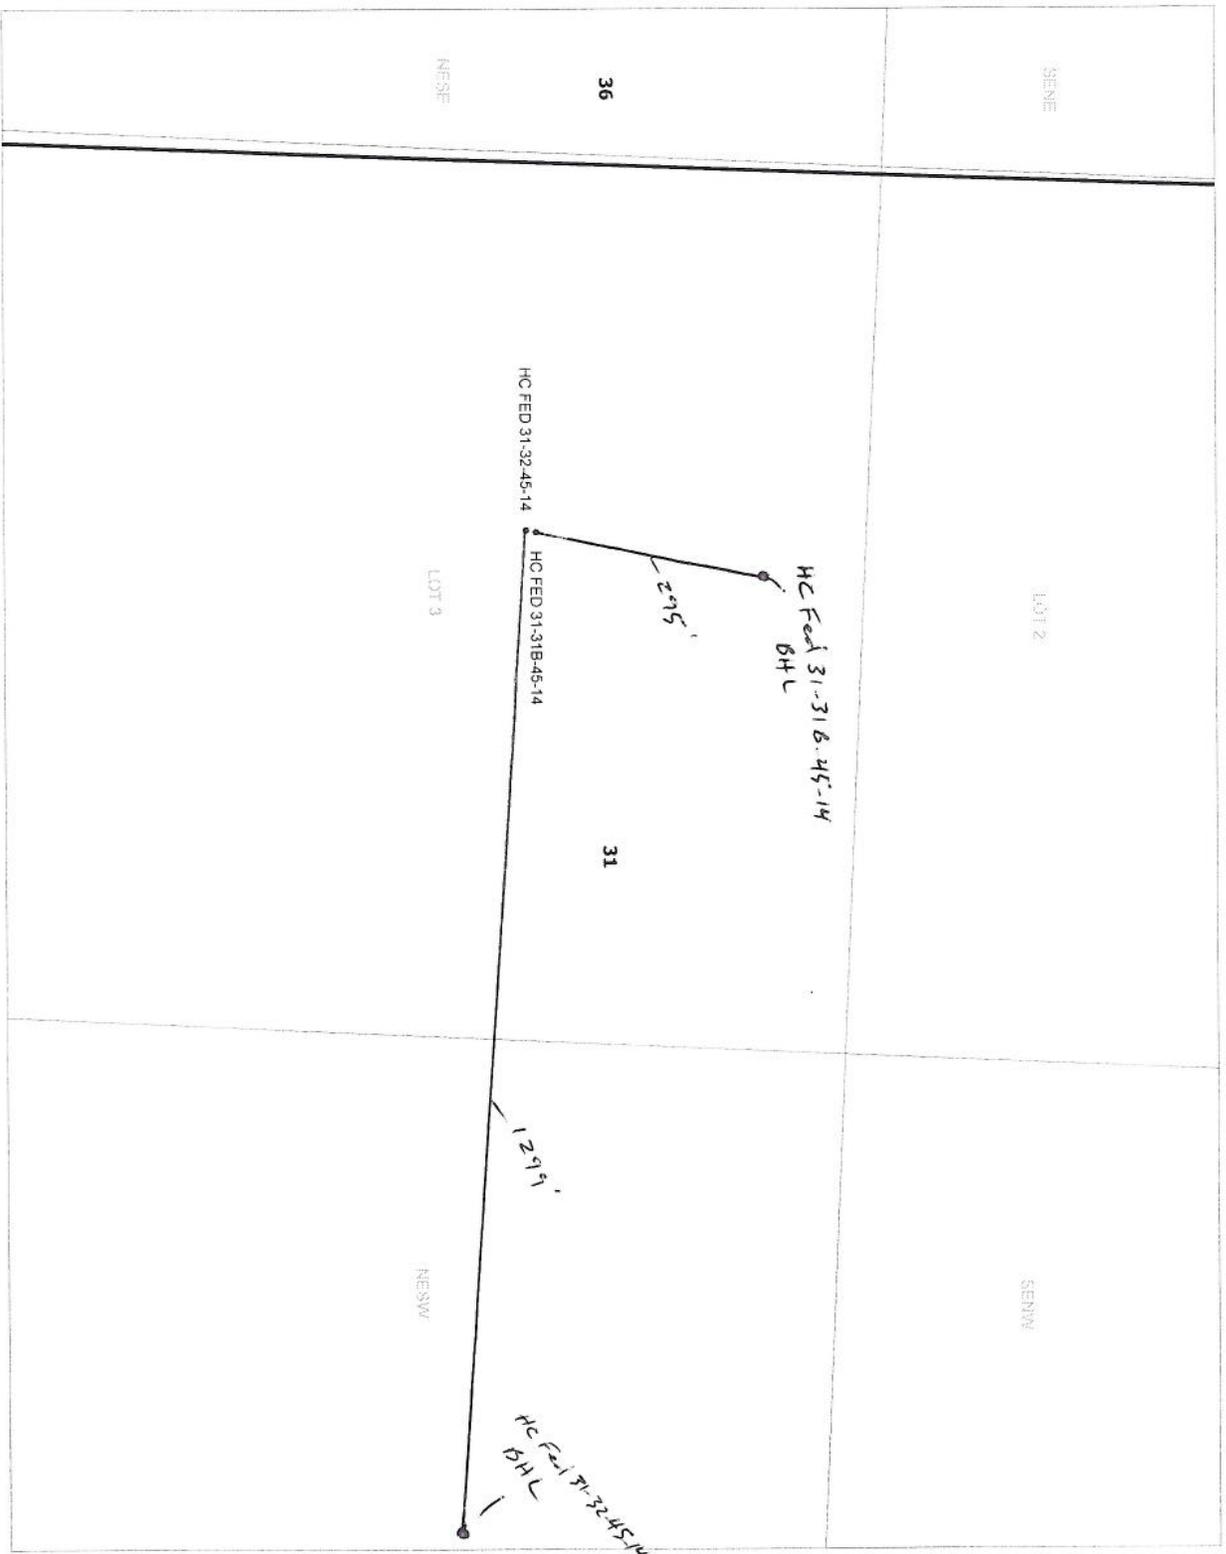

SCALE 1 : 3,406

