


R. 97 W.

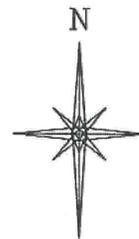

SCALE 1" = 1000'

T. 6 S.

SHL


LATITUDE (NAD 83)
NORTH 39.529503 DEG.
LONGITUDE (NAD 83)
WEST 108.213163 DEG.
NORTHING (NAD 27)
629167.16
EASTING (NAD 27)
1234983.28

BASIS OF BEARING/DATUM
SPCS CO CENTRAL NAD 27
BASED ON NGS TRIANGULATION
STATION "SHALE"

THE BASIS OF BEARINGS FOR
THIS SURVEY IS THE NORTH
LINE OF THE NW 1/4 OF
SECTION 15, MONUMENTED BY
GLO BC'S AND BEARING
N 88° 13' 57" W.

LEGEND

- △ AS-DRILLED CONDUCTOR
- APPROXIMATE BHL
- ⊗ TARGET LOCATION
- ┌ DENOTES 90° TIE
- FOUND MONUMENT

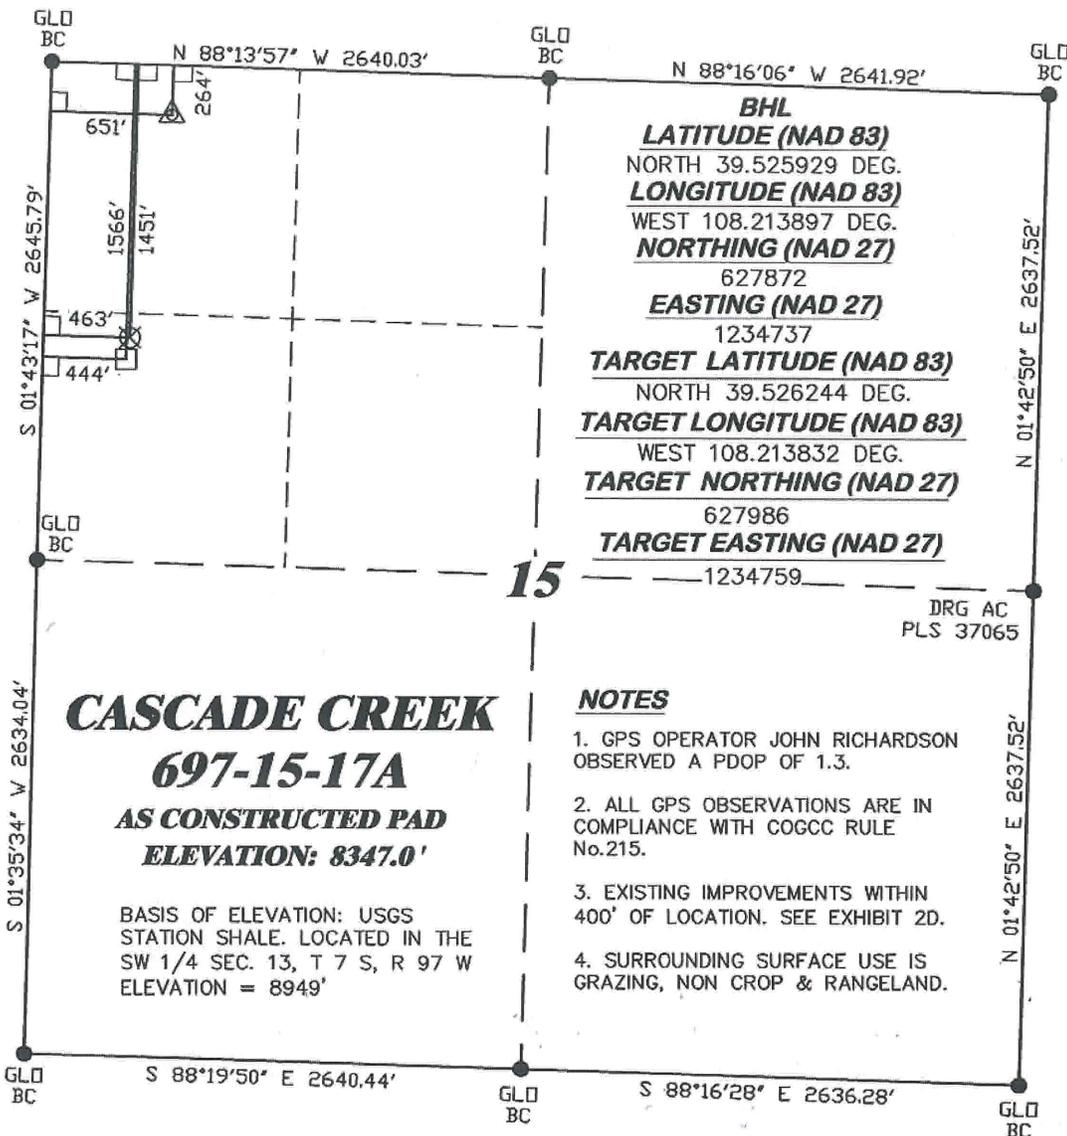

BHL
LATITUDE (NAD 83)
NORTH 39.525929 DEG.
LONGITUDE (NAD 83)
WEST 108.213897 DEG.
NORTHING (NAD 27)
627872

EASTING (NAD 27)
1234737
TARGET LATITUDE (NAD 83)
NORTH 39.526244 DEG.
TARGET LONGITUDE (NAD 83)
WEST 108.213832 DEG.
TARGET NORTHING (NAD 27)
627986
TARGET EASTING (NAD 27)
1234759

DRG AC
PLS 37065

NOTES

1. GPS OPERATOR JOHN RICHARDSON OBSERVED A PDOP OF 1.3.
2. ALL GPS OBSERVATIONS ARE IN COMPLIANCE WITH COGCC RULE No.215.
3. EXISTING IMPROVEMENTS WITHIN 400' OF LOCATION. SEE EXHIBIT 2D.
4. SURROUNDING SURFACE USE IS GRAZING, NON CROP & RANGELAND.

CASCADE CREEK 697-15-17A

AS CONSTRUCTED PAD
ELEVATION: 8347.0'

BASIS OF ELEVATION: USGS
STATION SHALE. LOCATED IN THE
SW 1/4 SEC. 13, T 7 S, R 97 W
ELEVATION = 8949'



SURVEYOR'S STATEMENT

I, RONALD C. RENNKE, AN EMPLOYEE AND AGENT ON BEHALF OF D.R. GRIFFIN & ASSOCIATES, INC. STATE THE PLAT HEREON IS A CORRECT REPRESENTATION OF A SURVEY MADE UNDER MY SUPERVISION ON DECEMBER 23, 2009 OF THE SHOWN CASCADE CREEK 697-15-17A AS DRILLED CONDUCTOR.

Notice: In accordance with Colorado State Law, any legal action based upon any defect in this survey plat must commence within three (3) years after first discovery of such defect. In no event, may any action based upon any defect in this survey plat be commenced more than ten (10) years from the date of certification shown hereon.

697-15-01 PAD



COLORADO PLS No. 37065

DRG GRIFFIN & ASSOCIATES, INC.
(307) 362-5028 1414 ELK ST., ROCK SPRINGS, WY 82901

**PLAT OF AS DRILLED CONDUCTOR FOR
OXY USA WTP LP
SHL IN NWNW SECTION 15
264' F/NL & 651' F/WL, SECTION 15,
T. 6 S., R. 97 W., 6th P.M.
GARFIELD COUNTY, COLORADO**

DRAWN: 2/16/2010 - DEH	SCALE: 1" = 1000'
REVISED: N/A	DRG JOB No. 10845
	EXHIBIT 1