


# Pine Ridge Oil & Gas LLC, Lake 34-29, SWSE Sec 29 19S 69W, Hydrology Map

- Red Lines
- OIL AND GAS WELLS**
  - Oil and Gas Wells
  - Temporary Point
  - Buffer layer
- CITIES TOWNS PLACES**
  - Towns and Places
- ROADS AND RRS**
  - Major Highways
- WATER RESOURCES**
  - Water Wells
- SAN JUAN BASIN**
  - Fruitland PC
- TOPOS (1: 24K)**
  - SE Colorado Topo



SCALE 1 : 4,987

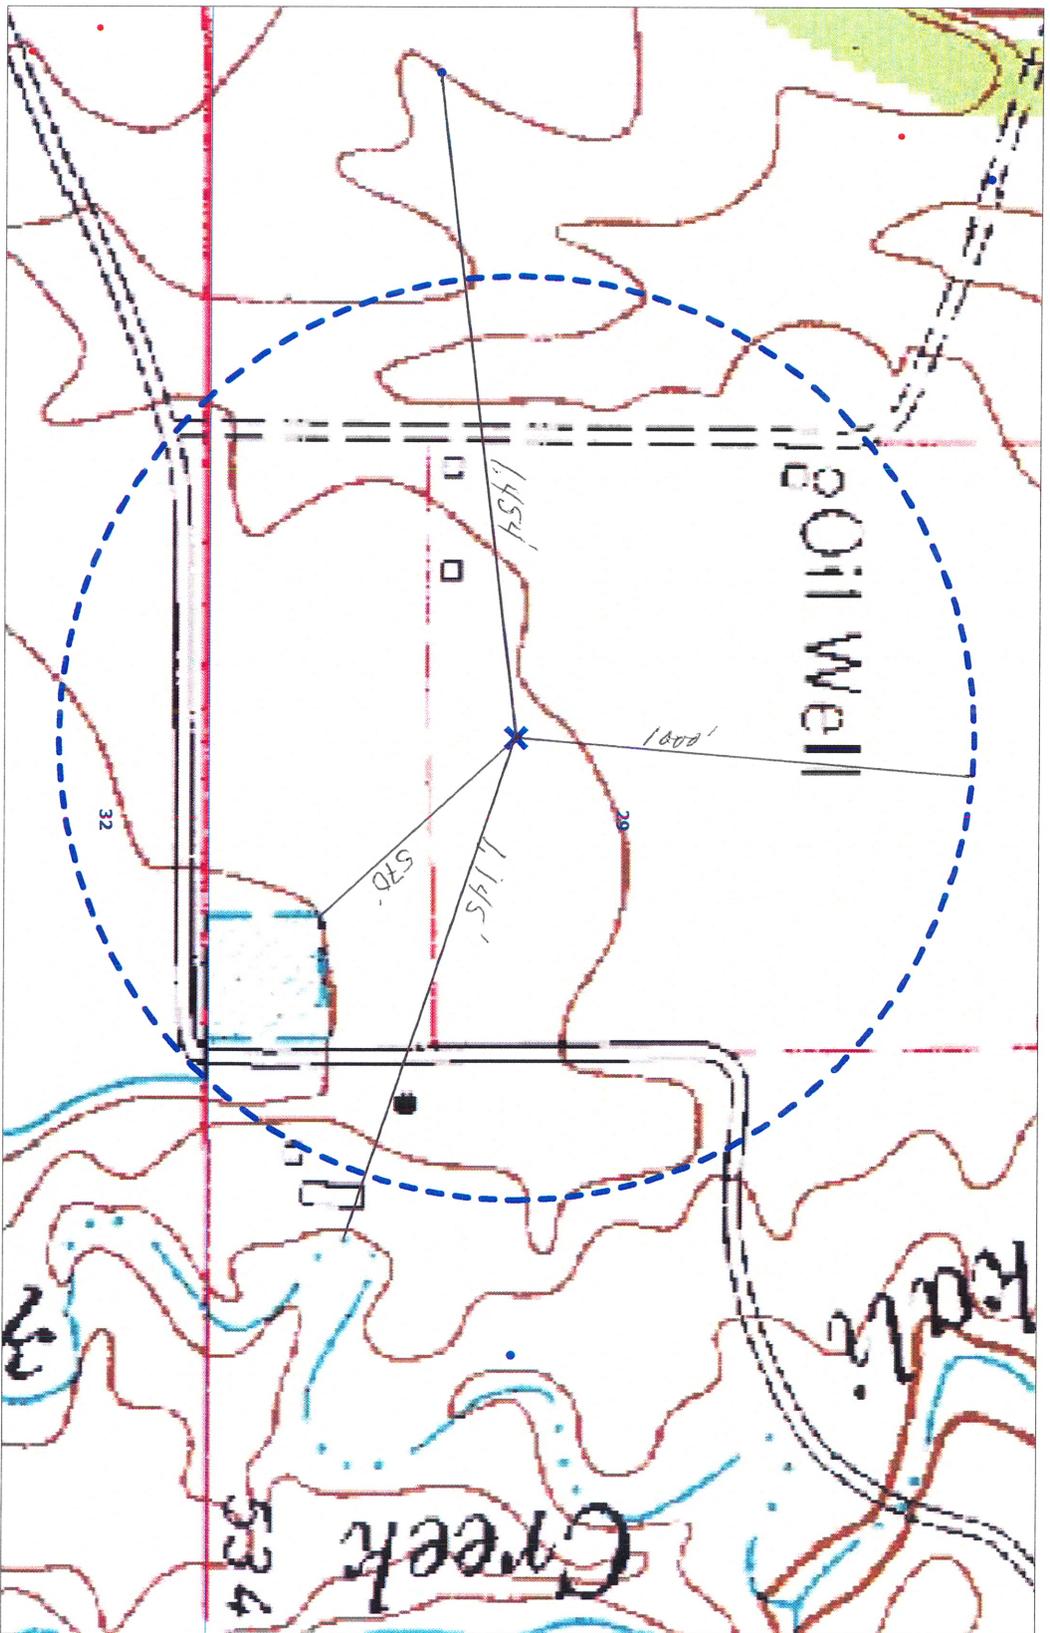