


Hydrology Map - Williams 18-16 - SESE Sec. 18, T2N R68W

- Red Lines
- OIL AND GAS WELLS
 - Oil and Gas Wells
 - Temporary Point
- Buffer layer
- CITIES TOWNS PLACES
 - Towns and Places
- ROADS AND RRS
 - Major Highways
- WATER RESOURCES
 - Water Wells
- SAN JUAN BASIN
 - Fruitland PC
- TOPOS (1:24K)
 - NE Colorado Topo

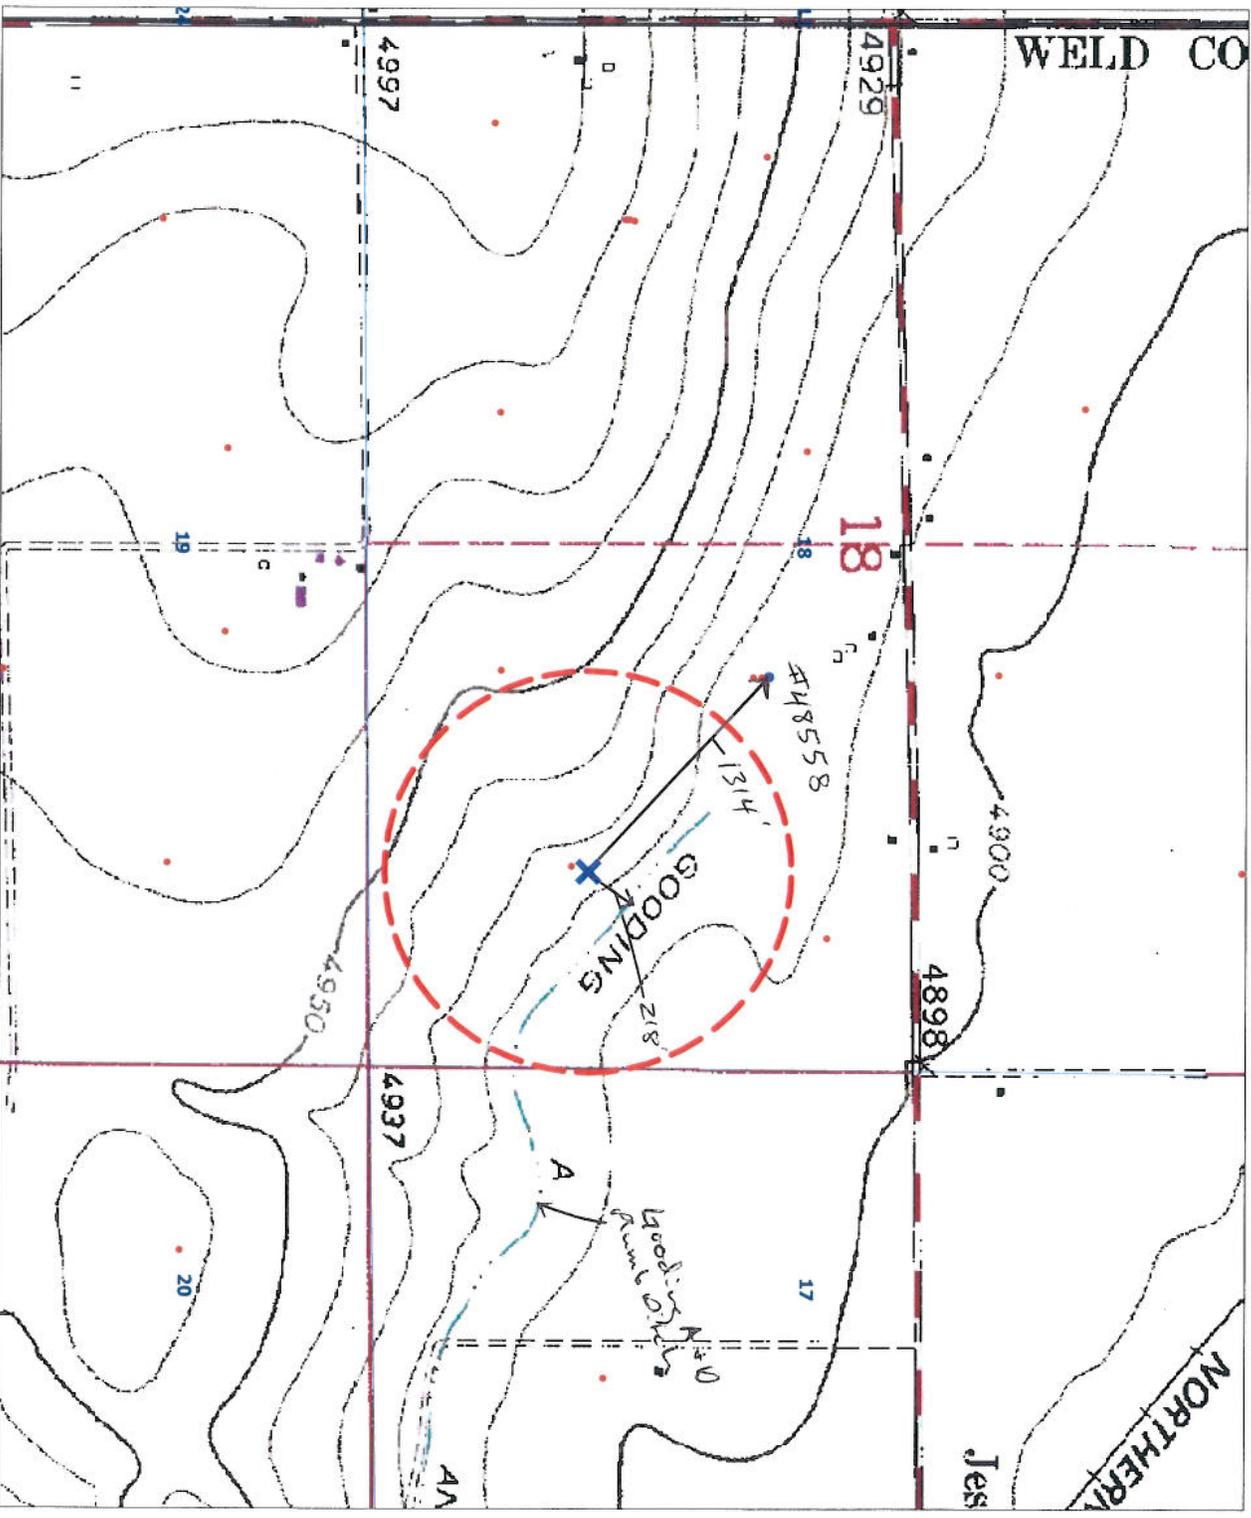

SCALE 1 : 11,317

