



EXHIBIT "A"
LOGAN WASH 28-10 SALT WATER
DISPOSAL FACILITY AS-BUILT
NW1/4 SE1/4 SEC 31 T7S R97W
6th PM GARFIELD COUNTY COLORADO

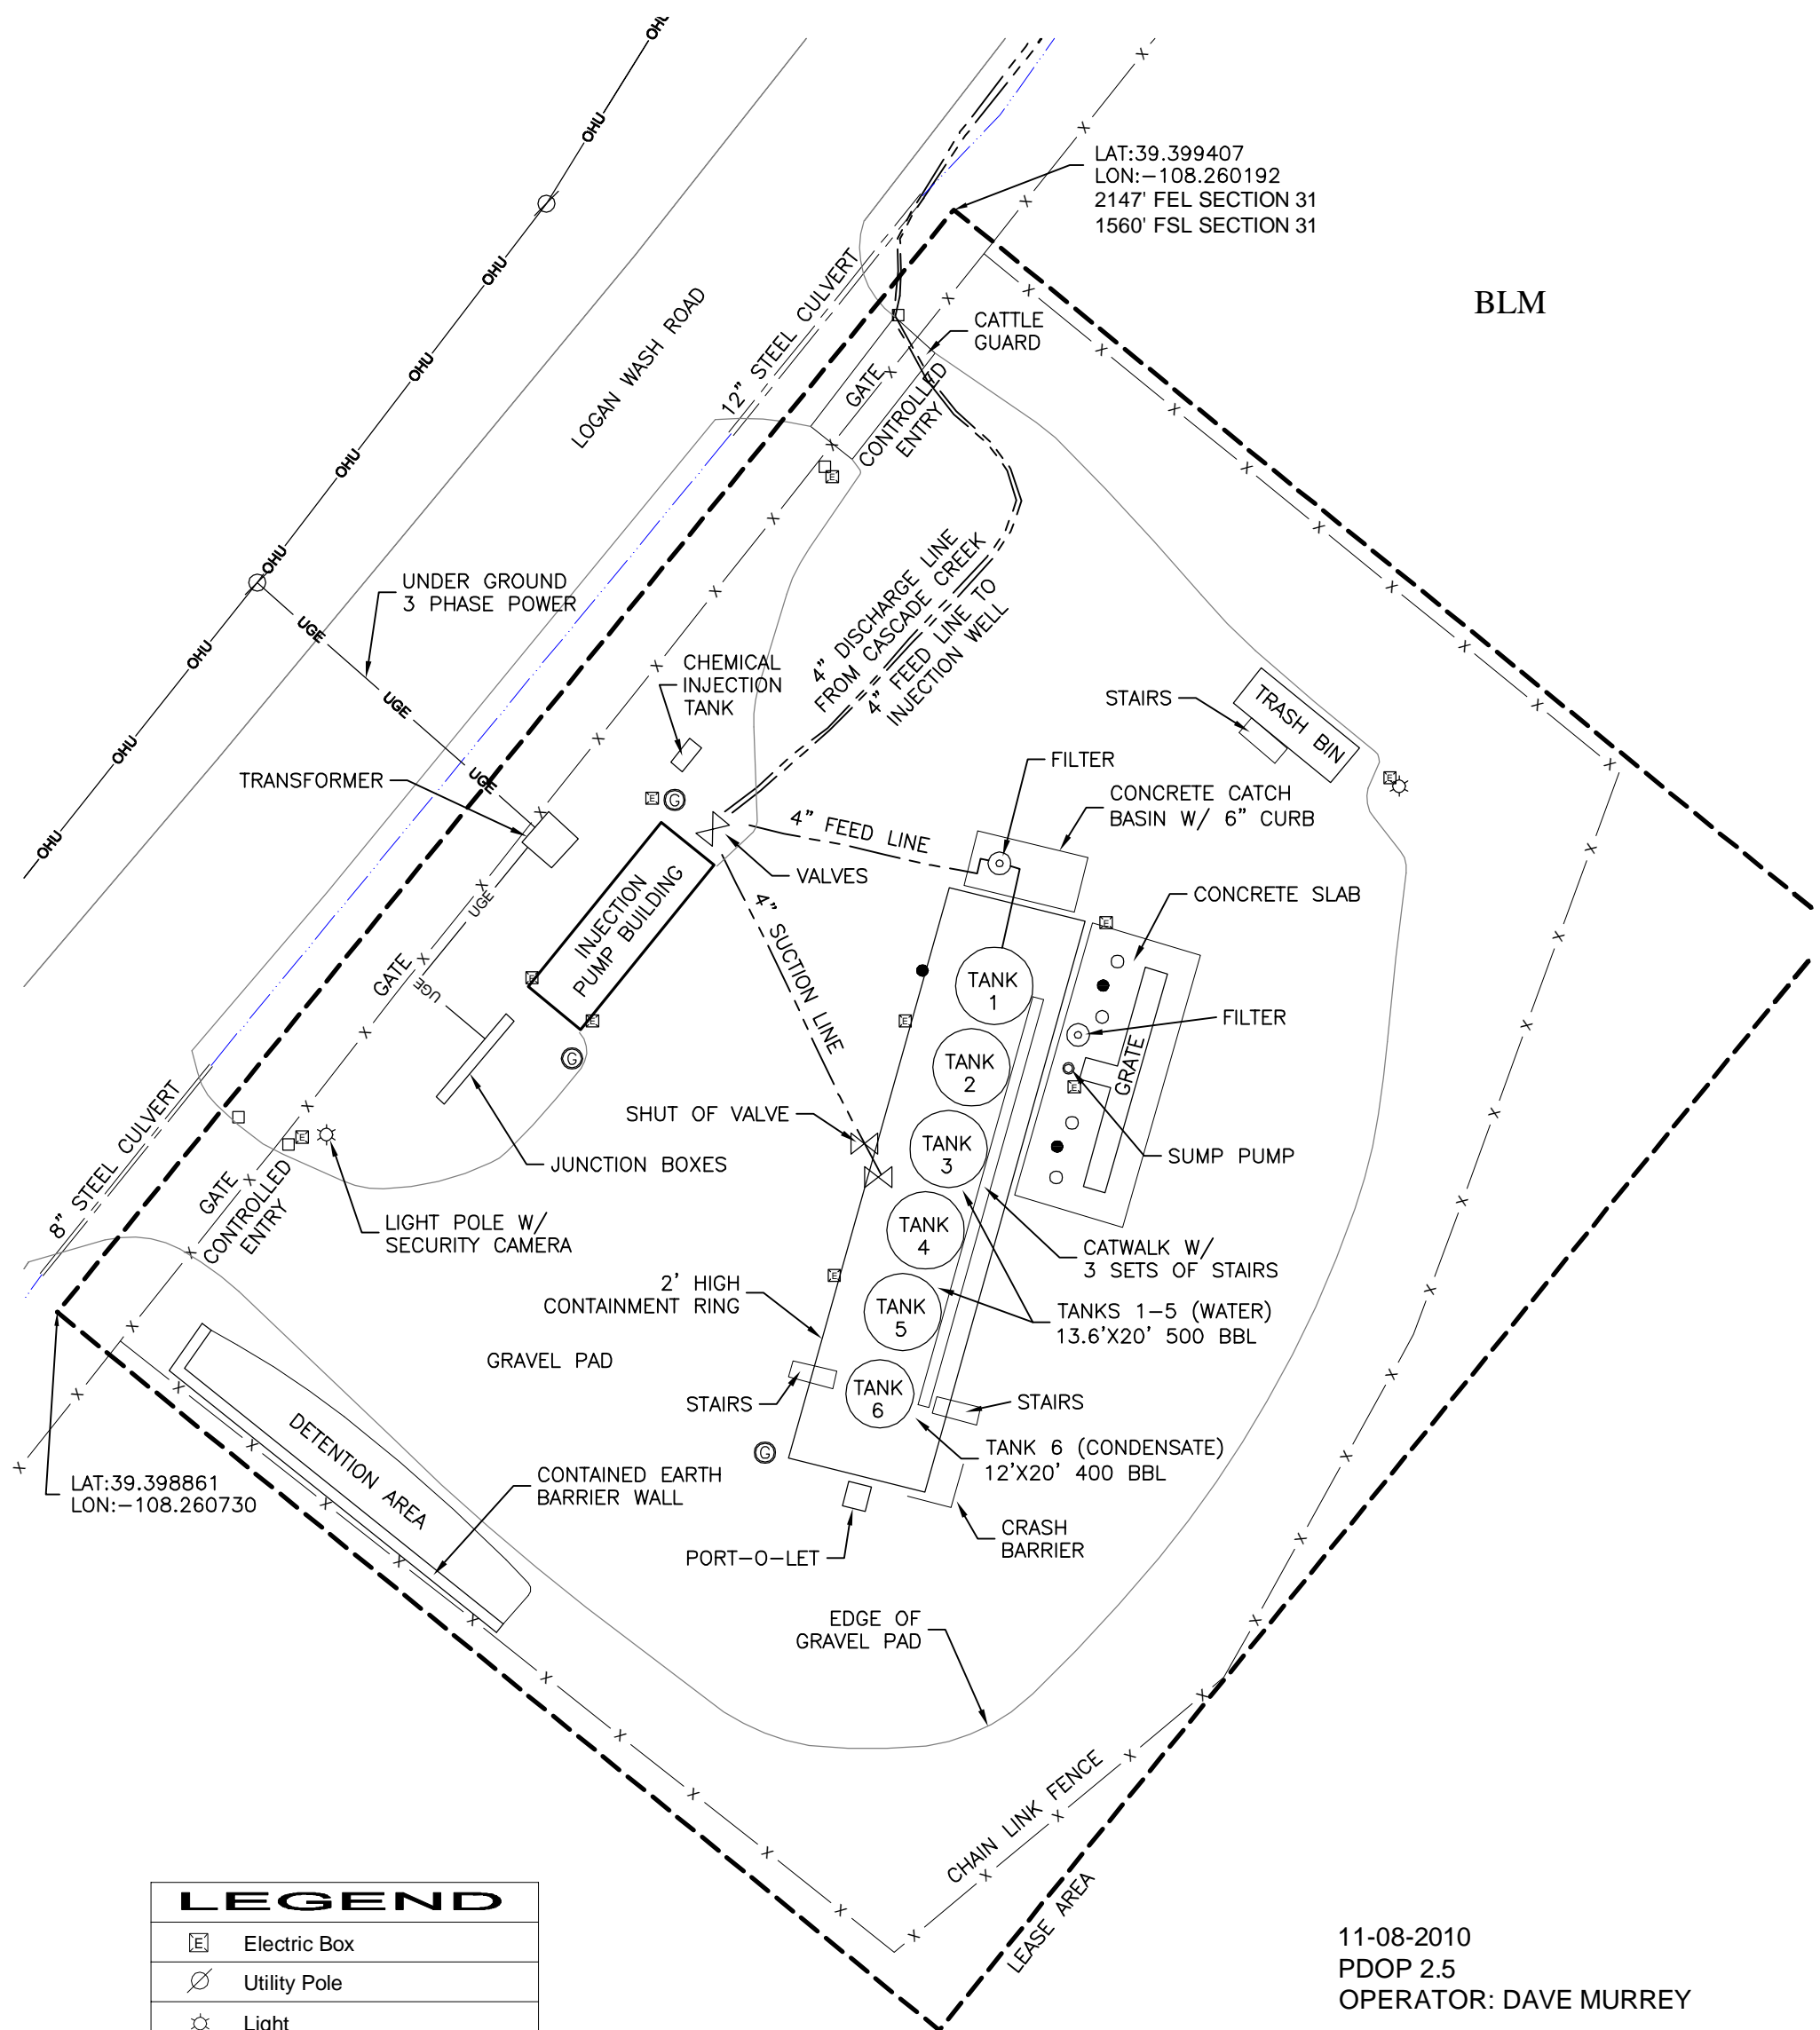

LEGEND	
	Electric Box
	Utility Pole
	Light
	Bollard
	Valve
	Grounding Rod
	Gate Controller
	Truck Load-in
	Overhead Utility
	Underground Electric

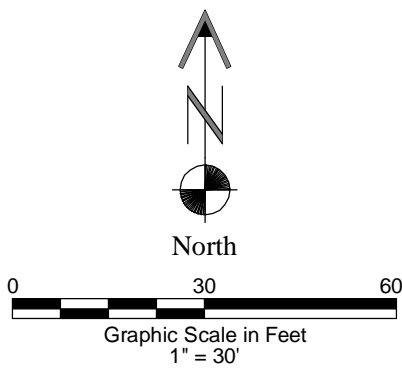

11-08-2010
PDOP 2.5
OPERATOR: DAVE MURREY