


**NOBLE 34F
AS-BUILT CONDUCTORS**




**AS-BUILT
CONDUCTORS
NAD 83**

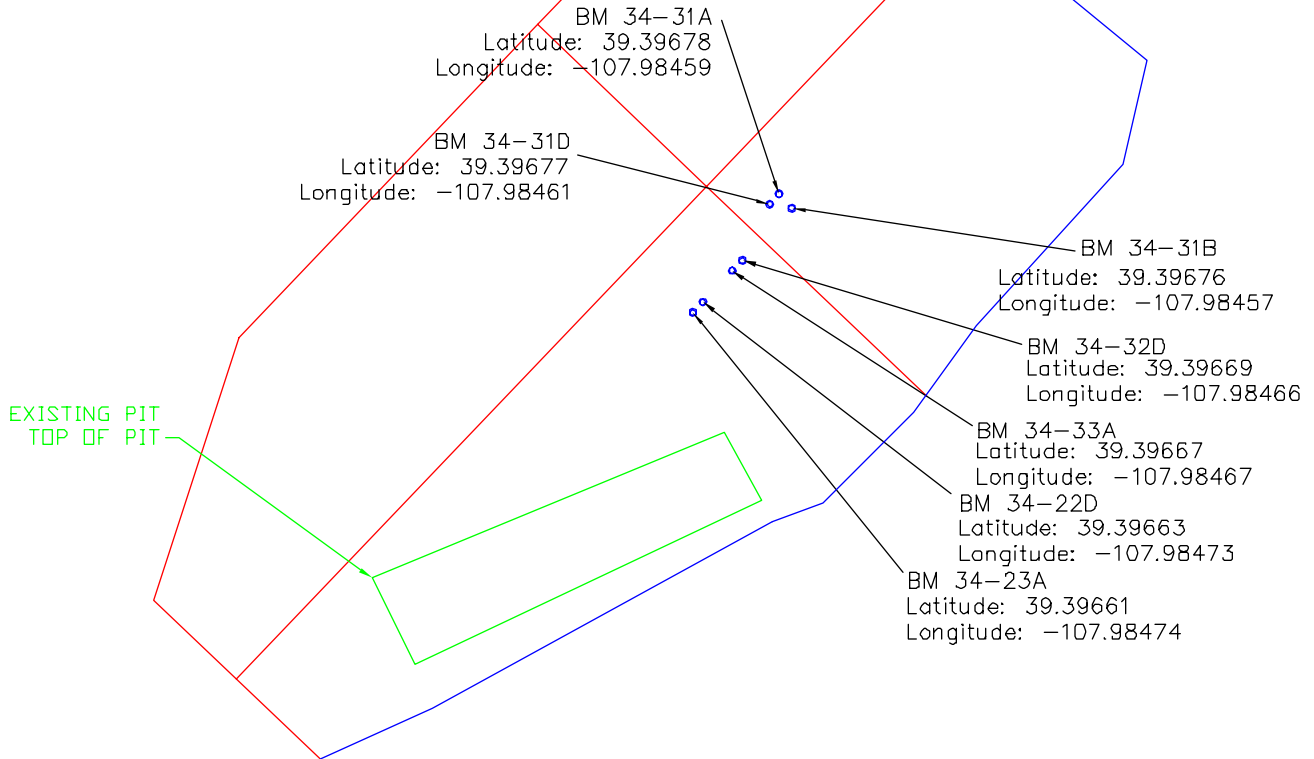

CONDUCTOR NAME	STATE PLANE NAD 83 NORTHING	STATE PLANE NAD 83 EASTING	LATITUDE NAD 83 DECIMAL DEGREES	LONGITUDE NAD 83
BM 34-31A	N 1579009.6620	E 2297946.1850	39.39678	-107.98459
BM 34-31D	N 1579004.3970	E 2297941.3490	39.39677	-107.98461
BM 34-31B	N 1579002.4790	E 2297952.7970	39.39676	-107.98457
BM 34-32D	N 1578975.0840	E 2297927.1040	39.39669	-107.98466
BM 34-33A	N 1578969.9050	E 2297921.6910	39.39667	-107.98467
BM 34-22D	N 1578953.3690	E 2297906.4860	39.39663	-107.98473
BM 34-23A	N 1578948.0390	E 2297901.4060	39.39661	-107.98474

- NOTE: 1) ALL AS-BUILT DATA IS NAD 83 STATE PLANE
ZONE COLORADO CENTRAL US FOOT (0502)
2) PDOP=1.9 AT TIME OF SURVEY
3) OPERATOR: ROBERT WOOD
4) AS-BUILT DATE: 4/23/09

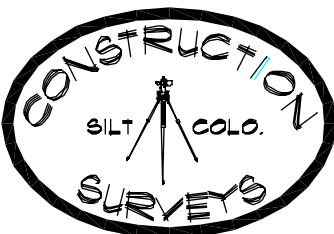

CONSTRUCTION SURVEYS, INC.
0012 SUNRISE BLVD.
SILT, CO 81652
(970)876-5753

**NOBLE 34F PAD
NOBLE ENERGY INC.**

SCALE: 1" = 100'

SHEET: 1 OF 2