

Encana OIL & GAS (USA) INC.

LOCATION DRAWING FOR

WELL PAD H04 596 (AS-BUILT)

SECTION 4, T5S, R96W, 6th P.M.

SE 1/4 NE 1/4



Sheet 6a of 9

LOT 4



DATE: 11-23-10  
DRAWN BY: D.R.B.  
Revised: 04-18-12 D.R.B.

LOT 1

C.C.  
NE Cor Sec 4  
1970 Brass Cap  
0.5' High, Pile of  
Stones, Fence  
Lat: 39.651322°  
Long: 108.164839°


N00°11'23"W - 2654.26' (Meas. to C.C.)  
N00°11'23"W - 2653.24' (Meas. To True)

NE 1/4

NW 1/4

Encana Oil &  
Gas (USA) Inc.

Encana Oil &  
Gas (USA) Inc.

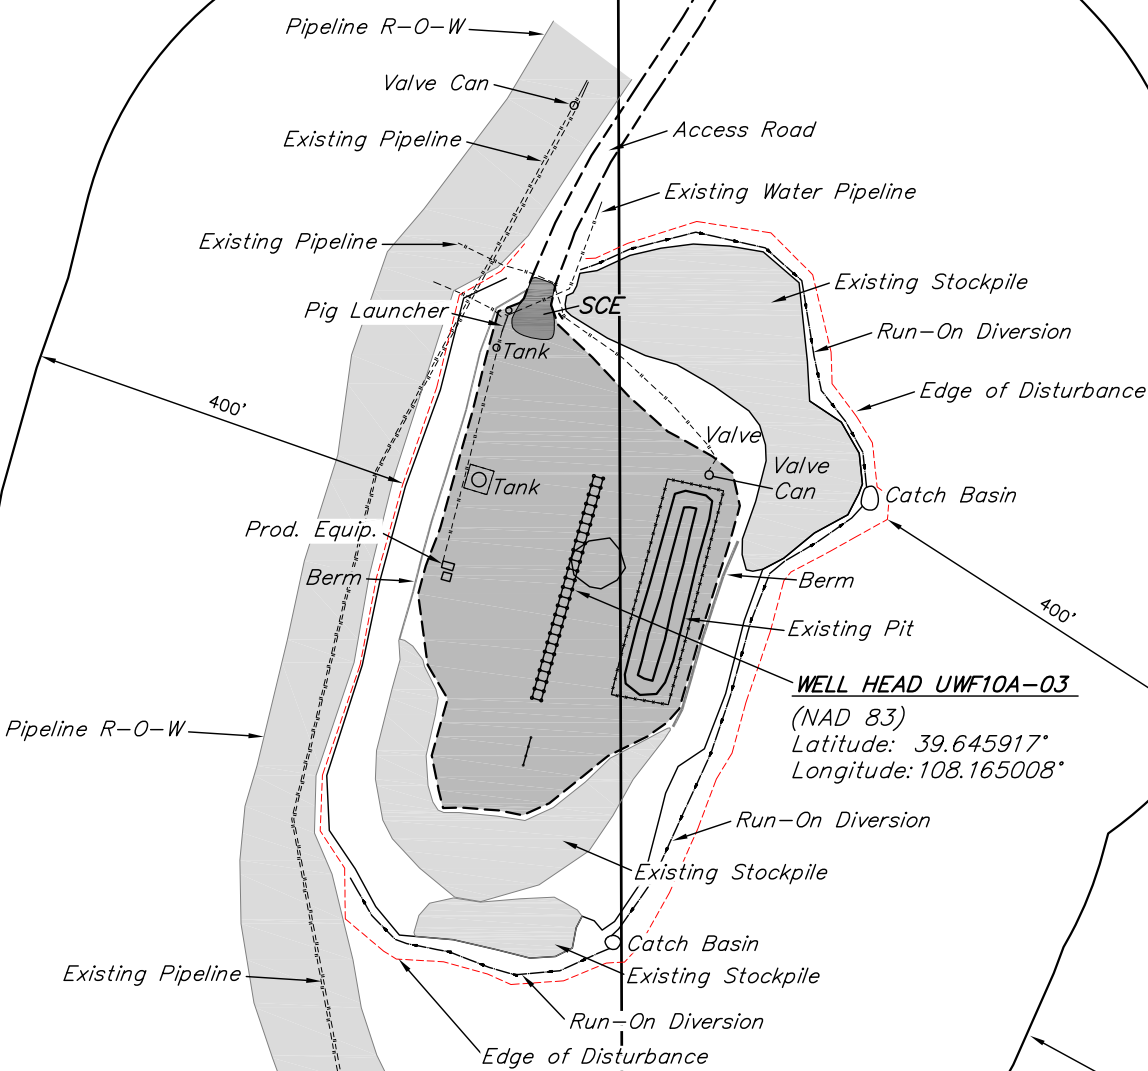

DISTURBANCE ACREAGE:

2.705 ± DRILLING OPERATIONS  
(AS-BUILT PAD)  
2.568 ± INTERIM RECLAIM

CURRENT LAND USE

CROP LAND: ☐ IRRIGATED ☐ DRY LAND ☐ IMPROVED PASTURE ☐ HAY MEADOW ☐ CRP  
NON-CROP LAND: ☒ RANGELAND ☐ TIMBER ☐ RECREATIONAL ☐ OTHER (Describe) \_\_\_\_\_  
SUBDIVIDED: ☐ INDUSTRIAL ☐ COMMERCIAL ☐ RESIDENTIAL \_\_\_\_\_

FUTURE LAND USE

CROP LAND: ☐ IRRIGATED ☐ DRY LAND ☐ IMPROVED PASTURE ☐ HAY MEADOW ☐ CRP  
NON-CROP LAND: ☒ RANGELAND ☐ TIMBER ☐ RECREATIONAL ☐ OTHER (Describe) \_\_\_\_\_  
SUBDIVIDED: ☐ INDUSTRIAL ☐ COMMERCIAL ☐ RESIDENTIAL \_\_\_\_\_

PLANT COMMUNITY

☐ DISTURBED GRASSLAND  
☐ NATIVE GRASSLAND  
☐ SHRUB LAND  
☐ PLAINS RIPARIAN  
☐ MOUNTAIN RIPARIAN  
☒ FOREST LAND  
☐ WETLANDS AQUATIC  
☐ ALPINE  
☐ OTHER (Describe): \_\_\_\_\_

Existing Features (Distance from UWF10A-03)

|               |                  |
|---------------|------------------|
| Building      | N36°E 23,800'    |
| Public Road   | N07°E 3,100'     |
| Property Line | N51°W 3,093'     |
| Utility       | S49°E 17,315'    |
| Surface Water | S18°W 5,050'     |
| Railroad      | S28°E 12.5 MILES |

SE Cor Sec 4  
1917 Brass Cap  
2.3' High  
Lat: 39.636808°  
Long: 108.164797°

UINTAH ENGINEERING & LAND SURVEYING  
85 So. 200 East \* Vernal, Utah 84078 \* (435) 789-1017