





UNGRADED ELEVATION: 6328.6'  
DESIGN ELEVATION: 6317.0'  
FINISHED ELEVATION: 6326.4'  
APPROXIMATE DISTURBED AREA: 2.1± ACRES  
ACTUAL DISTURBED AREA: 1.4± ACRES

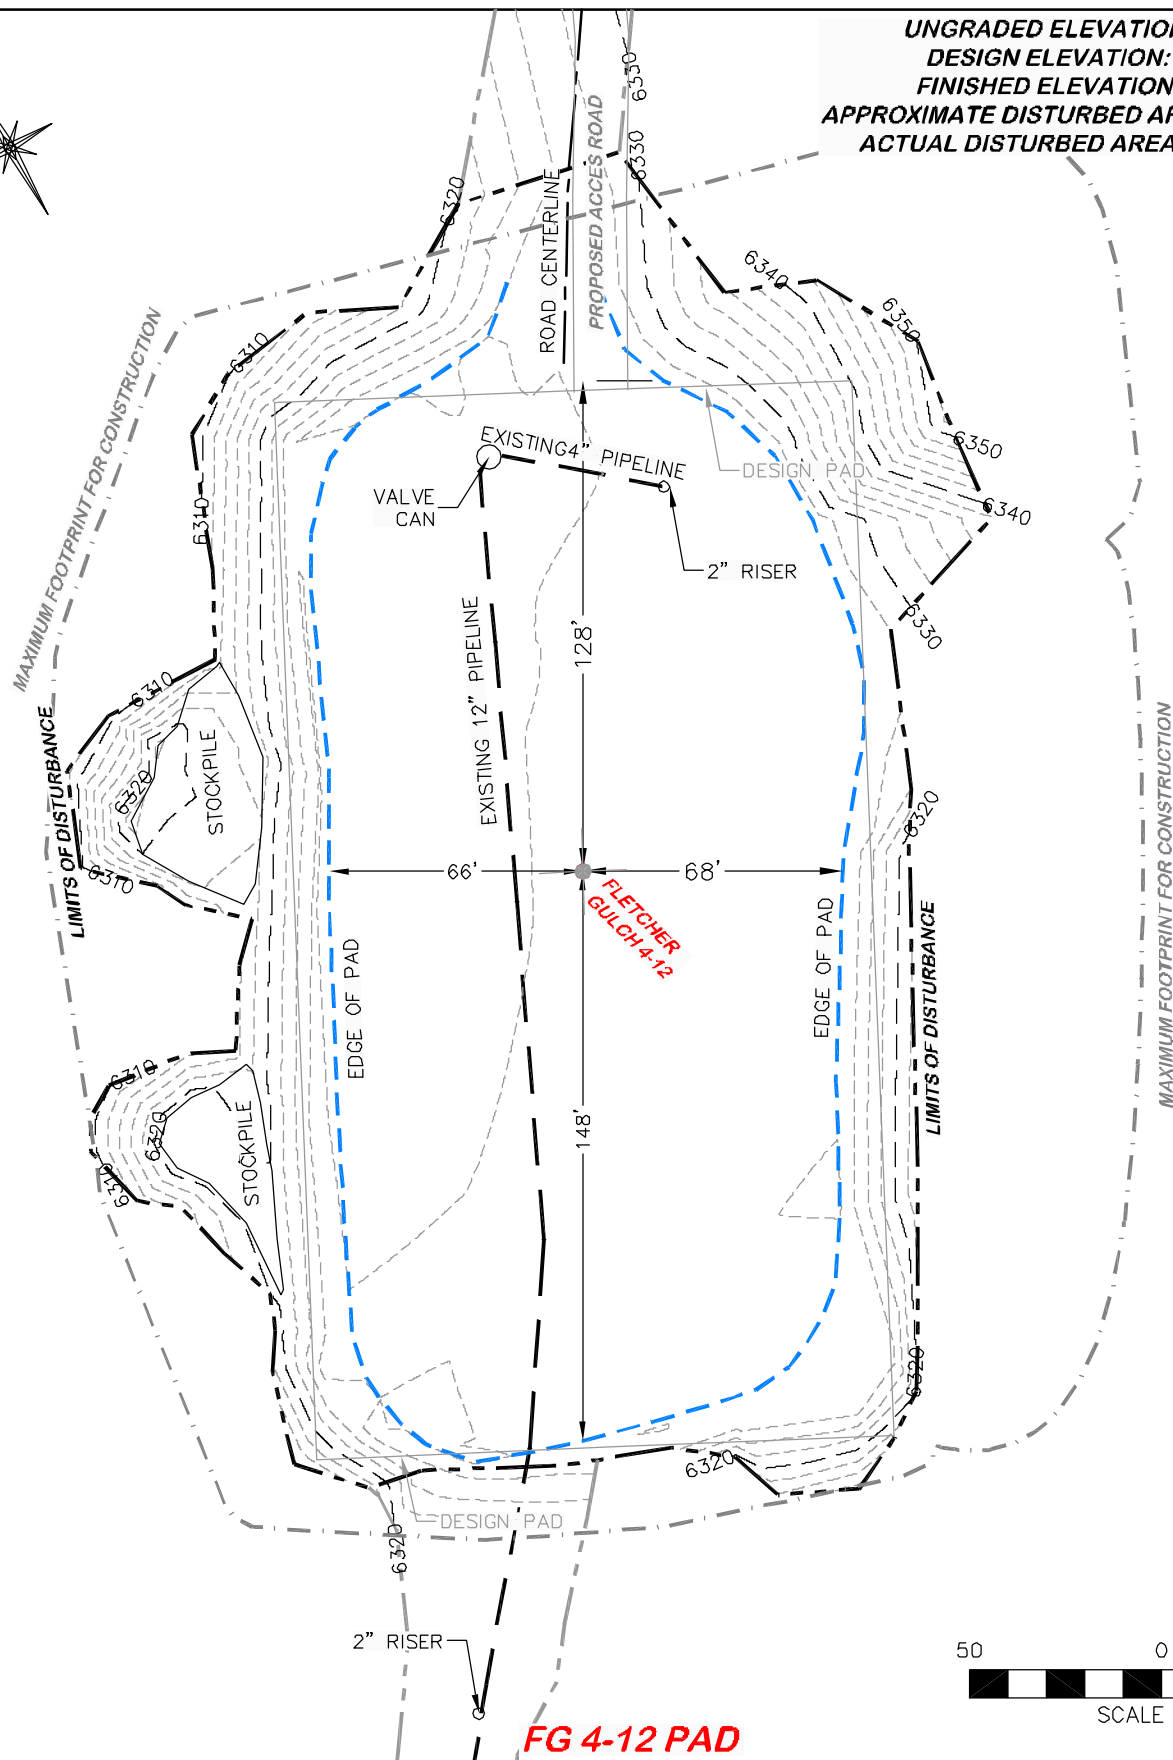

**FG 4-12 PAD**

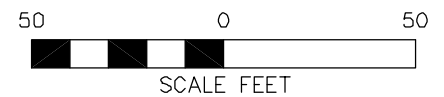

**RIFFIN & ASSOCIATES, INC.**  
1414 ELK ST., ROCK SPRINGS, WY 82901

(307) 362-5028

DRAWN: 12/13/11 - TCM

SCALE: 1" = 50'

REVISED:

DRG JOB No. 16511

PAD ASBUILT

**ASBUILT DRAWING**

**GENESIS GAS & OIL, LLC.**

**FLETCHER GULCH 4-12**

**NE1/4 OF NW 1/4 SECTION 4, T1N, R100W, 6th P.M.,  
RIO BLANCO COUNTY, COLORADO**

UNGRADED ELEVATION: 6328.6'  
FINISHED ELEVATION: 6326.4'