

PLOTTED: 7/31/2013 12:33:11 PM BY: DENNY FALLS
 LAST SAVED: 7/31/2013 12:29:46 PM BY: DFALLS

T:\AQUADWG (ENCANA) & See Title Block ILS

Date and Time Saved: 2013-2-5, 1:34 PM

REFERENCE DRAWINGS	DWG. NO.
-	-
-	-
CAUTION : READ BEFORE EXCAVATION ALL EXCAVATIONS MUST BE CARRIED OUT AS PER "ENCANA'S GROUND DISTURBANCE PRACTICE"	

NO.	DATE (mm-dd-yy)	PROJECT DESCRIPTION	PROJ.	AFE	EPCM Co.	EPCM No.	APPD.
1	2013-02-05	AS-BUILT FLOWBACK SKID/LUBRICATOR PIPING	-	-	PSI	-	-
2	2013-07-31	ADDED 2" BRADEN HEAD AND ASSOCIATED TUBING/PIPE	-	-	PSI	-	-
-	-	-	-	-	-	-	-
-	-	-	-	-	-	-	-
REV. NUMBER	ISSUE	STAGE	DATE (mm-dd-yy)	BY	CHKD.	APPD.
IFR	IFR		2013-07-31	DTF	GJD	-
IFB	IFB		-	-	-	-
IFC	IFC		-	-	-	-
AB	AB		-	-	-	-
-	-		-	-	-	-
-	-		-	-	-	-
PERMIT STAMP	ENGINEER'S STAMP
<div>DRAFT</div>	
PERMIT STAMP AND PROFESSIONAL STAMP AFFIXED ABOVE SHALL APPLY ONLY TO REV(S)	IFR

MAIN FAC.

NORTH PARACHUTE PLATEAU PIPELINE

MAIN LSR.

VARIES

FAC. TYPE

WELLPAD

SITE LSR.

VARIES

SCALE

1/8" = 1'-0"

EPCM Co.

PSI

FILE NO.

NP-WH-TYPLUBE-3300

PIPERLINE STRATEGIES AND INTEGRITY

TITLE


TYPICAL WELLHEAD LUBRICATOR PIPING ELEVATION

AREA

PSI

CLASS

L

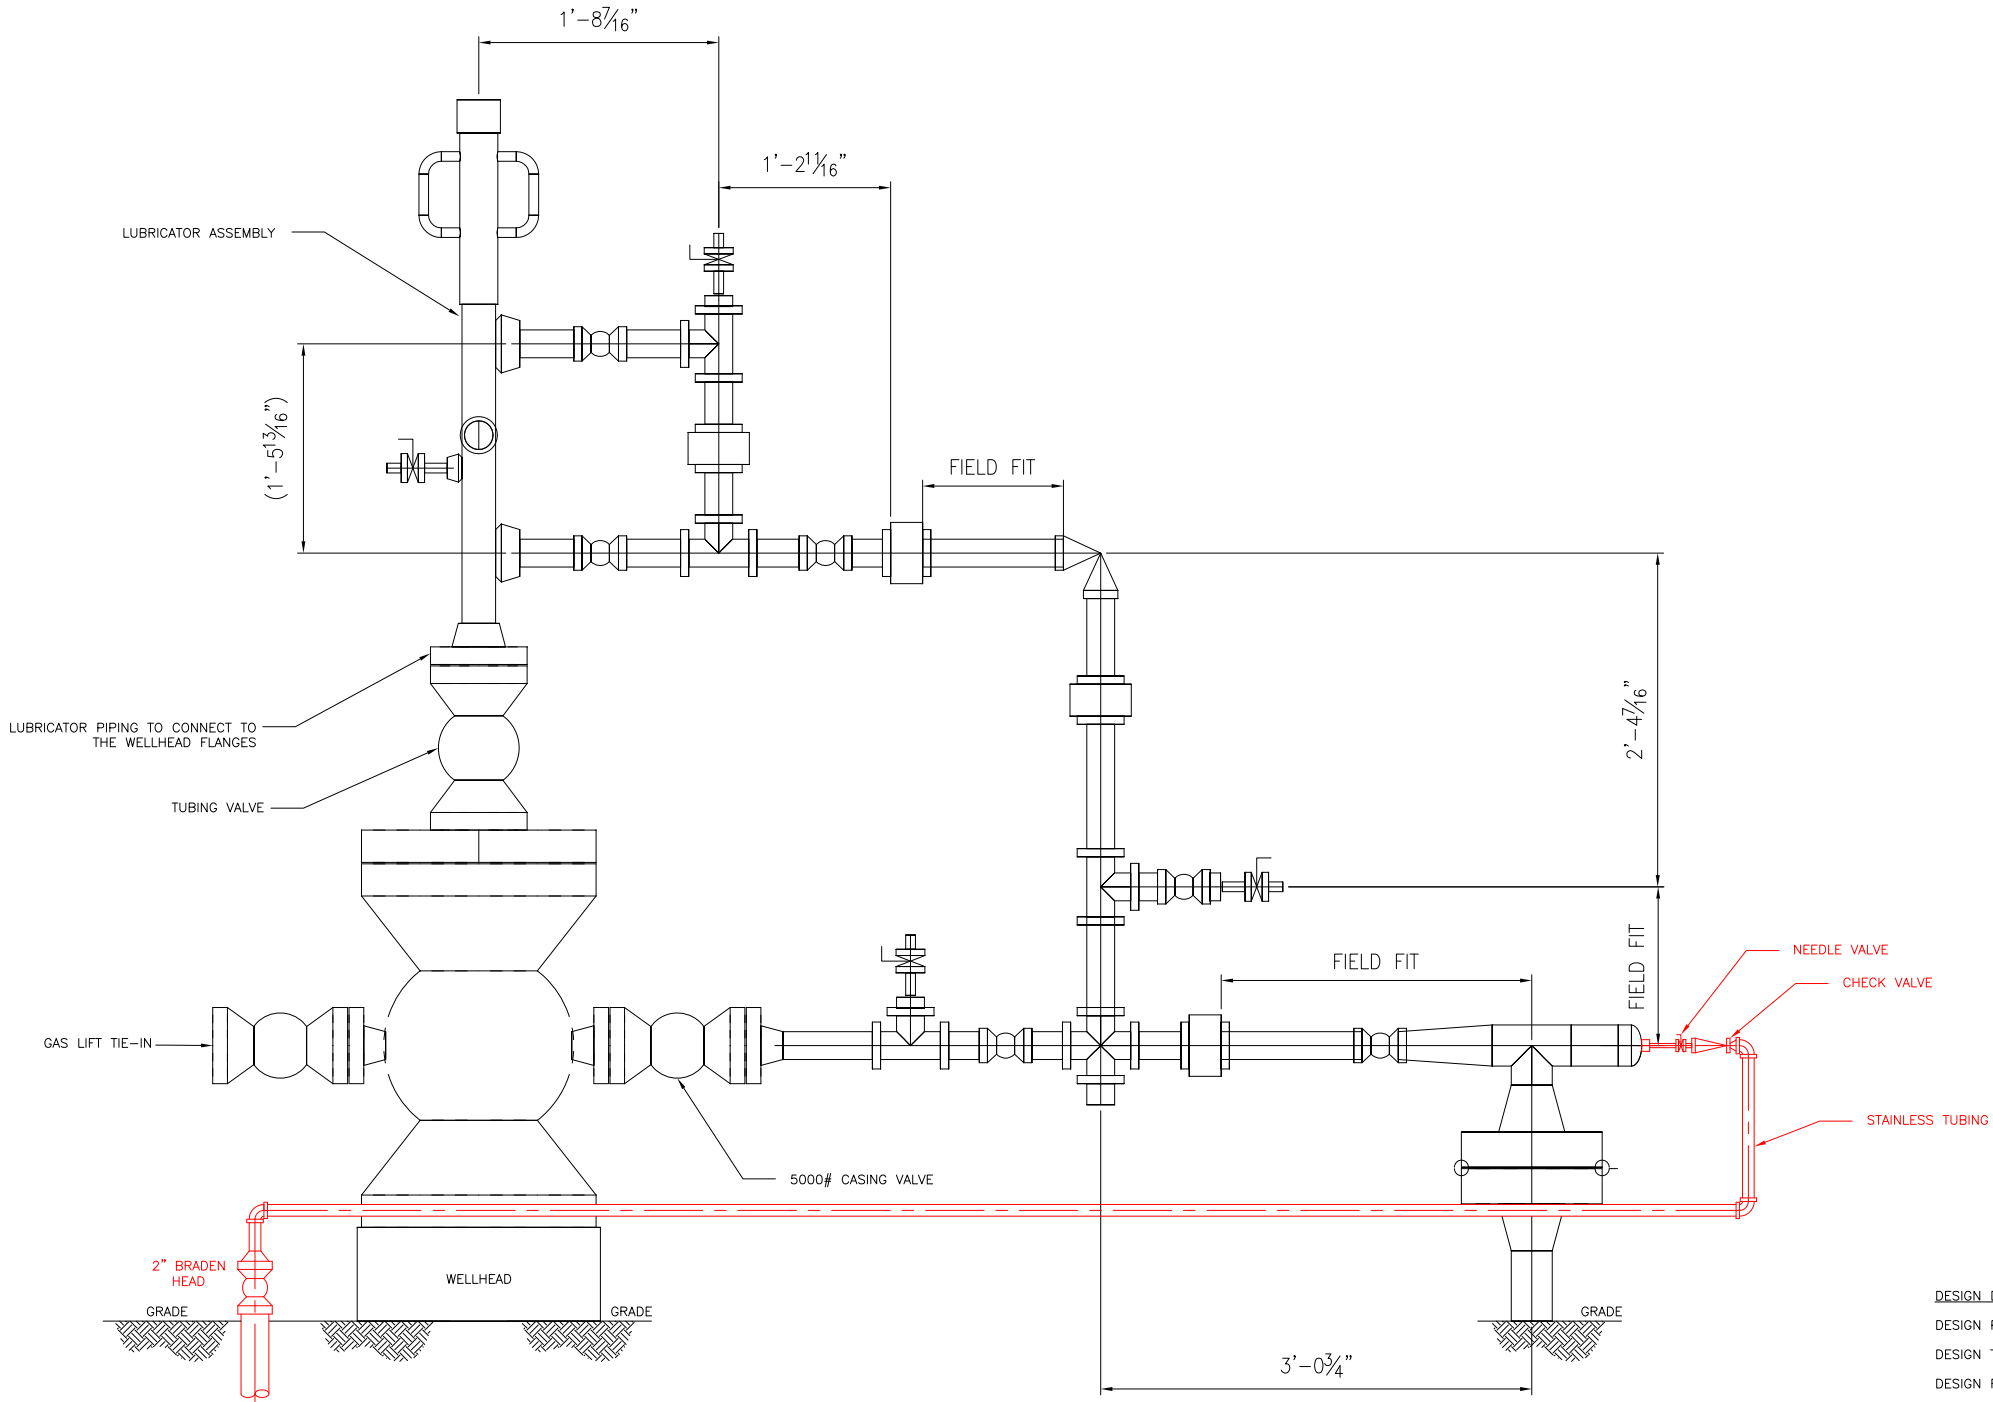

DESIGN DATA:
 DESIGN PRESSURE: 2915 PSIG
 DESIGN TEMP: 200°F
 DESIGN FACTOR: 0.5