

State of Colorado
Oil and Gas Conservation Commission



#8231

FOR OGCC USE ONLY

1120 Lincoln Street, Suite 801, Denver, Colorado 80203 (303)894-2100 Fax:(303)894-2109

SITE INVESTIGATION AND REMEDIATION WORKPLAN

This form shall be submitted to the Director for approval prior to the initiation of site investigation and remediation activities. Form 27 is intended to be used whenever possible. Additional documentation will be required when large volumes of soil and groundwater have been impacted or involve large facilities with multiple source areas. See Rule 910. Attach as many pages as needed to fully describe the proposed work.

OGCC Employee:
 Spill Complaint
 Inspection NOAV
Tracking No: 2147739

CAUSE OF CONDITION BEING INVESTIGATED AND REMEDIATED

Spill or Release Plug & Abandon Central Facility Closure Site/Facility Closure Other (describe): Form 27 update

OGCC Operator Number: <u>100264</u>	Contact Name and Telephone: <u>Jessica Dooling</u>
Name of Operator: <u>XTO Energy Inc.</u>	No: <u>970-675-4122</u>
Address: <u>PO Box 6501</u>	Fax: <u>970-675-4150</u>
City: <u>Englewood</u> State: <u>CO</u> Zip: <u>80155</u>	

API Number: _____	County: <u>Rio Blanco</u>
Facility Name: _____	Facility Number: <u>436190</u>
Well Name: _____	Well Number: _____
Location: (QtrQtr, Sec, Twp, Rng, Meridian): <u>NWSW, Sec. 9, T2S, R97W, 6th P.M.</u>	Latitude: <u>39.899583</u> Longitude: <u>-108.294083</u>

TECHNICAL CONDITIONS

Type of Waste Causing Impact (crude oil, condensate, produced water, etc): Produced Water

Site Conditions: Is location within a sensitive area (according to Rule 901e)? Y N If yes, attach evaluation.

Adjacent land use (cultivated, irrigated, dry land farming, industrial, residential, etc.): Irrigated grazing

Soil type, if not previously identified on Form 2A or Federal Surface Use Plan: Hagga Loam

Potential receptors (water wells within 1/4 mi, surface waters, etc.): No water wells within 1/4 mile, Piceance Creek ~359 feet to the east

Description of Impact (if previously provided, refer to that form or document):

Impacted Media (check):	Extent of Impact:	How Determined:
<input checked="" type="checkbox"/> Soils	<u>Benzene, EC, pH, SAR and Arsenic</u>	<u>laboratory analysis</u>
<input type="checkbox"/> Vegetation	_____	_____
<input type="checkbox"/> Groundwater	_____	_____
<input type="checkbox"/> Surface Water	_____	_____

REMEDIATION WORKPLAN

Describe initial action taken (if previously provided, refer to that form or document):
See Attachment I and II for details regarding background Arsenic and initial action taken.

Describe how source is to be removed:
Impacted soils from the excavation area have been removed and transported offsite to a permitted disposal/recycling facility. Impacted water/groundwater previously collected has been disposed of at permitted XTO injection wells.

Describe how remediation of existing impacts is to be accomplished, including removal and disposal at an injection well or licensed facility, land treatment on site, removal of impacted groundwater, insitu bioremediation, burning of oily vegetation, etc.:
N/A



Tracking Number: _____
Name of Operator: _____
OGCC Operator No: _____
Received Date: _____
Well Name & No: _____
Facility Name & No: _____

Page 2
REMEDIATION WORKPLAN (Cont.)

OGCC Employee: _____

If groundwater has been impacted, describe proposed monitoring plan (# of wells or sample points, sampling schedule, analytical methods, etc.):
The current groundwater bearing zone in and around the excavation area is approximately 7 feet below the ground surface. Initial samples collected of the water ponding in the release area were above Table 910-1 concentration levels for Benzene, Toluene, and Xylenes (See Table 1). Groundwater samples collected from the excavation bottom at ~7 feet were below Table 910-1 concentration levels for Benzene, Toluene, Ethylbenzene and Xylenes. Prior to backfilling the excavation area, additional groundwater samples were collected and indicate Non-detect for BTEX constituents.
Describe reclamation plan. Discuss existing and new grade recontouring; method and testing of compaction alleviation; and reseeding program, including location of new seed, seed mix and noxious weed prevention. Attach diagram or drawing. Use additional sheet for description if required.
Please see Attachment II

Attach samples and analytical results taken to verify remediation of impacts. Show locations of samples on an onsite schematic or drawing.

Is further site investigation required? Y N If yes, describe:
Assessment has been completed and impacts have been identified, removed and transported offsite to a permitted disposal/recycling facility. No further assessment will be necessary (See Figures 1-4).

Final disposition of E&P waste (landtreated and disposed onsite, name of licensed disposal facility, recycling, reuse, etc.):
Impacted soil has been removed and transported offsite to a permitted disposal/recycling facility.
Impacted groundwater has been removed and disposed of at permitted XTO injection wells.

IMPLEMENTATION SCHEDULE

Date Site Investigation Began: 2/4/13 Date Site Investigation Completed: in progress Date Remediation Plan Submitted: 2/19/2013
Remediation Start Date: pending approval Anticipated Completion Date: pending approval Actual Completion Date: 5/2/2013

I hereby certify that the statements made in this form are, to the best of my knowledge, true, correct, and complete.
Print Name: Jessica Dooling Signed: _____
Title: Piceance EH&S Supervisor Date: 2/20/2014

OGCC Approved: Stanley C. Spencer Title: EPS Northwest Region Date: 2/24/2014

ATTACHMENT I

PWDD Workplan, Form 27 Page 1

Background Arsenic:

XTO Energy herein requests consideration of site-specific background Arsenic levels as an alternative to the Table 910-1 value for the PWDD location. COGCC Table 910-1 Concentration Levels list the allowable concentration level for Arsenic in soil at 0.39 mg/kg. Footnote 1 of Table 910-1 states "Consideration shall be given to background levels in native soils and ground water". At other locations COGCC has allowed the determination of allowable levels based upon a 10% variability factor applied to background soil concentration values where the maximum allowable level is computed by multiplying the highest detected background concentration by 1.1.

1. Five representative background samples were collected from undisturbed areas adjacent to the subject location. Arsenic concentrations in those samples ranged from 4.2 mg/kg to 15.9 mg/kg. Applying the 10% variability factor to the highest concentration detected results in an allowable Arsenic concentration level of 17.5 mg/kg.
2. Arsenic samples collected from the excavation bottom and sidewalls range from 4.5 to 5.2 mg/kg. Arsenic samples collected laterally from the release area range from 4.5 to 9.3 mg/kg. These Arsenic concentrations are within the allowable background Arsenic concentration of 17.5 mg/kg.

Please find the Lab Data Summary Tables and the Site Map indicating Arsenic sampling locations attached.

ATTACHMENT II

PWDD Line Release Closure Workplan, Form 27 Pages 1 and 2

Describe initial action taken:

1. Upon discovery of the release, immediate steps were taken to identify the leak and contain potentially impacted soils.
 - Pot-holing of the ROW was initiated to locate the leak.
 - A lined containment area was constructed to temporarily hold the excavated soils from the excavation.
 - Water samples were collected from the water pooled at the surface. These samples were analyzed for Table 910-1 parameters for water. Results exceeded Table 910-1 concentration levels for Benzene (13,000 µg/L), Toluene (21,600 µg/L), and Xylenes (9,390 µg/L).
 - Groundwater samples were collected from the excavation bottom at ~7 ft below ground surface. These samples were analyzed for Table 910-1 parameters for water. Results were below Table 910-1 BTEX concentration levels.
 - Water removed from the pot-hole/excavation area was transported to the XTO Salt Water Disposal (SWD) facility and was injected in permitted XTO injection wells.
 - A cattle panel fence was installed around the release area throughout the project.

2. The 10" Produced Water Disposal and Distribution (PWDD) pipeline was excavated, the leak was identified, the line was isolated and soil samples were collected to determine extent of impacts.
 - Soil samples were collected from the sidewalls of the excavation (north, south, east and west) and analyzed for Table 910-1 parameters. Results exceeded Table 910-1 concentration levels for pH (range: 9.15 to 9.70) and Arsenic (range: 4.5 mg/kg to 5.2 mg/kg).
 - Soil samples were collected from the bottom of the excavation and analyzed for Table 910-1 parameters. Results exceeded Table 910-1 concentration levels for Benzene (0.438 mg/kg), SAR (13.6 mg/kg), pH (9.44) and Arsenic (4.8 mg/kg).
 - Discrete samples that made up the initial composite samples indicate Benzene was impacted in the north half of the excavation.

- Soil was removed in the north half from 2' to 6' beneath the pipe and sampled to ensure Table 910 compliance.
3. The damaged section of pipeline was removed and replaced. Integrity of the pipeline segment was verified with a magnetic linear survey (smart pig). The excavation was backfilled on 5/2/2013 as verbally approved by Chris Canfield, COGCC on 4/19/2013.
- Refer to Tables 1-4 for a summary of the laboratory results and Figures 1 - 4 for the release and sample locations.
 - Elevated Arsenic levels above Table 910-1 concentration were detected in the bottom, sidewall and lateral samples. Please refer to Attachment I requesting consideration of background Arsenic levels (See Table 4).
 - Reclamation activities were completed on 7/1/2013 in accordance with applicable COGCC 900, 1000 Series rules and as specified in the Surface Use Plan and BLM Conditions of Approval for the Phase I pipeline ROW.

Table 1
Location: PWDD 10" Spill
Lab Summary - Background Data

Last update

2/20/2014

Analytical Parameter (with units)	Love Ranch 8 Background					COGCC <i>Table 910-1</i> Concentration Levels	Maximum based on Background
	BG - 1	BG - 2	BG - 3	BG - 4	BG - 5		
Accutest Job #	D20760 (1/27/11)					-	-
Sample type (Composite/Discrete)	D	D	D	D	D	-	-
TPH (GRO) (mg/Kg)	-	-	-	-	-	-	-
TPH (DRO) (mg/Kg)	-	-	-	-	-	-	-
TPH (GRO + DRO) (mg/Kg)	-	-	-	-	-	500	-
Benzene (mg/Kg)	-	-	-	-	-	0.170	-
Toluene (mg/Kg)	-	-	-	-	-	85	-
Ethylbenzene (mg/Kg)	-	-	-	-	-	100	-
Xylenes (total) (mg/Kg)	-	-	-	-	-	175	-
Acenaphthene (mg/Kg)	-	-	-	-	-	1000	-
Anthracene (mg/Kg)	-	-	-	-	-	1000	-
Benzo(A)anthracene (mg/Kg)	-	-	-	-	-	0.22	-
Benzo(A)pyrene (mg/Kg)	-	-	-	-	-	0.022	-
Benzo(B)fluoranthene (mg/Kg)	-	-	-	-	-	0.22	-
Benzo(K)fluoranthene (mg/Kg)	-	-	-	-	-	2.2	-
Chrysene (mg/Kg)	-	-	-	-	-	22	-
Dibenzo(A,H)anthracene (mg/Kg)	-	-	-	-	-	0.022	-
Fluoranthene (mg/Kg)	-	-	-	-	-	1000	-
Fluorene (mg/Kg)	-	-	-	-	-	1000	-
Indeno(1,2,3,C,D)pyrene (mg/Kg)	-	-	-	-	-	0.22	-
Naphthalene (mg/Kg)	-	-	-	-	-	23	-
Pyrene (mg/Kg)	-	-	-	-	-	1000	-
Electrical Conductivity (mmhos/cm)	-	-	-	-	-	<4 or 2x BG	-
Sodium Adsorption Ratio (SAR)	-	-	-	-	-	12	-
pH	-	-	-	-	-	6-9	-
Arsenic (mg/kg)	13.5	15.9	9.8	5.5	4.2	0.39	17.5
Barium (mg/kg)	-	-	-	-	-	15000	-
Cadmium (mg/kg)	-	-	-	-	-	70	-
Chromium (III) (mg/Kg)	-	-	-	-	-	120000	-
Chromium (VI) (mg/Kg)	-	-	-	-	-	23	-
Copper (mg/kg)	-	-	-	-	-	3100	-
Lead (inorganic) (mg/kg)	-	-	-	-	-	400	-
Mercury (mg/kg)	-	-	-	-	-	23	-
Nickel (mg/kg)	-	-	-	-	-	1600	-
Selenium (mg/kg)	-	-	-	-	-	390	-
Silver (mg/kg)	-	-	-	-	-	390	-
Zinc (mg/kg)	-	-	-	-	-	23000	-

Notes:

- 1) ND = not detectible to the laboratory detection limit.
- 2) Results highlighted in yellow exceed Table 910-1 concentration levels. Results highlighted in Gray exceed Table 910-1 concentration levels.
- 3) "-" indicates no analysis.
- 4) See Figure(s) for sample locations.

Table 2
Location: PWDD 10" Line Release
Lab Summary - Water Sampling Assessment

Last update

2/20/2014

Analytical Parameter (with units)	PWDD Water Samples			COGCC
	<i>PWDD Water Surface 2/4/13</i>	<i>PWDD Water at 7' Excavation 2/4/13</i>	<i>PWDD Composite Groundwater 4/3/13</i>	<i>Table 910-1 Concentration Levels</i>
Accutest Job #	D43109	D43110	D45050	-
Sample type	Grab	Grab	Composite	-
Benzene (µg/l)	13000	0.30	ND	5
Toluene (µg/l)	21600	ND	ND	560 to 1000
Ethylbenzene (µg/l)	573	ND	ND	700
Xylenes (total) (µg/l)	9390	ND	ND	1400 to 10000
Total Dissolved Solids (mg/l)	10900	1540	1580	<1.25 BG
Chloride (mg/l)	5200	23.4	26.3	<1.25 BG
Sulfate (mg/l)	71.8	641	612	<1.25 BG
Bromide (mg/l)	38.9	<0.50	-	N/A
Fluoride (mg/l)	<2.0	1.2	-	N/A
Nitrogen, Nitrate (mg/l)	<0.20	<0.050	-	N/A
Nitrogen, Nitrite (mg/l)	<0.080	<0.020	-	N/A
Phosphate, Ortho (mg/l)	<1.3	<0.33	-	N/A
Calcium (mg/l)	77.200	90.900	-	N/A
Magnesium (mg/l)	56.900	152.000	-	N/A
Potassium (mg/l)	32.400	1.620	-	N/A
Sodium (mg/l)	3310.0000	226.000	-	N/A

Notes:

- 1) ND = not detectible to the laboratory detection limit noted.
- 2) Results highlighted in yellow exceed Table 910-1 concentration levels.
- 3) "-" indicates no analysis.

Table 3
Location: PWDD 10" Spill
Lab Summary - Excavation Samples

Last update 2/20/2014

Analytical Parameter (with units)	PWDD Excavation Samples													COGCC Table 910-1 Concentration Levels	Maximum based on Background	
	North Sidewall	South Sidewall	East Sidewall	West Sidewall	Excavation Bottom				Post 2' Ex.		Post 6' Ex.		Stockpile			
	Composite 2/7/13	Composite 2/7/13	Composite 2/7/13	Composite 2/7/13	Composite 2/7/13	#1	#2	#3	#4	Bottom #3 (-2')	Bottom #4 (-2')	Bottom #4 Pipe -6'	Bottom #4 North - 6'			Stockpile 2/8/13
Accutest Job #	D43341	D43339	D43342	D43340	D43343	D43348 (2/7/13)				D44517 (3/19/13)		D44827 (3/28/13)		D43395	-	-
Sample type (Composite/Discrete)	C	C	C	C	C	D	D	D	D	D	D	D	D	C	-	-
TPH (GRO) (mg/Kg)	ND	ND	ND	ND	ND	-	-	-	-	-	-	-	-	ND	-	-
TPH (DRO) (mg/Kg)	5.65	ND	ND	ND	5.53	-	-	-	-	-	-	-	-	19.3	-	-
TPH (GRO + DRO) (mg/Kg)	5.65	ND	ND	ND	5.53	-	-	-	-	-	-	-	-	19.3	500	-
Benzene (mg/Kg)	0.0457	ND	ND	ND	0.438	ND	ND	1.56	0.501	0.0803	1.10	ND	ND	ND	0.170	-
Toluene (mg/Kg)	0.392	ND	ND	ND	1.44	-	-	-	-	-	-	-	-	0.115	85	-
Ethylbenzene (mg/Kg)	0.0430	ND	ND	ND	0.0899	-	-	-	-	-	-	-	-	ND	100	-
Xylenes (total) (mg/Kg)	0.433	ND	ND	ND	1.57	-	-	-	-	-	-	-	-	ND	175	-
Acenaphthene (mg/Kg)	ND	ND	ND	ND	ND	-	-	-	-	-	-	-	-	ND	1000	-
Anthracene (mg/Kg)	ND	ND	ND	ND	ND	-	-	-	-	-	-	-	-	ND	1000	-
Benzo(A)anthracene (mg/Kg)	ND	ND	ND	ND	ND	-	-	-	-	-	-	-	-	ND	0.22	-
Benzo(A)pyrene (mg/Kg)	ND	ND	ND	ND	ND	-	-	-	-	-	-	-	-	ND	0.022	-
Benzo(B)fluoranthene (mg/Kg)	ND	ND	ND	ND	ND	-	-	-	-	-	-	-	-	ND	0.22	-
Benzo(K)fluoranthene (mg/Kg)	ND	ND	ND	ND	ND	-	-	-	-	-	-	-	-	ND	2.2	-
Chrysene (mg/Kg)	ND	ND	ND	ND	ND	-	-	-	-	-	-	-	-	ND	22	-
Dibenzo(A,H)anthracene (mg/Kg)	ND	ND	ND	ND	ND	-	-	-	-	-	-	-	-	ND	0.022	-
Fluoranthene (mg/Kg)	ND	ND	ND	ND	ND	-	-	-	-	-	-	-	-	ND	1000	-
Fluorene (mg/Kg)	ND	ND	ND	ND	ND	-	-	-	-	-	-	-	-	0.0091	1000	-
Indeno(1,2,3,C,D)pyrene (mg/Kg)	ND	ND	ND	ND	ND	-	-	-	-	-	-	-	-	ND	0.22	-
Naphthalene (mg/Kg)	ND	ND	ND	ND	0.0163	-	-	-	-	-	-	-	-	0.115	23	-
Pyrene (mg/Kg)	ND	ND	ND	ND	ND	-	-	-	-	-	-	-	-	ND	1000	-
Electrical Conductivity (mmhos/cm)	2.900	1.060	2.040	1.460	2.870	1.480	0.548	1.400	3.620	-	-	-	-	2.330	<4 or 2x BG	-
Sodium Adsorption Ratio (SAR)	10.6	5.31	7.60	6.10	13.6	4.95	2.25	13.7	34.1	-	-	-	-	10.7	12	-
pH	9.15	9.34	9.21	9.70	9.44	9.10	8.79	9.31	8.93	-	-	-	-	9.30	6-9	-
Arsenic (mg/kg)	4.5	5.2	5.2	4.8	4.8	-	-	-	-	-	-	-	-	2.9	0.39	17.5
Barium (mg/kg)	254	245	258	297	231	-	-	-	-	-	-	-	-	251	15000	-
Cadmium (mg/kg)	<1.3	<1.3	<1.3	<1.2	<1.3	-	-	-	-	-	-	-	-	<1.3	70	-
Chromium (III) (mg/Kg)	30.4	28.2	32.1	32.7	30.5	-	-	-	-	-	-	-	-	28.5	120000	-
Chromium (VI) (mg/Kg)	<1.0	<1.0	<1.0	<1.0	<1.0	-	-	-	-	-	-	-	-	<1.0	23	-
Copper (mg/kg)	12.0	11.0	12.6	11.4	12.7	-	-	-	-	-	-	-	-	12.1	3100	-
Lead (inorganic) (mg/kg)	12.2	11.4	12.6	12.6	12.1	-	-	-	-	-	-	-	-	12.4	400	-
Mercury (mg/kg)	<0.11	<0.12	<0.094	<0.11	<0.097	-	-	-	-	-	-	-	-	<0.11	23	-
Nickel (mg/kg)	15.1	14.4	15.8	15.8	15.2	-	-	-	-	-	-	-	-	15.2	1600	-
Selenium (mg/kg)	<6.3	<6.3	<6.4	<6.1	<6.6	-	-	-	-	-	-	-	-	<6.4	390	-
Silver (mg/kg)	<3.8	<3.8	<3.8	<3.7	<4.0	-	-	-	-	-	-	-	-	<3.8	390	-
Zinc (mg/kg)	46.1	40.3	45.5	45.7	47.4	-	-	-	-	-	-	-	-	45.5	23000	-
% Solids	78.6	77.6	77.0	79.5	74.0	77.5	71.3	72.0	76.4	68.5	70.4	72.5	69.8	76.7	-	-

Notes:

- 1) ND = not detectible to the laboratory detection limit.
- 2) Results highlighted in yellow exceed Table 910-1 concentration levels. Results highlighted in Gray exceed Table 910-1, but are below background levels.
- 3) "-" indicates no analysis.
- 4) See Figure(s) for sample locations.
- 5) See Table 4 for determination of background levels.

Table 4
Location: PWDD 10" Spill
Lab Summary - Lateral Assessment


Last update 2/20/2014

Analytical Parameter (with units)	PWDD Lateral Surface Samples																		COGCC Table 910-1 Concentration Levels	Maximum based on Background
	Northeast				North Center				Northwest				Southeast		South Center		Southwest			
	#1	#2	#3	#4	#1	#2	#3	#4	#1	#2	#3	#4	#1	#2	#1	#2	#1	#2		
Accutest Job #	D43399 (2/8/13)				D43396 (2/8/13)				D43398 (2/8/13)				D43397 (2/8/13)				-	-		
Sample type (Composite/Discrete)	C	C	C	C	C	C	C	C	C	C	C	C	C	C	C	C	C	C	-	-
TPH (GRO) (mg/Kg)	ND	ND	ND	ND	ND	ND	ND	ND	ND	ND	ND	ND	ND	ND	ND	ND	ND	ND	-	-
TPH (DRO) (mg/Kg)	8.11	ND	12.1	7.21	ND	ND	ND	ND	ND	8.56	5.66	ND	14.5	9.00	7.89	ND	5.59	13.5	-	-
TPH (GRO + DRO) (mg/Kg)	8.11	ND	12.1	7.21	ND	ND	ND	ND	ND	8.56	5.66	ND	14.5	9.00	7.89	ND	5.59	13.5	500	-
Benzene (mg/Kg)	ND	ND	ND	ND	0.042	ND	ND	ND	ND	ND	ND	ND	ND	ND	ND	ND	ND	ND	0.170	-
Toluene (mg/Kg)	ND	ND	ND	ND	0.146	ND	ND	0.0923	ND	ND	ND	ND	ND	ND	ND	ND	ND	ND	85	-
Ethylbenzene (mg/Kg)	ND	ND	ND	ND	ND	ND	ND	ND	ND	ND	ND	ND	ND	ND	ND	ND	ND	ND	100	-
Xylenes (total) (mg/Kg)	ND	ND	ND	ND	ND	ND	ND	ND	ND	ND	ND	ND	ND	ND	ND	ND	ND	ND	175	-
Acenaphthene (mg/Kg)	ND	ND	ND	ND	ND	ND	ND	ND	ND	ND	ND	ND	ND	ND	ND	ND	ND	ND	1000	-
Anthracene (mg/Kg)	ND	ND	ND	ND	ND	ND	ND	ND	ND	ND	ND	ND	ND	ND	ND	ND	ND	ND	1000	-
Benzo(A)anthracene (mg/Kg)	ND	ND	ND	ND	ND	ND	ND	ND	ND	ND	ND	ND	ND	ND	ND	ND	ND	ND	0.22	-
Benzo(A)pyrene (mg/Kg)	ND	ND	ND	ND	ND	ND	ND	ND	ND	ND	ND	ND	ND	ND	ND	ND	ND	ND	0.022	-
Benzo(B)fluoranthene (mg/Kg)	ND	ND	ND	ND	ND	ND	ND	ND	ND	ND	ND	ND	ND	ND	ND	ND	ND	ND	0.22	-
Benzo(K)fluoranthene (mg/Kg)	ND	ND	ND	ND	ND	ND	ND	ND	ND	ND	ND	ND	ND	ND	ND	ND	ND	ND	2.2	-
Chrysene (mg/Kg)	ND	ND	ND	ND	ND	ND	ND	ND	ND	ND	ND	ND	ND	ND	ND	ND	ND	ND	22	-
Dibenzo(A,H)anthracene (mg/Kg)	ND	ND	ND	ND	ND	ND	ND	ND	ND	ND	ND	ND	ND	ND	ND	ND	ND	ND	0.022	-
Fluoranthene (mg/Kg)	ND	ND	ND	ND	ND	ND	ND	ND	ND	ND	ND	ND	ND	ND	ND	ND	ND	ND	1000	-
Fluorene (mg/Kg)	ND	ND	ND	ND	ND	ND	ND	ND	ND	ND	ND	ND	ND	ND	ND	ND	ND	ND	1000	-
Indeno(1,2,3,C,D)pyrene (mg/Kg)	ND	ND	ND	ND	ND	ND	ND	ND	ND	ND	ND	ND	ND	ND	ND	ND	ND	ND	0.22	-
Naphthalene (mg/Kg)	ND	ND	ND	ND	ND	ND	ND	ND	ND	ND	ND	ND	ND	ND	ND	ND	ND	ND	23	-
Pyrene (mg/Kg)	ND	ND	ND	ND	ND	ND	ND	ND	ND	ND	ND	ND	ND	ND	ND	ND	ND	ND	1000	-
Electrical Conductivity (mmhos/cm)	3.720	3.430	5.470	2.130	3.190	2.830	3.240	2.830	3.540	3.430	5.320	2.140	2.360	7.740	2.170	4.610	4.200	4.290	<4 or 2x BG	-
Sodium Adsorption Ratio (SAR)	19.5	17.6	11.4	9.06	13.8	11.3	13.9	14.4	9.66	5.39	6.44	4.59	11.4	15.7	11.9	12.0	13.1	14.3	12	-
pH	9.72	9.65	9.21	9.30	9.35	9.11	8.90	9.16	9.13	8.83	8.95	9.17	9.22	9.09	9.73	9.12	8.94	9.34	6-9	-
Arsenic (mg/kg)	5.6	7.6	5.5	5.1	8.0	7.4	8.0	7.8	8.8	9.3	7.4	8.3	4.5	7.0	5.0	7.8	5.2	5.7	0.39	17.49
Barium (mg/kg)	345	215	321	326	188	195	262	253	226	193	174	206	293	258	281	220	309	338	15000	-
Cadmium (mg/kg)	<1.2	<1.4	<1.2	<1.4	<1.2	<1.2	<1.1	<1.3	<1.3	<1.3	<1.2	<1.3	<1.3	<1.3	<1.2	<1.2	<1.2	<1.3	70	-
Chromium (III) (mg/Kg)	34.7	17.2	34.1	33.9	13.7	14.5	15.9	21.5	18.1	16.5	14.3	14.4	31.3	34.3	30.7	19.6	34.0	33.9	120000	-
Chromium (VI) (mg/Kg)	<1.0	<1.0	<1.0	<1.0	<1.0	<1.0	<1.0	<1.0	<1.0	<1.0	<1.0	<1.0	<1.0	<1.0	<1.0	<1.0	<1.0	<1.0	23	-
Copper (mg/kg)	15.4	13.3	14.5	15.6	12.7	13.4	14.6	13.8	13.8	15.4	12.5	13.5	15.5	11.9	12.6	13.5	14.3	14.3	3100	-
Lead (inorganic) (mg/kg)	13.8	10.4	13.6	12.4	10	10.3	10.8	11.7	11.3	12.2	8.4	10.7	12.5	12.9	12.4	10.3	13.7	13.7	400	-
Mercury (mg/kg)	<0.10	<0.12	<0.11	<0.12	<0.10	<0.10	<0.10	<0.11	<0.11	<0.11	<0.097	<0.11	<0.11	<0.11	<0.10	<0.11	<0.12	<0.11	23	-
Nickel (mg/kg)	18.0	16.8	17.2	15.8	16.7	17.4	18.3	17.1	16.6	19.4	19.5	17.6	16.5	17.1	17.1	20.4	21.1	17.8	1600	-
Selenium (mg/kg)	<5.9	<7.1	<6.1	<6.9	<6.0	<5.9	<5.7	<6.3	<6.3	<6.4	<5.9	<6.5	<6.7	<6.3	<6.1	<5.9	<6.2	<6.5	390	-
Silver (mg/kg)	<3.6	<4.3	<3.6	<4.1	<3.6	<3.5	<3.4	<3.8	<3.8	<3.8	<3.5	<3.9	<4.0	<3.8	<3.6	<3.5	<3.7	<3.9	390	-
Zinc (mg/kg)	55.1	42.8	52.5	48.5	39.8	43.4	46.4	45.4	44.9	61.5	39.3	45.4	53.3	49.7	46.2	43.8	48.7	48.9	23000	-
% Solids	78.2	69.5	76.2	68.2	80.8	80.7	79.8	74.1	77.9	72.0	82.1	76.4	76.8	78.8	80.7	76.6	72.2	72.2	-	-

Notes:

- 1) ND = not detectible to the laboratory detection limit.
- 2) Results highlighted in yellow exceed Table 910-1 concentration levels. Results highlighted in Gray exceed Table 910-1, but are below background levels.
- 3) "-" indicates no analysis.
- 4) See Figure(s) for sample locations.
- 5) See Table 4 for determination of background levels.

\\hyper-v03\lkw-d-co\sask\proj\cto environmental\1302-03_pwwd_spill\vicinity.dwg.2/20/14

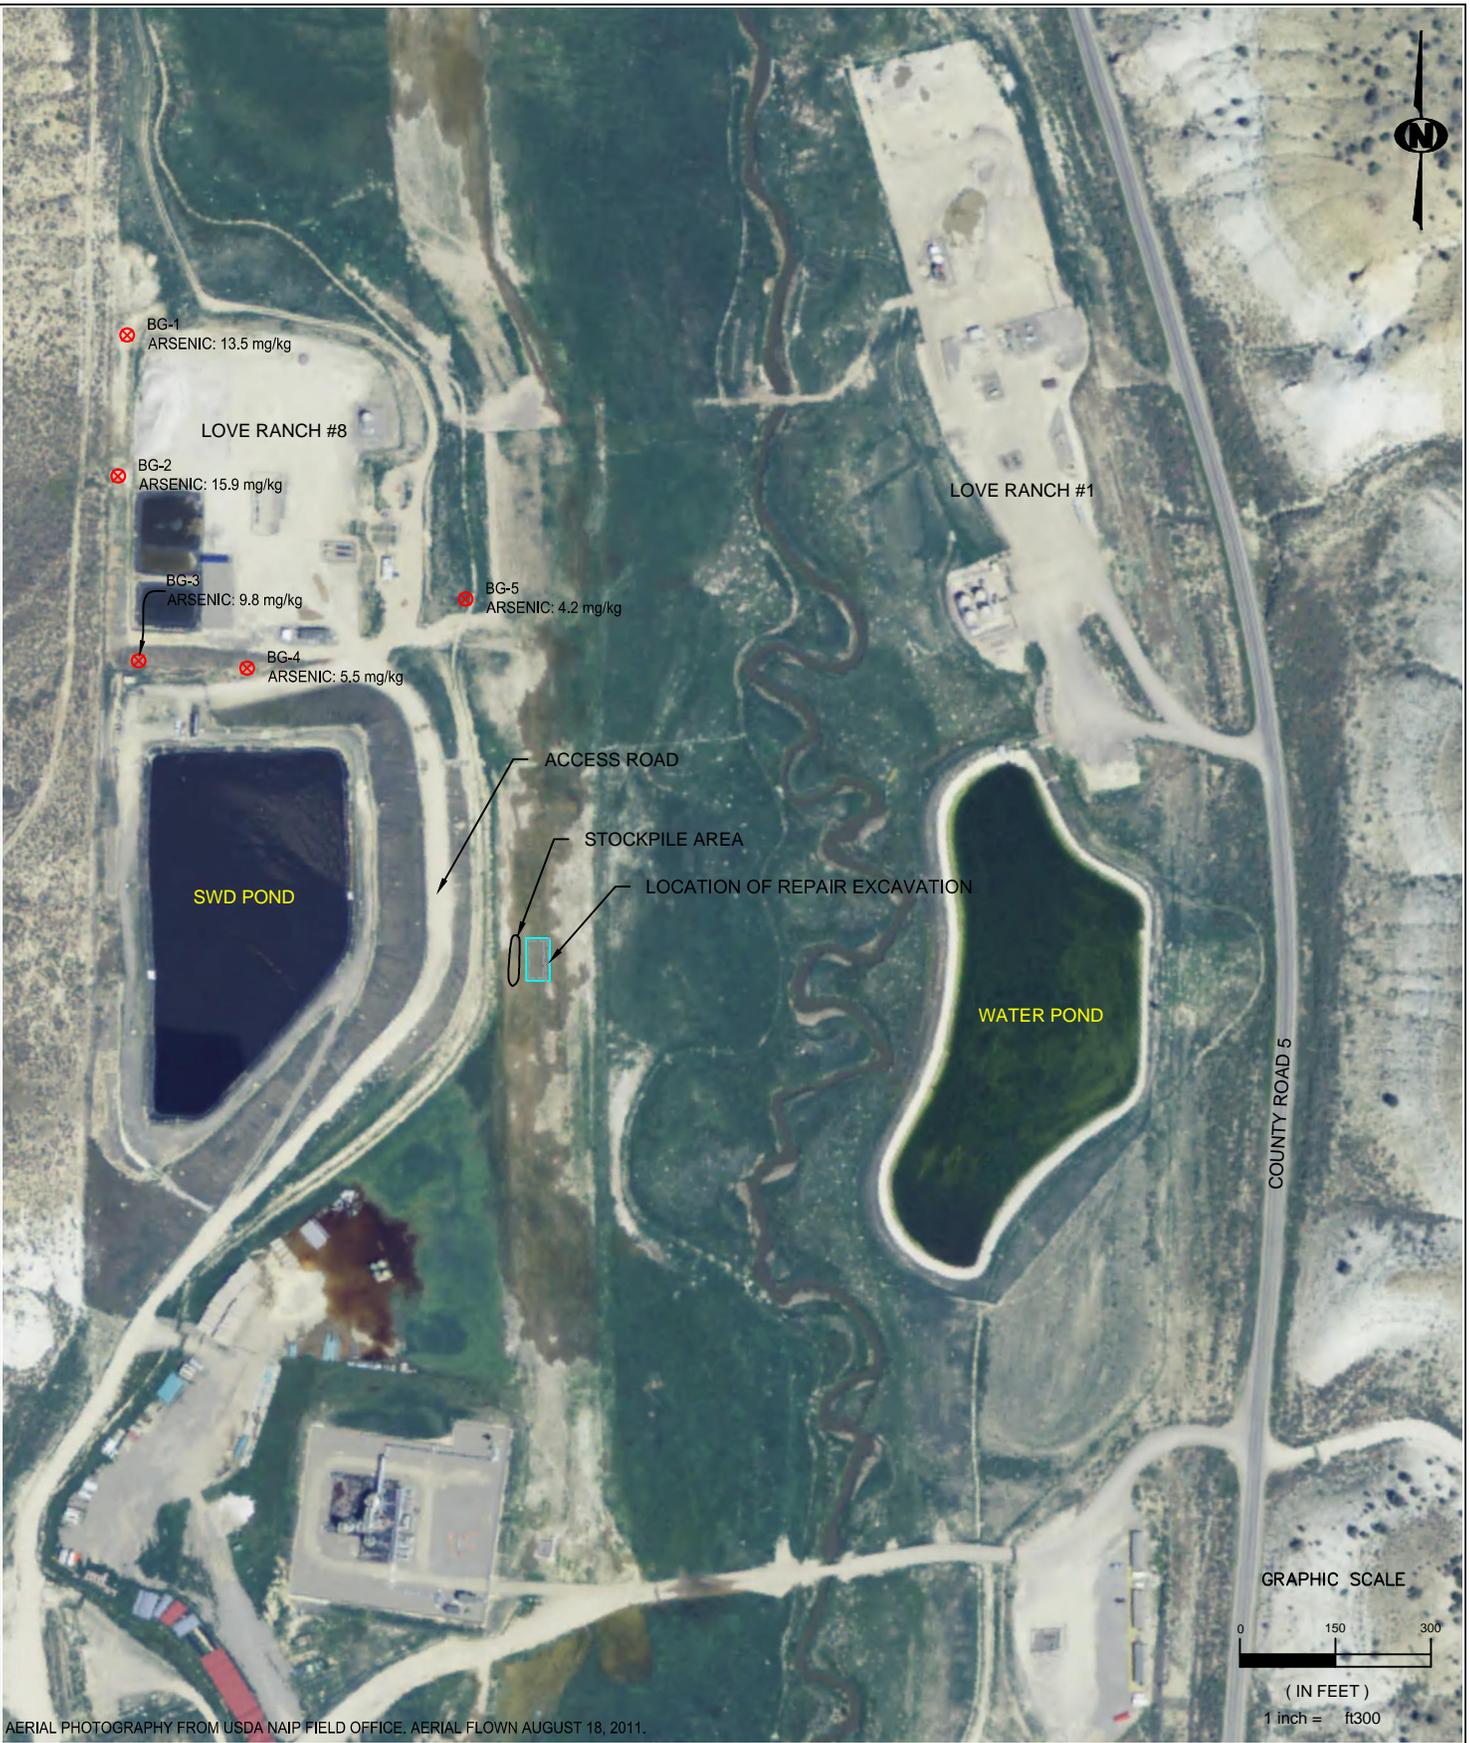

AERIAL PHOTOGRAPHY FROM USDA NAIP FIELD OFFICE, AERIAL FLOWN AUGUST 18, 2011.

GPS:	CHECKED:	FIGURE	DATE	REVISIONS
DS	DK	1		
DATE:	DRAWN:			
2/20/14	DRF			
FILE NAME:	SHEET NO.			
vicinity	1 of 4			
PROJECT NO.	SCALE:			
1302-03	1" = 300'			

KRW CONSULTING, INC.
 8000 W. 14TH AVENUE, SUITE 200
 LAKEWOOD, COLORADO
 (303) 239-9011


FIGURE 1
PICEANCE CREEK
PWDD RELEASE
VICINITY MAP

PREPARED FOR XTO ENERGY

\\hyper-v03\kwd-co\sdk\proj\cto_environmental\1302-03_pwwd_spill\sample.dwg,2/20/14




GRAPHIC SCALE

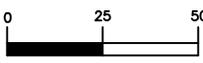

(IN FEET)
1 inch = 50ft

LEGEND	
	10" PIPE INSIDE WALL
	AREA OF 10" PIPE DAMAGE
	STOCKPILE AREA
	REPAIR EXCAVATION TOP
	REPAIR EXCAVATION TOE (APPROX.)
	CATTLE PANEL FENCE (APPROX.)
	NORTHEAST 1 SAMPLE LOCATION

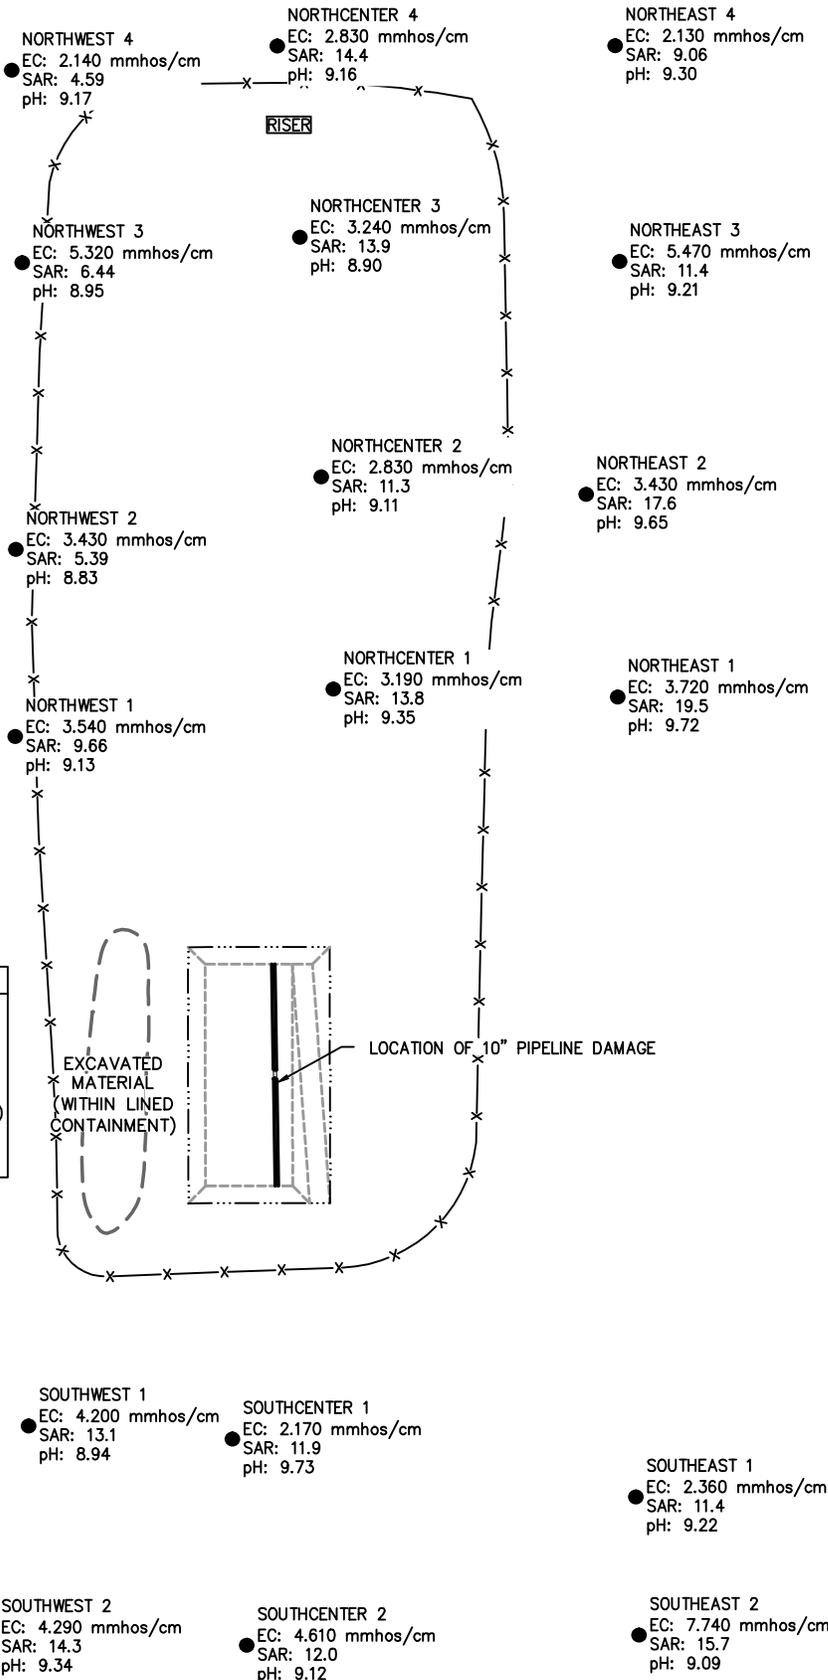

GPS: DS	CHECKED: DK	FIGURE 2	DATE	REVISIONS
DATE: 2/20/14	DRAWN: DRF			
FILE NAME: sample	SHEET NO. 2 of 4			
PROJECT NO. 1302-03	SCALE: 1" = 50'			

KRW CONSULTING, INC.
8000 W. 14TH AVENUE, SUITE 200
LAKEWOOD, COLORADO
(303) 239-9011


FIGURE 2
PICEANCE CREEK
PWDD RELEASE
SAMPLE LOCATIONS

PREPARED FOR XTO ENERGY

\\hyper-v03\lkw-d-co\sask\proj\xt0 environmental\1302-03_pwwd_spill\sample.dwg,2/20/14

LEGEND

- 3in — 3in — 3" PIPE CENTERLINE
- 4in — 4in — 4" PIPE CENTERLINE
- 10in — 10in — 10" PIPE CENTERLINE
- STOCKPILE AREA
- - - - - REPAIR EXCAVATION TOP
- - - - - REPAIR EXCAVATION TOE
- ▬▬▬▬▬ 10" PIPE INSIDE WALL
- ▬▬▬▬▬ AREA OF 10" PIPE DAMAGE
- INDICATES BENZENE LEVELS ABOVE 0.170 mg/kg
- COMPOSITE SAMPLE LOCATION
- DISCRETE SAMPLE LOCATION

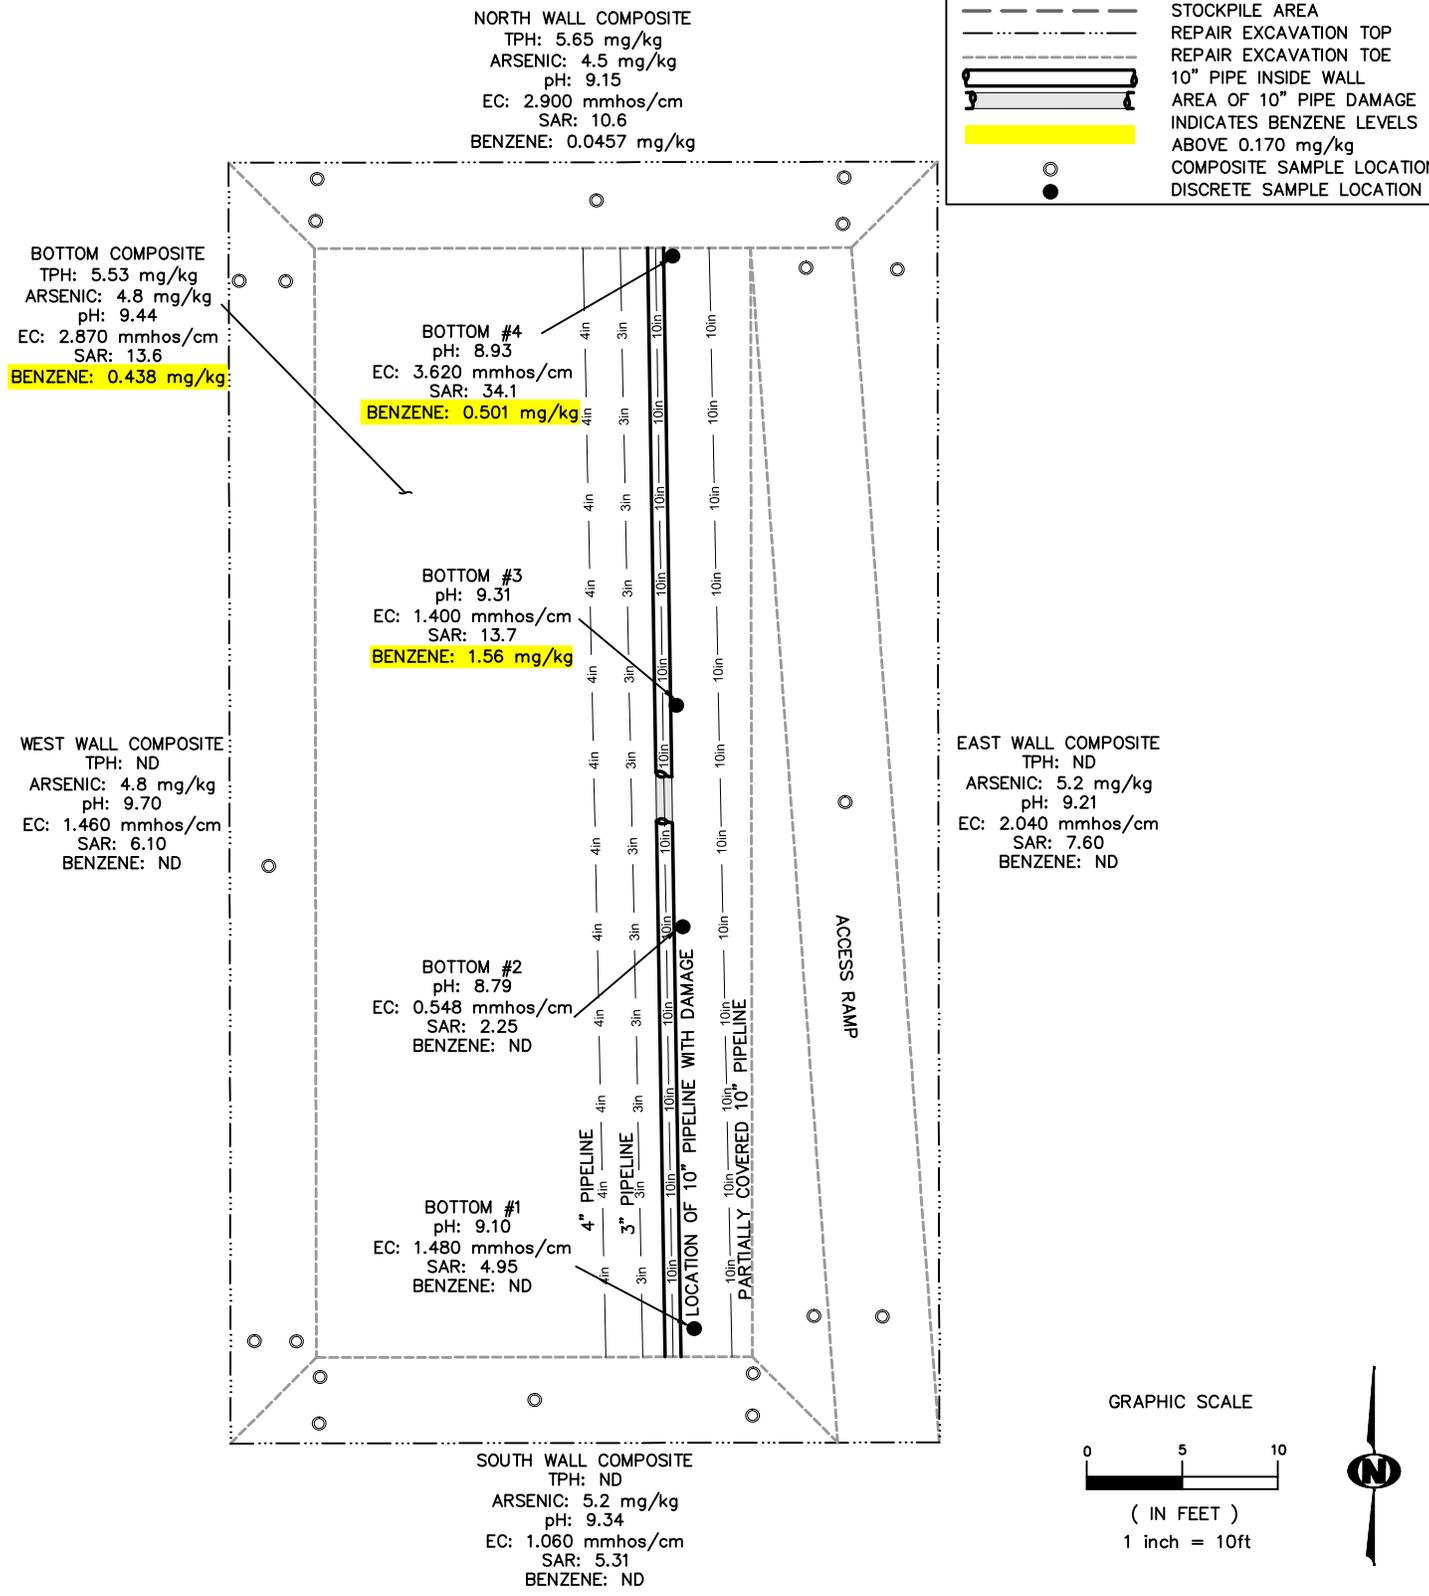

GRAPHIC SCALE

0 5 10

(IN FEET)
 1 inch = 10ft

GPS: DS	CHECKED: DK	FIGURE 3	DATE	REVISIONS
DATE: 2/20/14	DRAWN: DRF			
FILE NAME: sample	SHEET NO. 3 of 4			
PROJECT NO. 1302-03	SCALE: 1" = 10'			

KRW CONSULTING, INC.
 8000 W. 14TH AVENUE, SUITE 200
 LAKEWOOD, COLORADO
 (303) 239-9011

FIGURE 3
 PICEANCE CREEK
 PWDD RELEASE
 COLLECTED SAMPLE LOCATIONS
 WITH SELECT RESULTS
 PREPARED FOR XTO ENERGY

\\hyper-v03\lkwd-co\sdk\proj\cto environmental\1302-03_pwwd spill\sample cl.dwg,2/20/14

NORTH WALL COMPOSITE
 TPH: 5.65 mg/kg
 ARSENIC: 4.5 mg/kg
 pH: 9.15
 EC: 2.900 mmhos/cm
 SAR: 10.6
 BENZENE: 0.0457 mg/kg

NORTH
 BENZENE (-6'): ND

BOTTOM #4 (BELOW PIPE)
 pH: 8.93
 EC: 3.620 mmhos/cm
 SAR: 34.1
 BENZENE: 0.501 mg/kg
 BENZENE (-2'): 1.10 mg/kg
 BENZENE (-6'): ND

BOTTOM #3
 pH: 9.31
 EC: 1.400 mmhos/cm
 SAR: 13.7
 BENZENE: 1.56 mg/kg
 BENZENE (-2'): 0.0803 mg/kg


WEST WALL COMPOSITE:
 TPH: ND
 ARSENIC: 4.8 mg/kg
 pH: 9.70
 EC: 1.460 mmhos/cm
 SAR: 6.10
 BENZENE: ND

EAST WALL COMPOSITE
 TPH: ND
 ARSENIC: 5.2 mg/kg
 pH: 9.21
 EC: 2.040 mmhos/cm
 SAR: 7.60
 BENZENE: ND

BOTTOM #2
 pH: 8.79
 EC: 0.548 mmhos/cm
 SAR: 2.25
 BENZENE: ND


BOTTOM #1
 pH: 9.10
 EC: 1.480 mmhos/cm
 SAR: 4.95
 BENZENE: ND

SOUTH WALL COMPOSITE
 TPH: ND
 ARSENIC: 5.2 mg/kg
 pH: 9.34
 EC: 1.060 mmhos/cm
 SAR: 5.31
 BENZENE: ND

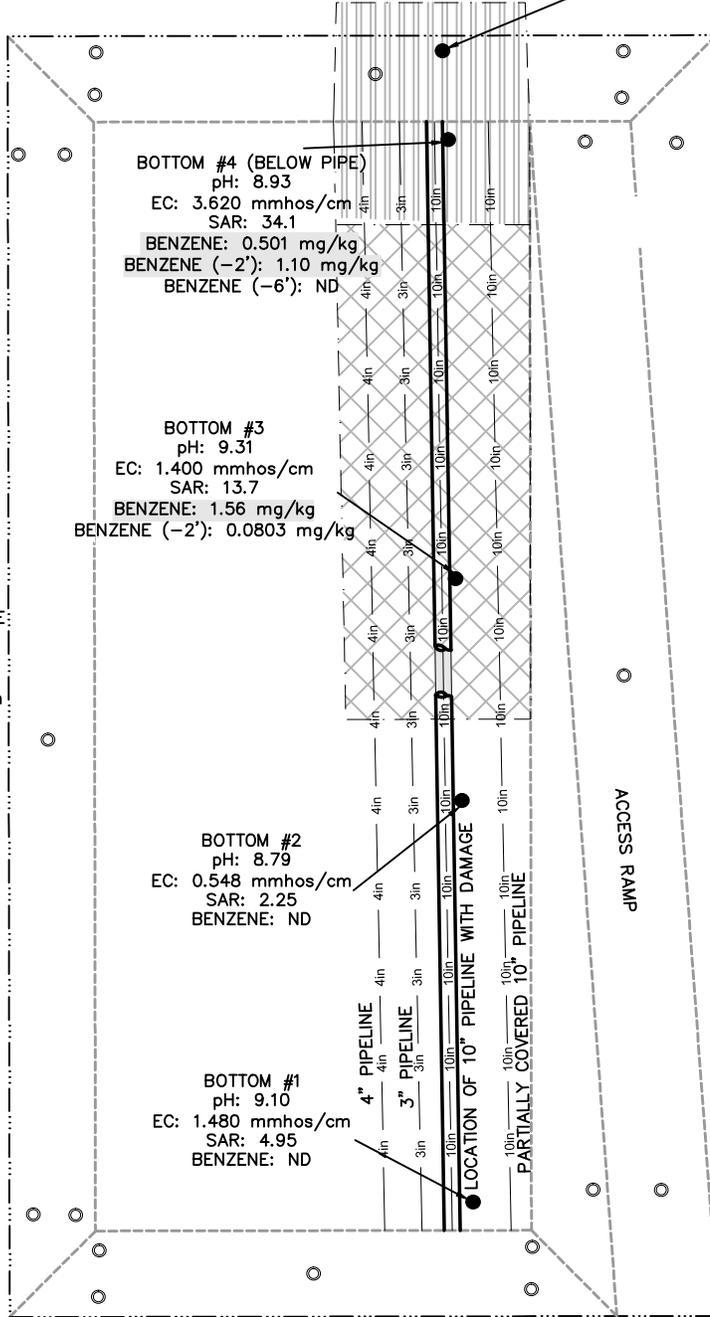

LEGEND

- 3in — 3in — 3" PIPE CENTERLINE
- 4in — 4in — 4" PIPE CENTERLINE
- 10in — 10in — 10" PIPE CENTERLINE
- STOCKPILE AREA
- REPAIR EXCAVATION TOP
- REPAIR EXCAVATION TOE
- (-2') EXCAVATION AREA
- (-6') EXCAVATION AREA
- 10" PIPE INSIDE WALL
- AREA OF 10" PIPE DAMAGE
- INDICATES PREVIOUS BENZENE LEVELS ABOVE 0.170 mg/kg
- INDICATES BENZENE LEVELS ABOVE 0.170 mg/kg
- COMPOSITE SAMPLE LOCATION
- DISCRETE SAMPLE LOCATION

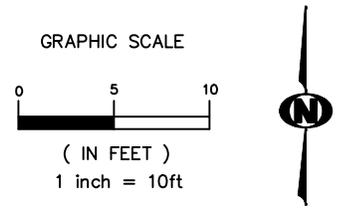

GPS: DS	CHECKED: DK	FIGURE 4	DATE	REVISIONS
DATE: 2/20/14	DRAWN: DRF			
FILE NAME: sample cl	SHEET NO. 4 of 4			
PROJECT NO. 1302-03	SCALE: 1" = 10'			

KRW CONSULTING, INC.
 8000 W. 14TH AVENUE, SUITE 200
 LAKEWOOD, COLORADO
 (303) 239-9011

FIGURE 4
 PICEANCE CREEK
 PWDD RELEASE
 COLLECTED SAMPLE
 CONFIRMATION
 PREPARED FOR XTO ENERGY