


AS-BUILT LOCATION

Al Ward 2-36 Well

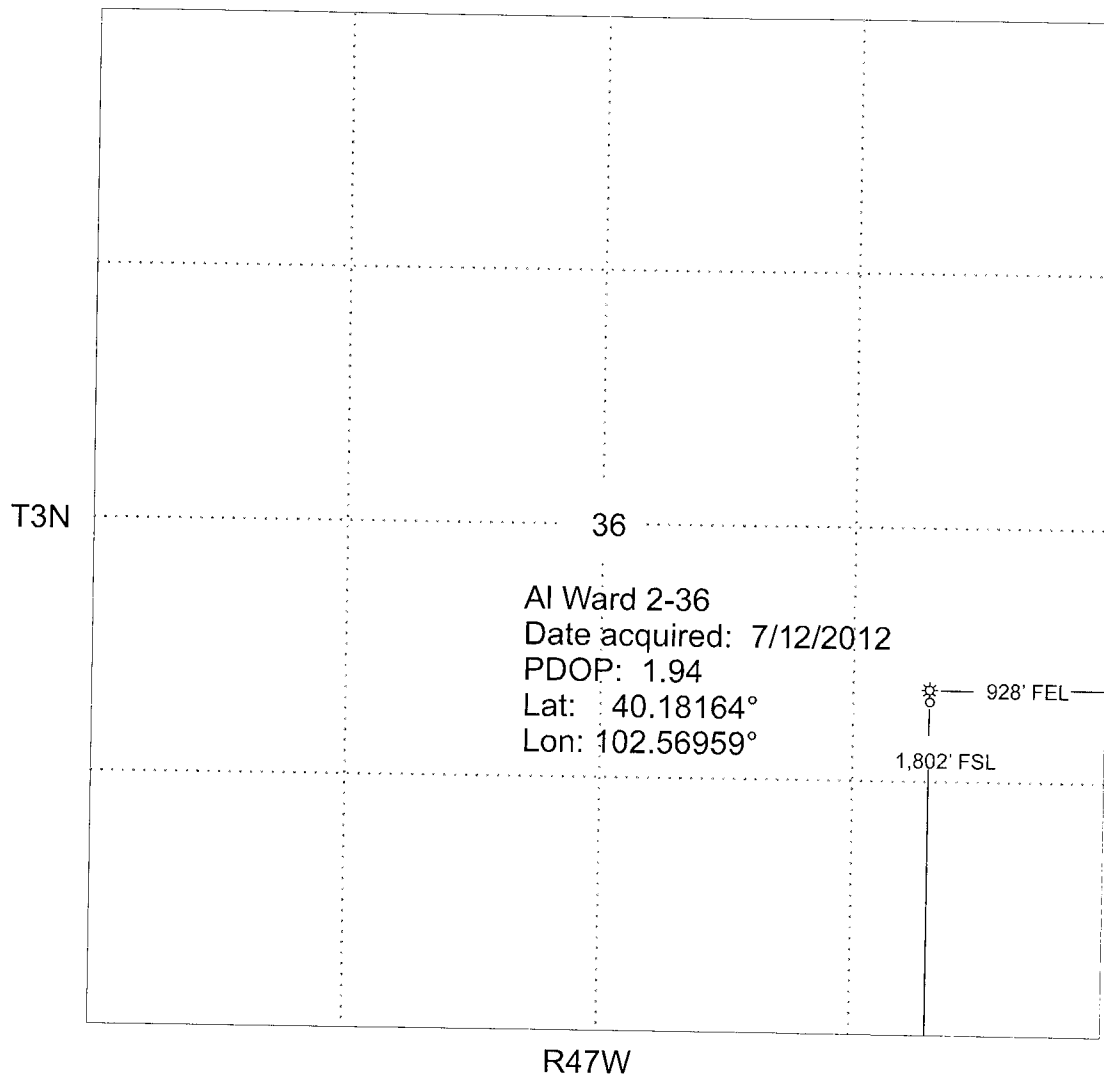

JAMES C KARO
ASSOCIATES
LAND SERVICES

Dated 7/13/2012

Compiled and drawn by Duane Russell
Telephone: 303.279.0789
Email: duane@jameskaro.com