


T1S, R104W, 6th P.M.

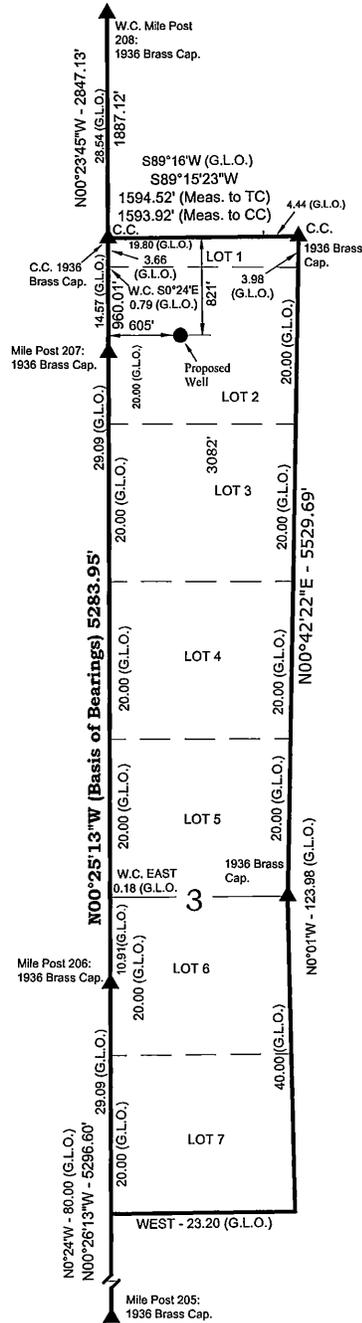

WELL LOCATION:
MEAGHER 3-5
 ELEV. UNGRADED GROUND = 5952.7'

Proposed Well Head NAD 83
 LATITUDE = 40.003159°N
 LONGITUDE = 109.048962°W
 Operator: Andrué Floyd / PDOP = 1.5


NOTES:

- ▲ = Section Corners Located
- 1. Well footages are measured at right angles to the Section Lines.
- 2. Government Land Office (G.L.O.) distances are shown in chains. 1 chain = 66 feet.
- 3. Bearings and distances shown on this plat are based upon a local Cartesian Grid which is oriented to Geodetic North at the SE Corner of Section 36, T9S, R25E, S.L.B.&M. the grid having a mean project height of 5,500'. Lineal units used are U.S. Survey Foot. Trimble G.P.S. equipment was used in performance of this survey.
- 4. Latitude and Longitude are NAD 83 (2011) Epoch 2010. Elevations are NAVD 88. Both derived from the Utah Virtual Reference Station Control System (VRS).
- 5. Surface use of location is grazing. Vegetation consists mainly of sagebrush, native grasses, and Cedar trees.

KGH OPERATING COMPANY
 P.O. Box 2235, Billings, Montana 59101

WELL PLAT

MEAGHER 3-5
821' FNL, 605' FWL
LOT 2 OF SECTION 3, T1S, R104W,
6th P.M., RIO BLANCO COUNTY, UTAH.

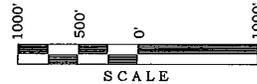


SURVEYOR'S CERTIFICATE

THIS IS TO CERTIFY THAT THE ABOVE PLAT WAS PREPARED FROM FIELD MEASUREMENTS AND SURVEYS MADE BY ME OR UNDER MY SUPERVISION AND THAT THE SAME ARE TRUE AND CORRECT TO THE BEST OF MY KNOWLEDGE AND BELIEF.

JOHN R. SLAUGH
 PROFESSIONAL LAND SURVEYOR
 LICENSE No. 687869
 STATE OF UTAH


TIMBERLINE (435) 789-1365	
ENGINEERING & LAND SURVEYING, INC. 209 NORTH 300 WEST - VERNAL, UTAH 84078	
DATE SURVEYED: 2-24-15	SURVEYED BY: A.F.
DATE DRAWN: 2-25-15	DRAWN BY: S.A.
SCALE: 1" = 1000'	Date Last Revised:
SHEET NO: 4	

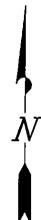

KGH OPERATING COMPANY

ADDENDUM TO LEGAL PLAT FOR
 MEAGHER #3-5
 LOCATED IN RIO BLANCO COUNTY, COLORADO
 SECTION 3, T1S, R104W, 6TH P.M.

~~822' FNL & 505' FWL~~
821 **605**

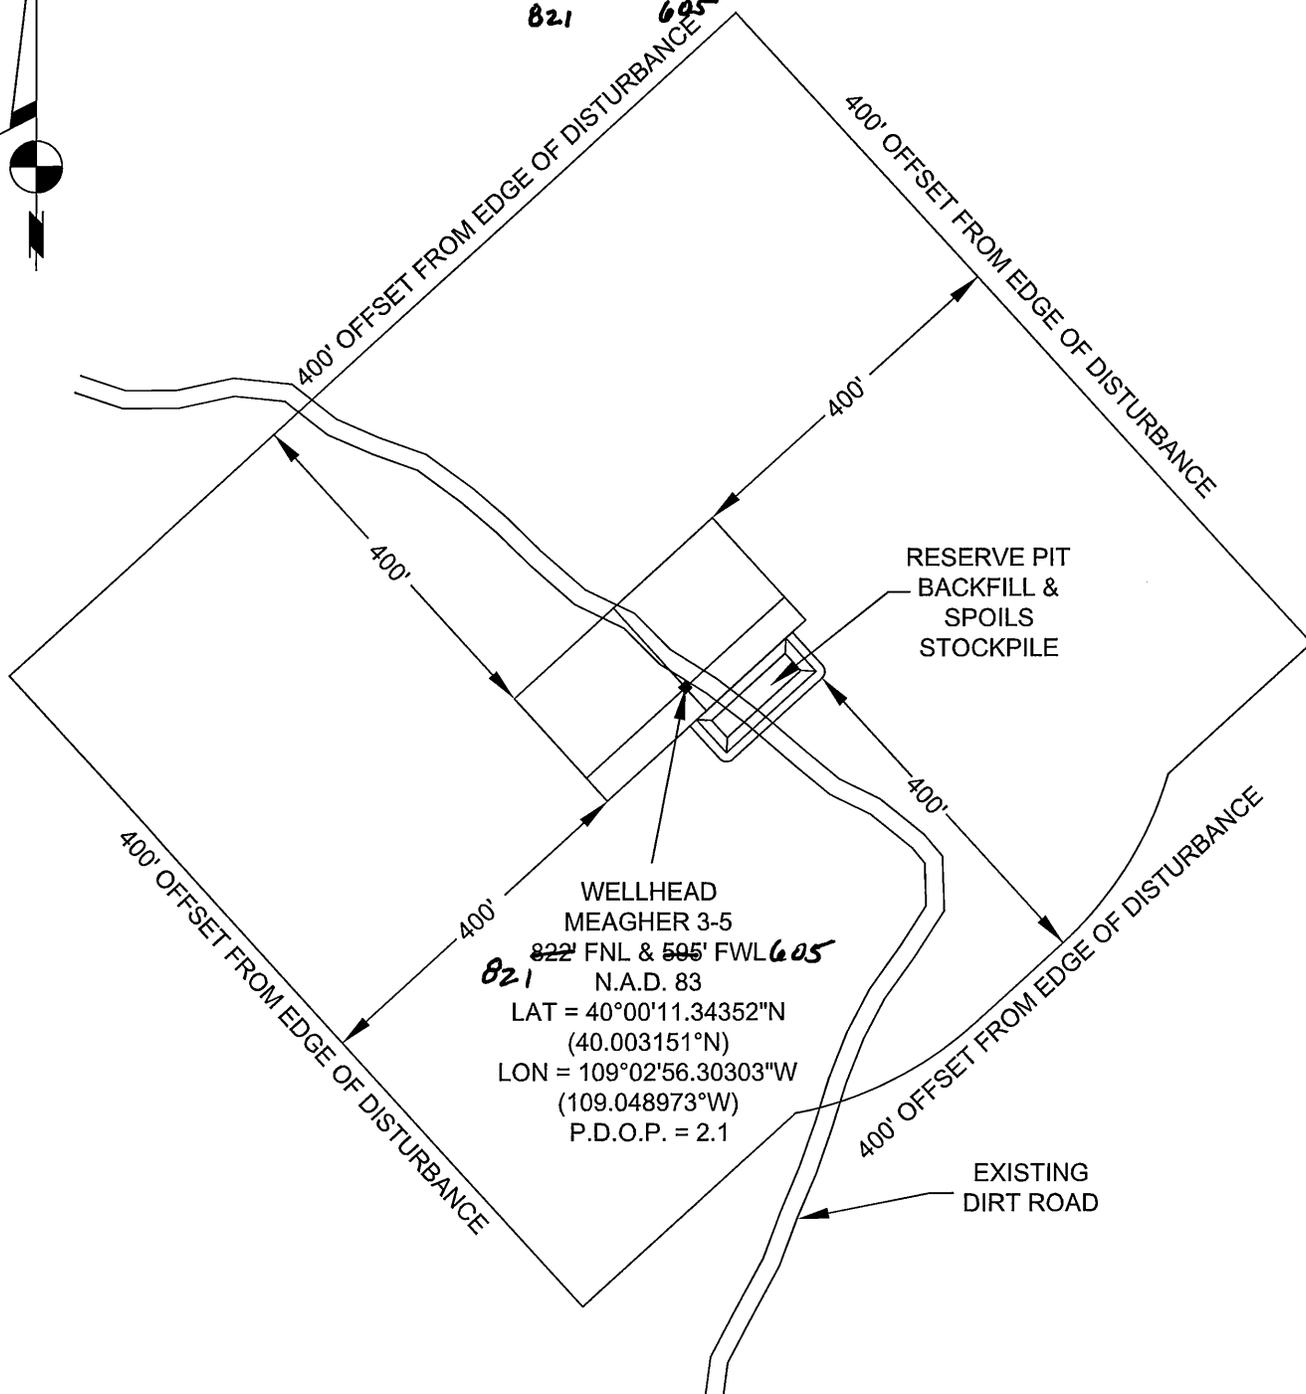

WELLHEAD
 MEAGHER 3-5
~~822' FNL & 505' FWL~~
821 **605**
 N.A.D. 83
 LAT = 40°00'11.34352"N
 (40.003151°N)
 LON = 109°02'56.30303"W
 (109.048973°W)
 P.D.O.P. = 2.1



150 W. 84TH AVENUE PH. 303-702-1617
 THORNTON, COLORADO 80260 FAX. 303-702-1488
 WWW.POWERSURVEYING.COM

<h2>ADDENDUM TO LEGAL PLAT</h2>		SCALE: 1" = 200'	P5
		DATE: 4/29/14	
SURVEYED BY: C. VAN MATRE DRAWN BY: D. YOSHIDA APPROVED BY: R. GABRIEL	REVISED:		