



R 93 W

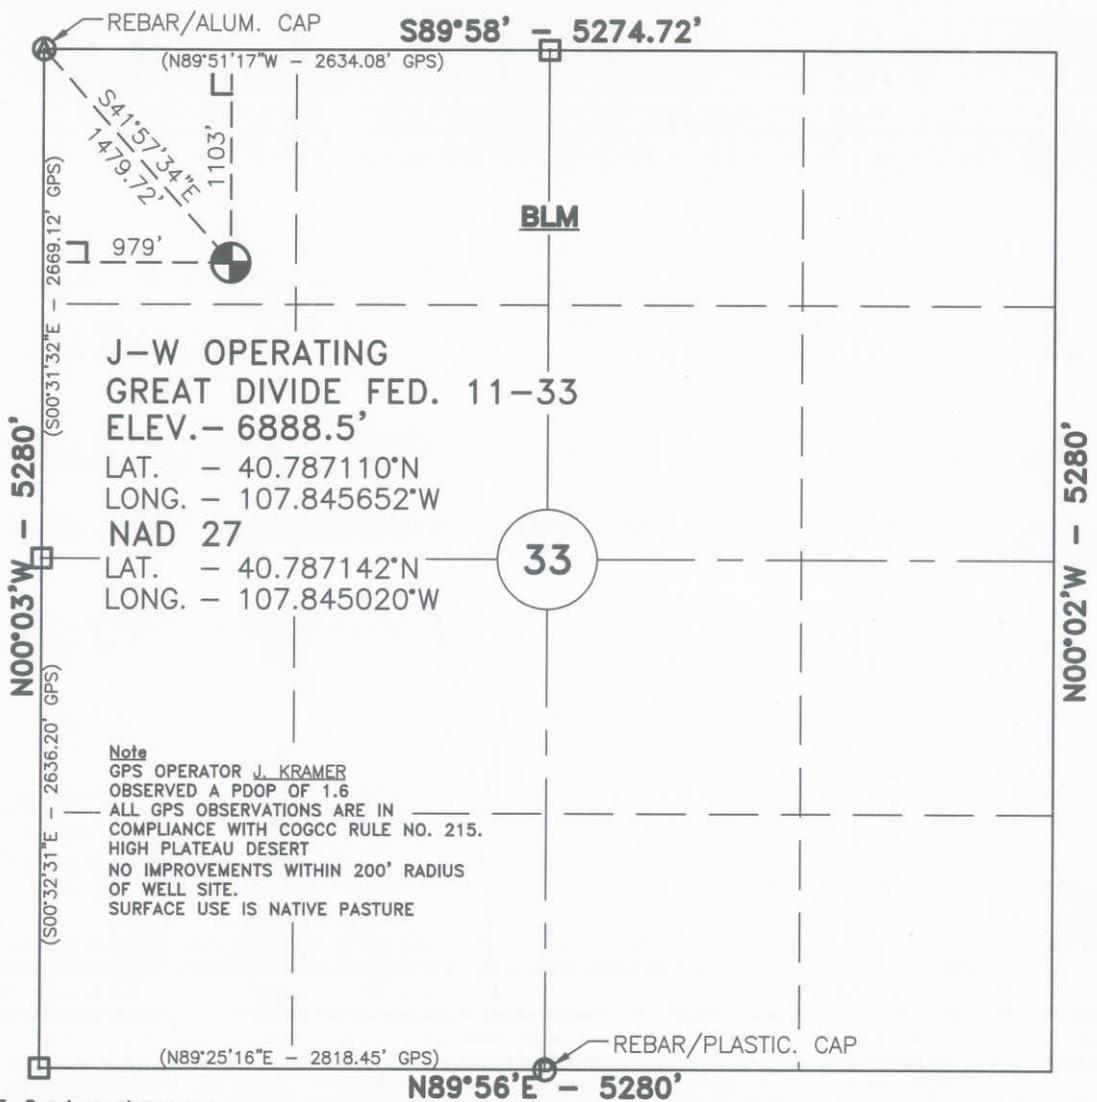

**Note**  
GPS OPERATOR J. KRAMER  
OBSERVED A PDOP OF 1.6  
ALL GPS OBSERVATIONS ARE IN  
COMPLIANCE WITH COGCC RULE NO. 215.  
HIGH PLATEAU DESERT  
NO IMPROVEMENTS WITHIN 200' RADIUS  
OF WELL SITE.  
SURFACE USE IS NATIVE PASTURE

NOTE: Bearings shown are based on State Plane Coordinate System with combined scale factor 0.99991470. Latitudes and Longitudes are NAD 83.

**LOCATION MAP**

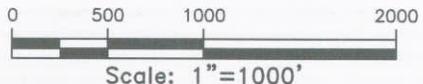

REFERENCE POINTS

LOCATION	ELEV.
N/A NORTH	N/A
N/A EAST	N/A
N/A SOUTH	N/A
N/A WEST	N/A

STATEMENT OF SURVEYOR

I, JOSEPH W. MANATOS of Rock Springs, Wyoming do hereby state that this map was made from field notes taken during an actual survey of the well location made for J-W OPERATING on 3/26/08

*Joseph W. Manatos*  
Wyoming P.L.S. No. 14853

JOSEPH W. MANATOS  
REGISTERED  
14853  
3/27/08  
LAND SURVEYOR  
STATE OF COLORADO

NOTES:

- ☐ STONE CORNERS LOCATED
- BASIS OF ELEV. - S.W. COR. SEC. 33
- ELEV. = 7075'



WELL LOCATION PLAT FOR  
AS-BUILT SURFACE WELLHEAD  
J-W OPERATING  
GREAT DIVIDE FED. 11-33  
NW 1/4 NW 1/4, SEC. 33, T10N, R93W, 6th P.M.  
1103 F.N.L. - 979 F.W.L.  
MOFFAT COUNTY, COLORADO

**JFC ENGINEERS SURVEYORS**  
1515 NINTH STREET  
ROCK SPRINGS, WY 82901  
PHONE (307) 362-7519  
FAX (307) 362-7569  
http://www.jfc-wyo.com

3/27/08  
jld/ggf  
7544-06S

FILE NAME: g:\Data\7544cin.dwg\7544PLAT\_11-33\_WH.dwg 27 MAR 08 14:15