


WEXPRO COMPANY  
AS-BUILT SITE PLAN FOR  
STATE OF COLORADO #2  
SECTION 16, T11N, R97W, 6th P.M.  
SE 1/4 NW 1/4

FIGURE #1  
SCALE: 1" = 50'  
DATE: 07-12-12  
DRAWN BY: J.M.H.  
REV: 10-09-12

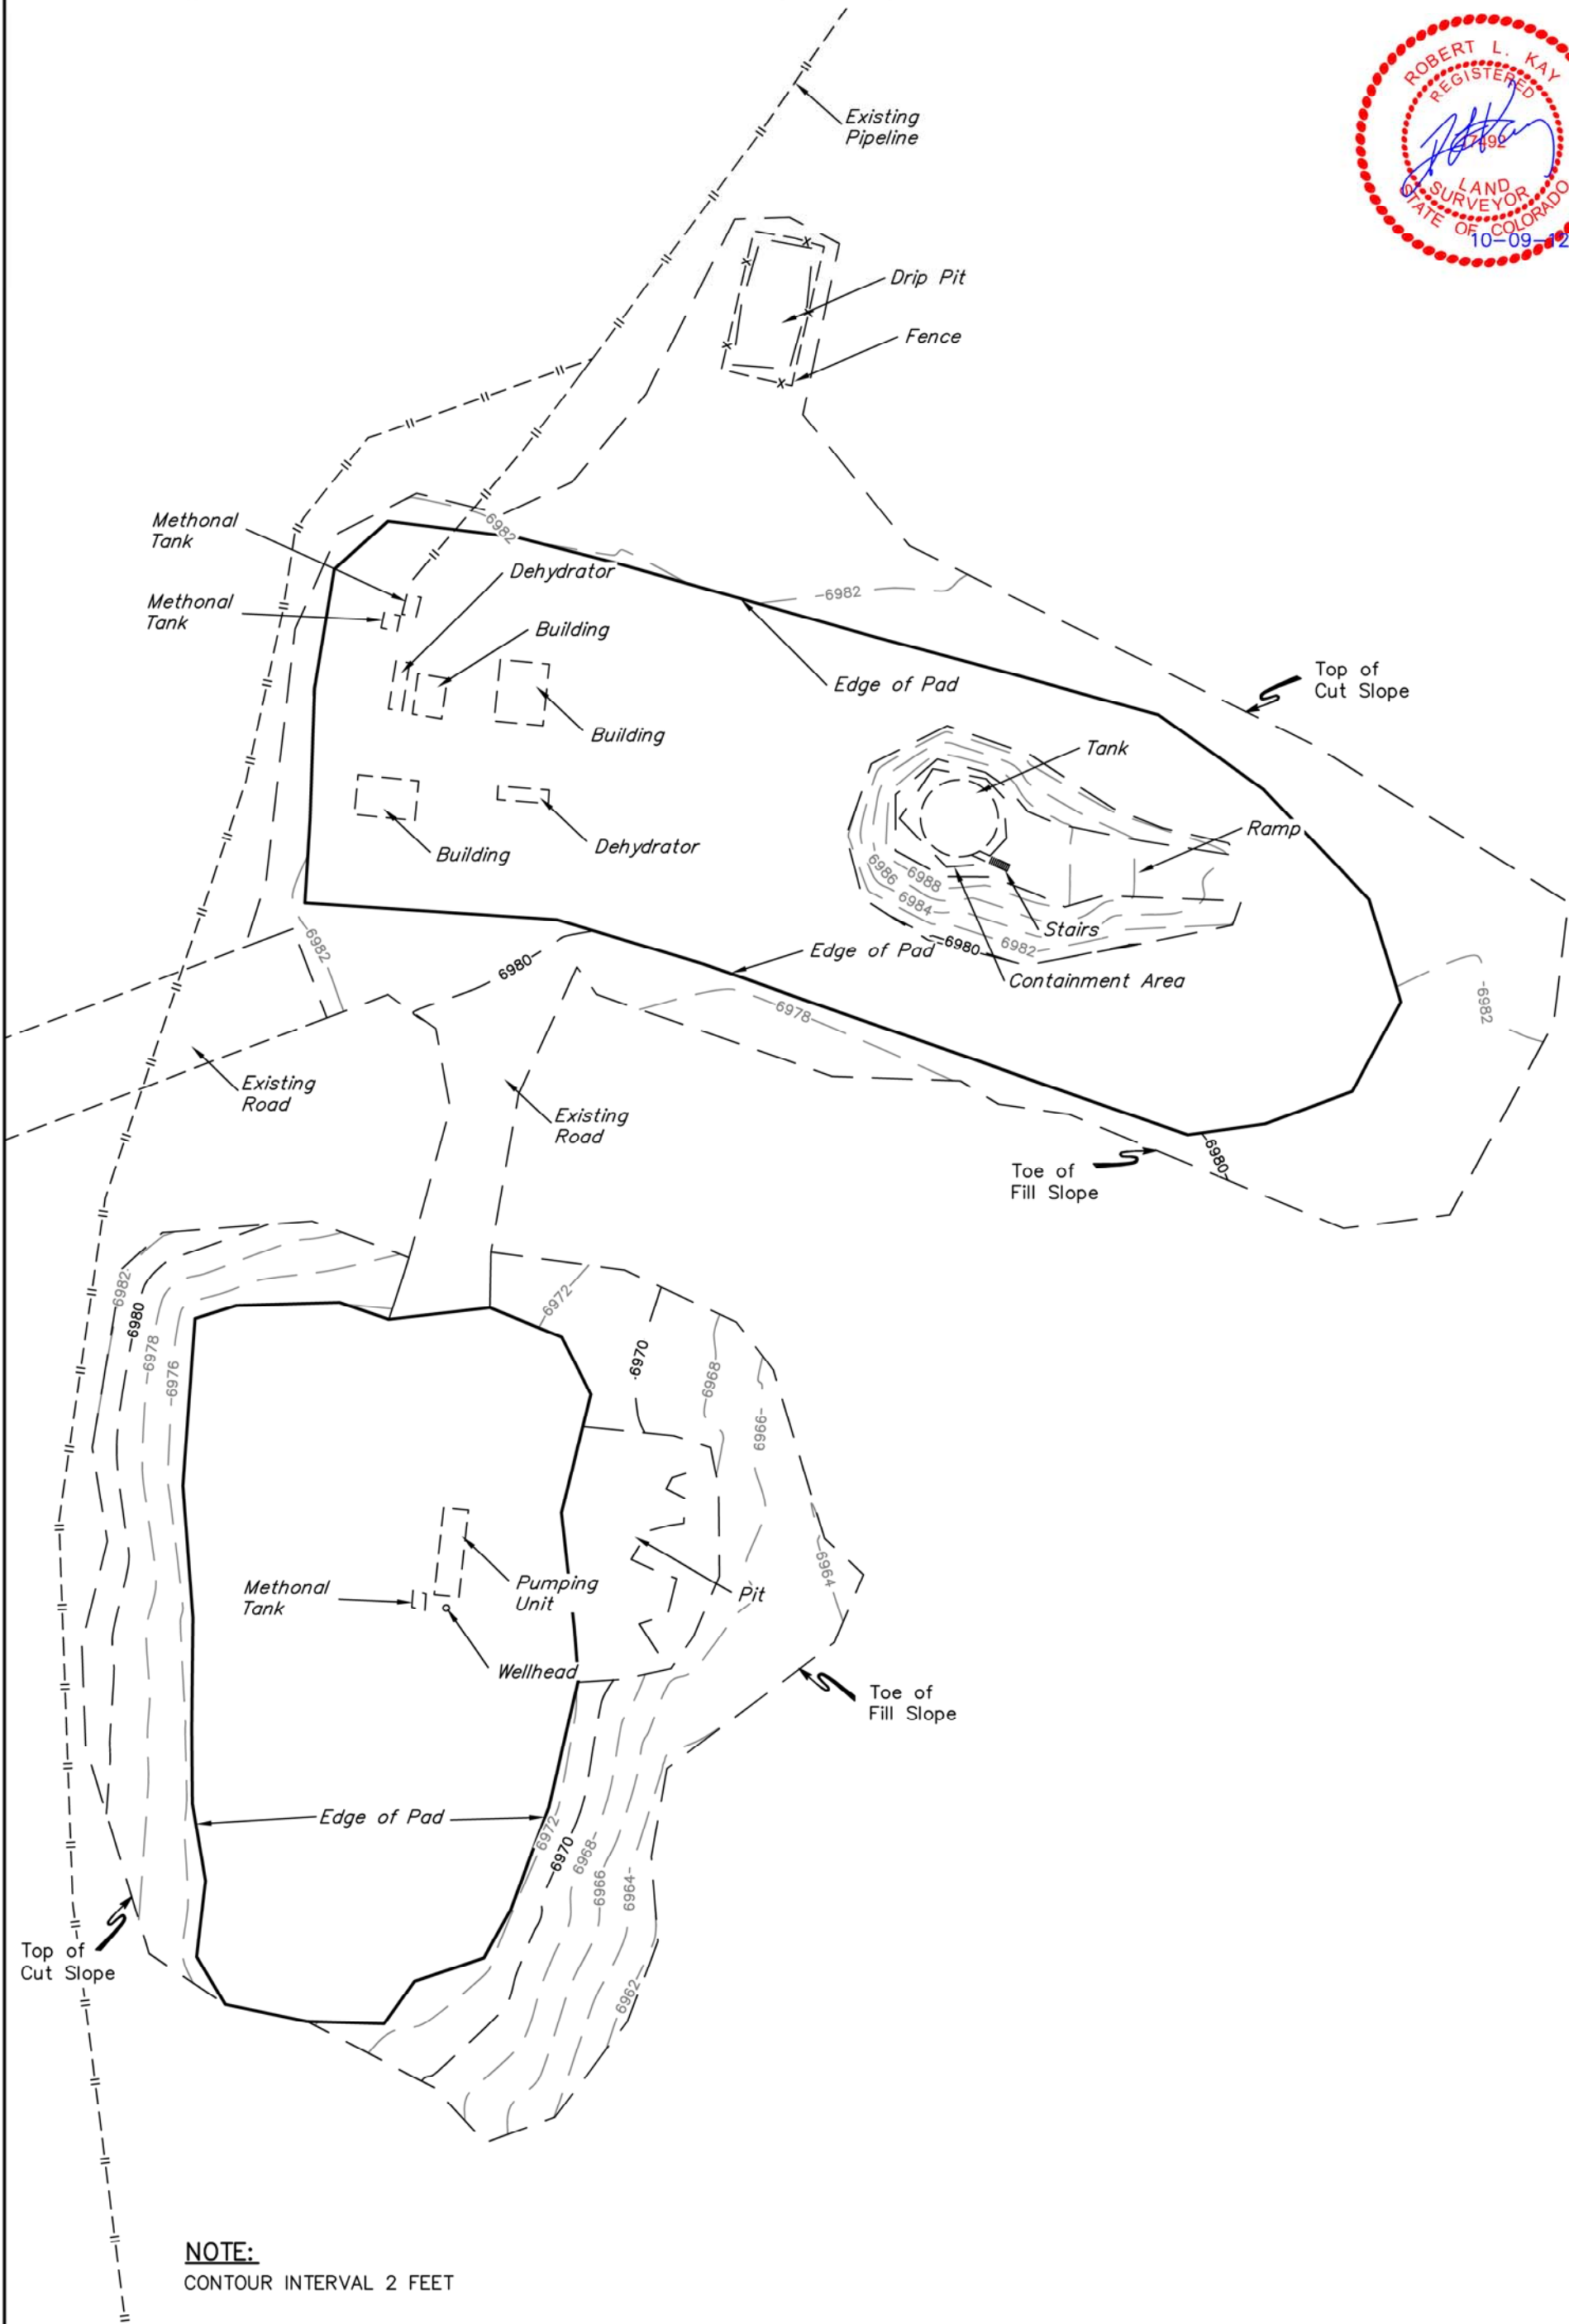

FINISHED GRADE ELEV. AT LOC. STAKE = 6973.6'