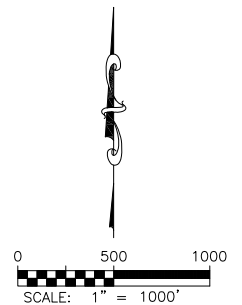
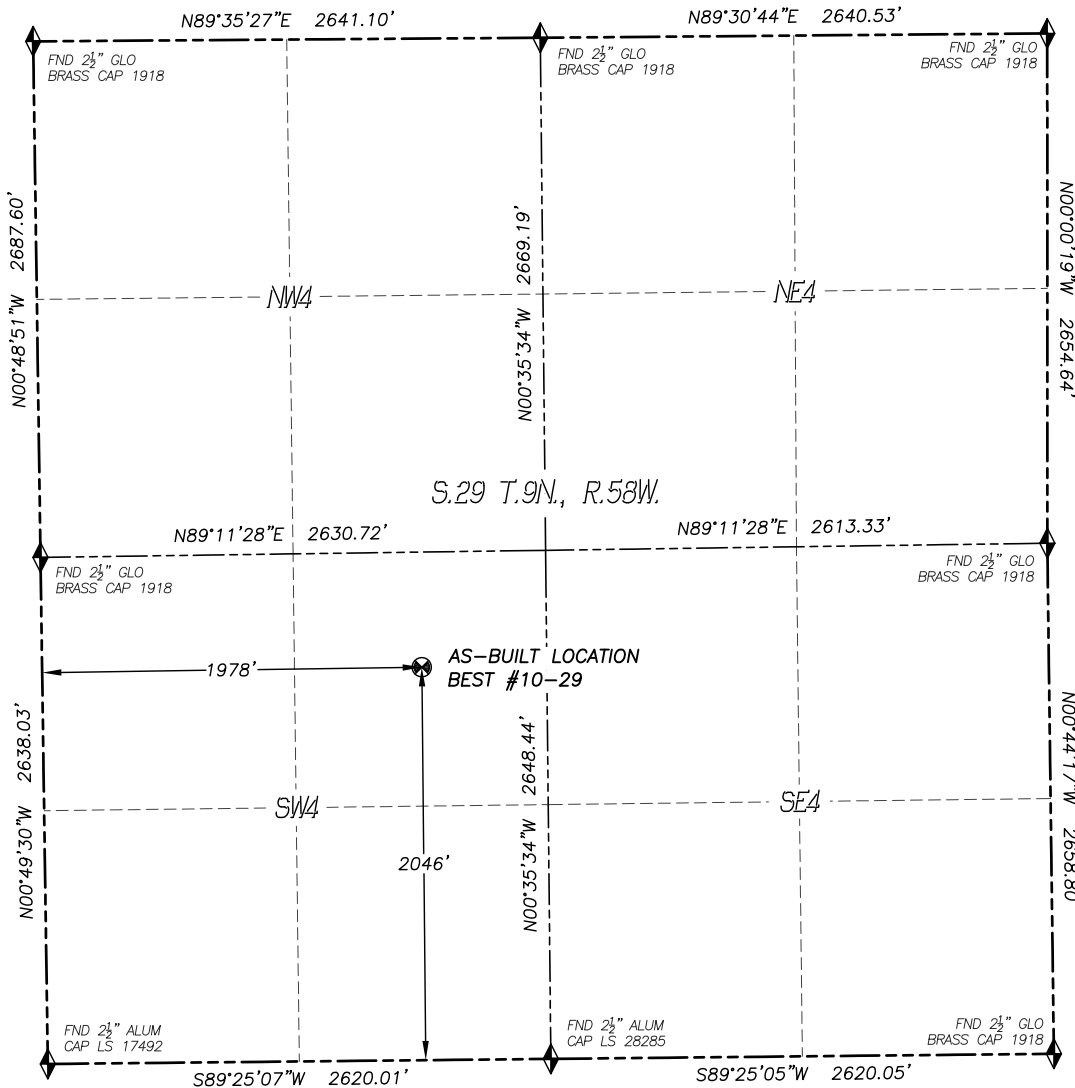


WELL AS-BUILT SURVEY

BEST #10-29

SECTION: 29
TOWNSHIP: 9N
RANGE: 58W

**LEGEND**

- FOUND MONUMENT AS DESCRIBED
- PROPOSED WELL
- EXISTING WELL
- BOTTOM HOLE
- ABANDONED WELL
- CALCULATED POSITION

IN ACCORDANCE WITH A REQUEST FROM REGGY GRAY OF NOBLE ENERGY INC., DALEY LAND SURVEYING, INC. HAS DETERMINED THE SURFACE LOCATION OF THE **BEST #10-29** WELL TO BE 2046' FSL, 1978' FWL, AS MEASURED AT NINETY (90) DEGREES FROM THE SECTION LINES OF SECTION 29, TOWNSHIP 9 NORTH, RANGE 58 WEST, OF THE 6TH PRINCIPAL MERIDIAN, WELD COUNTY, COLORADO.


I HEREBY STATE THAT THIS WELL AS-BUILT WAS PREPARED BY ME OR UNDER MY DIRECT SUPERVISION, THAT THE WORK WAS COMPLETED ON 6/6/2016 FOR AND ON BEHALF OF NOBLE ENERGY, INC., AND THAT THIS MAP DOES NOT REPRESENT A BOUNDARY SURVEY, IT IS NOT A LAND SURVEY PLAT OR AN IMPROVEMENT SURVEY PLAT AND IT IS NOT TO BE RELIED UPON FOR THE ESTABLISHMENT OF FENCE, BUILDING OR OTHER FUTURE IMPROVEMENT LINES.

NOTES:


- 1) BEARINGS FOR THIS MAP ARE ASSUMED AND BASED UPON GPS OBSERVATIONS MADE BETWEEN MONUMENTS LOCATED AT THE SOUTHEAST CORNER AND SOUTH QUARTER CORNER OF SECTION 29, T.9N., R.58W.
- 2) HORIZONTAL DATUM IS NAD83.
- 3) VERTICAL DATUM IS NAVD88 AND ORIGINATES FROM THE LOCAL C.O.R.S. NETWORK, UTILIZING THE GEOID12A MODEL.
- 4) ELEVATION SHOWN IS AT TOP OF CASING PLUG, 0.5'± BELOW EXISTING GROUND ELEVATION.
- 5) SURFACE USE: RANGE LAND.
- 6) INST. OPERATOR: TREVOR DALEY.

NAD 83 LATITUDE AND LONGITUDE**SURFACE LOCATION:**

LATITUDE: N40.72030°
LONGITUDE: W103.89031°
ELEV: 4809'
PDOP: 1.6
QTR/QTR: NE4/SW4

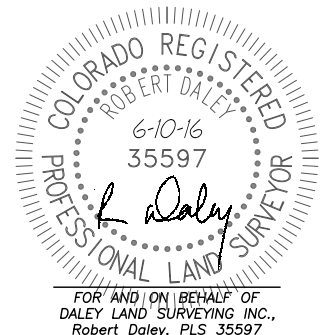

SHEET 1 OF 1

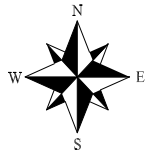


0 2000'
SCALE: 1" = 2000'

DALEY LAND SURVEYING, INC. 970.302.4159

ACCESS ROAD MAP BEST #10-29

SECTION: 29
TOWNSHIP: 9N
RANGE: 58W

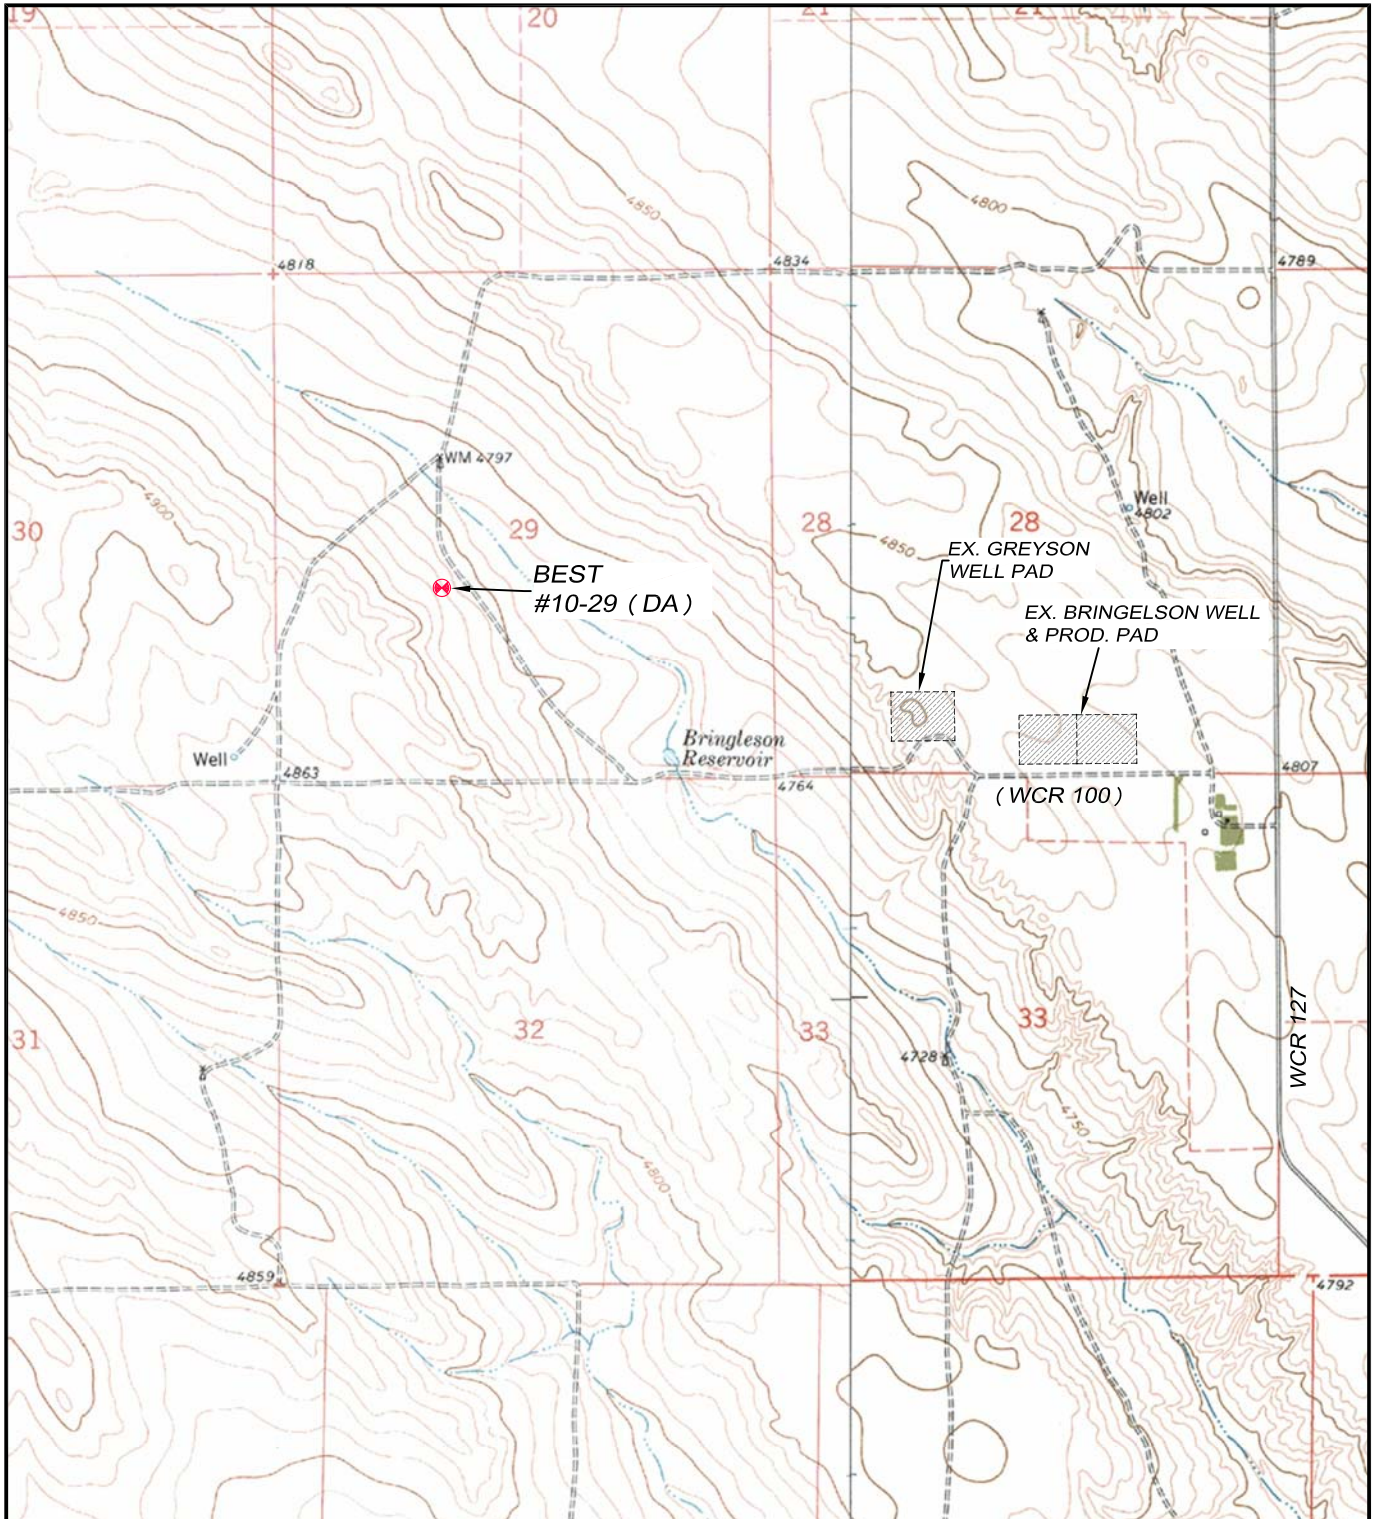

DALEY LAND SURVEYING, INC. 970.302.4159

ACCESS ROAD MAP BEST #10-29

SECTION: 29
TOWNSHIP: 9N
RANGE: 58W

