


AS-BUILT DRAWING

WCR100 GROUP 14-11-8-61 PAD LOC ID # 425364

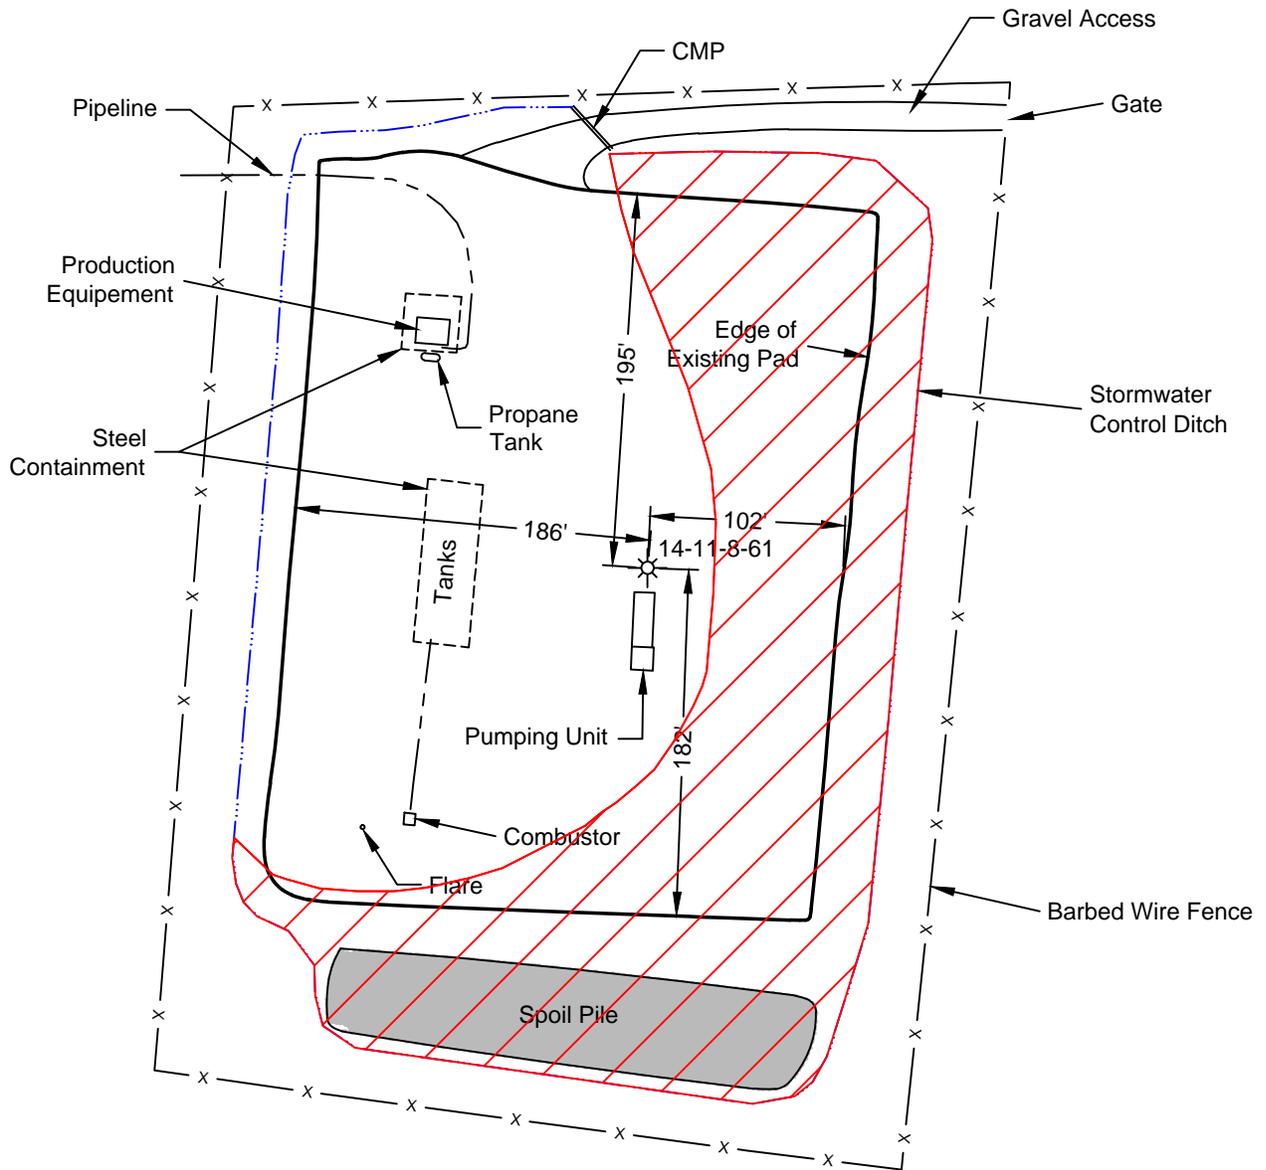

 PROPOSED RECLAIMED ACREAGE

TOTAL PROPOSED RECLAIMED 1.8 ACRES
 NOT ALL TOP SOIL INSIDE OF RECLAIMED
 AREA WILL BE UTILIZED.



North



Graphic Scale in Feet
 1" = 100'

CARRIZO NIOBRARA LLC
 WCR100 GROUP 14-11-8-61 PAD

NW1/4 NW1/4 Section 14 T8N R61W
 6th PM Weld County Colorado