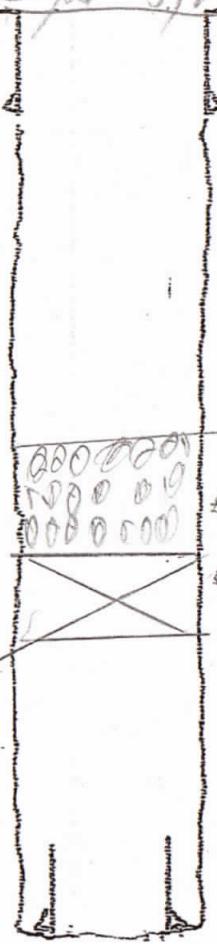


**Wild  
Well Control**

Cherokee-Petroleum #535 API 05-043-40002  
#535 Aug 17.

BY	DATE	SUBJECT	SHEET NO.
Cut off 7' Below surface (cut off Steel plate Welded on <del>top</del> Sept 8, 2016			
2.0 gds 2 matt Mex → 20 sacks			
36t			
			
50# Pmt 6.85'			
193.7' 8-23-16			
Topped <del>Aug 18</del> 7 sacks			
set Aug 17 3 sacks			
248'			

RED CLIFF OIL COMPANY  
WELL # 535.  
Cherokee Pittsburg Lease  
N.E. $\frac{1}{4}$  - N.E. $\frac{1}{4}$  - N.W. $\frac{1}{4}$   
Sec. 29 - Twp. 19 S - R 69 W  
Fremont County  
Colorado.

Pumped with electric power.

Tanks 2 - 150 bbl. # 34 and # 1.

Depth January 1921 5020'

Size hole 3 $\frac{1}{2}$ "

Casing 185' of 6 5/8"  
2045' of 5"  
677' of 4 $\frac{1}{2}$ " (liner)  
350' 6" of 3 $\frac{1}{2}$ " (liner).

Tubing No records

Rods No records

Production No early records

May 1957. 5 $\frac{1}{2}$  BBL per day.

May 1961. 2 $\frac{1}{2}$  BBL per day

Because of no records there is no way of telling how much tubing and rods there is in this well. Also no way of knowing from what depth it is pumping.

All records were copied from Log Book # 6.  
Continental Oil Company.

Feb 25 1971 J. C. G.  
Feb 27 P.M. Pump off the well  
at 100 ft. off bottom  
of the right side  
of the well.