


AS-BUILT NEAREST BUILDING UNIT

ENGLISH FARMS 8-10HZ

SW1/4 SE1/4 SECTION 8, TOWNSHIP 1 NORTH, RANGE 65 WEST, 6TH P.M.

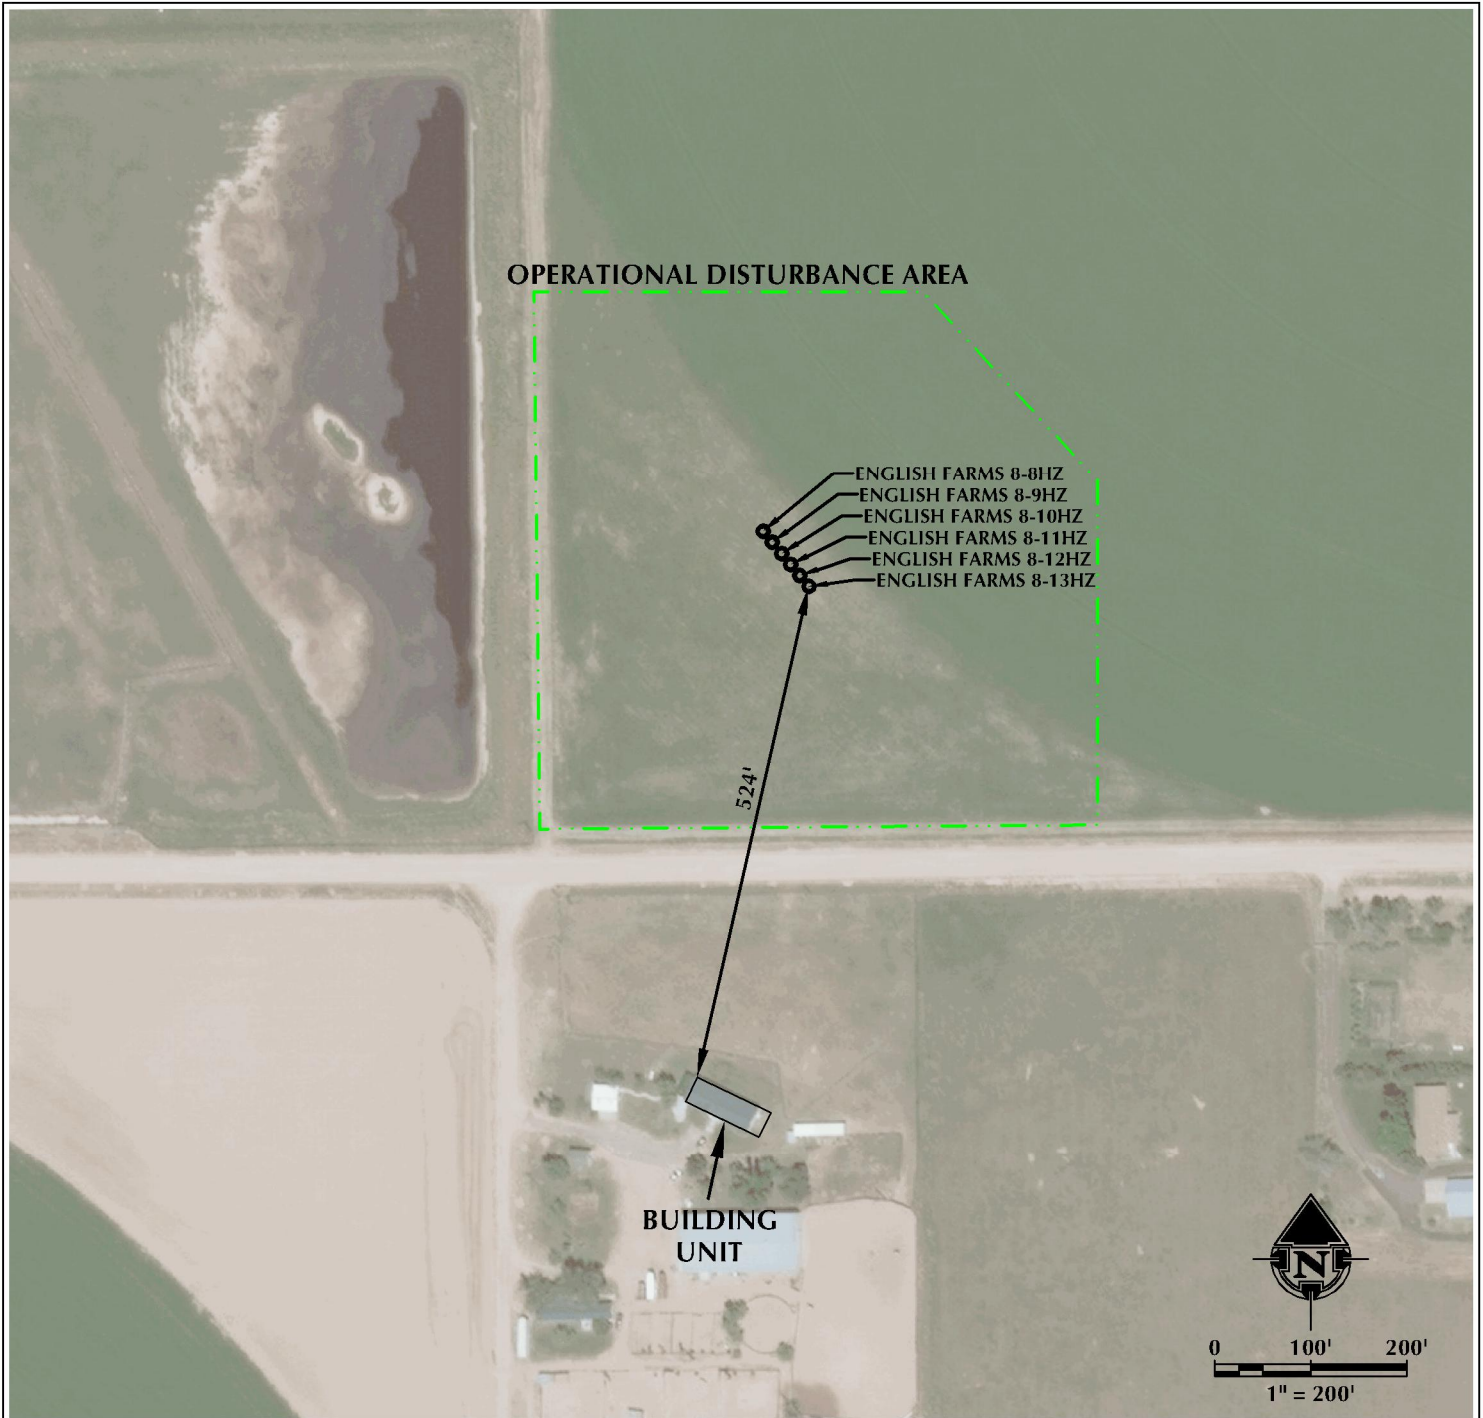

LEGEND

- AS-BUILT WELL
- OPERATIONAL DISTURBANCE AREA
- ▭ EXISTING RESIDENCE/BUILDING UNIT



CONSULTING, LLC
LOVELAND OFFICE
6706 North Franklin Avenue
Loveland, Colorado 80538
Phone: 970-776-4331

SHERIDAN OFFICE
1095 Saberton Avenue
Sheridan, Wyoming 82801
Phone: 307-674-0609

DATE SURVEYED: 5/23/18
DATE: 6/13/18
DRAFTER: SRS
REVISED:

DATA SOURCES:
- AERIAL COURTESY OF ESRI, INC.

PREPARED FOR:
Kerr-McGee Oil & Gas Onshore L.P.