



**PETROX RESOURCES, INC. : TIERRA PIEDRA 33-5 #15-1R
EXISTING WELL PAD ASBUILT DRAWING**

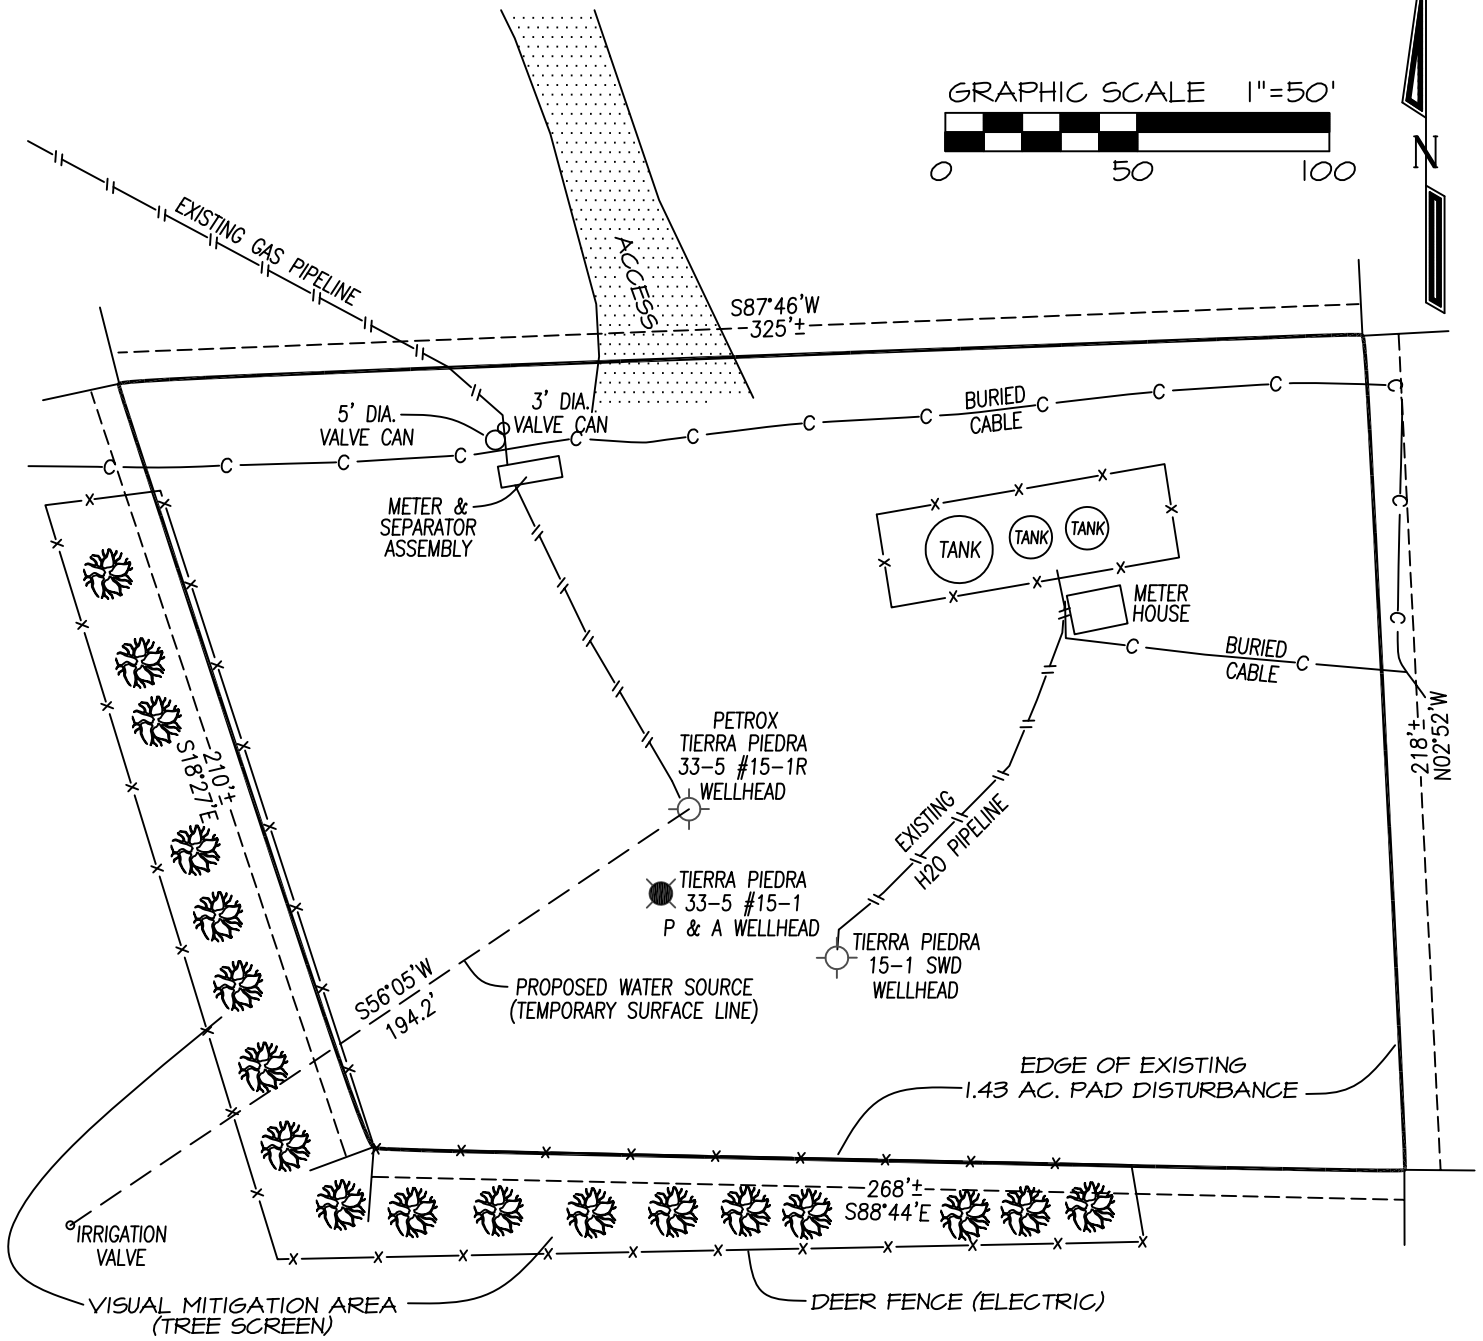

DENOTES EXISTING TREE *

TOTAL AREA OF EXISTING
WELL PAD DISTURBANCE
1.43 ACRES

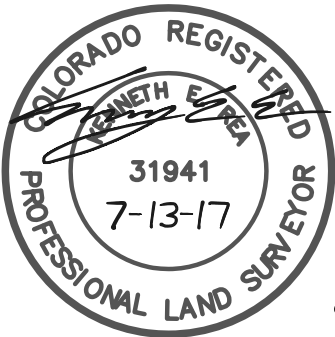

* TREES DEPICTED HEREON ARE FOR ILLUSTRATIVE
PURPOSES ONLY AND ARE NOT INTENDED TO
DEPICT ACTUAL TREE SIZE OR LOCATION

BASIS OF BEARING:

NORTH AMERICAN DATUM OF 1983,
COLORADO SOUTH STATE PLANE
COORDINATE SYSTEM, ZONE 0503.

I, KENNETH E. REA, A REGISTERED PROFESSIONAL LAND SURVEYOR IN
THE STATE OF COLORADO, DO HEREBY CERTIFY THAT THE SURVEY REPRESENTED BY
THIS PLAT WAS MADE UNDER MY DIRECT SUPERVISION AND THAT THIS PLAT
ACCURATELY REPRESENTS THIS SURVEY TO THE BEST OF MY KNOWLEDGE AND BELIEF.

DRAWN BY: K.R.
CHECKED BY: K.R.
FILE NO.: PRI051PD JOB NO. PRI051

PREPARED FOR:

PETROX RESOURCES, INC.

**NORTHSTAR
SURVEYING & MAPPING, INC.**

768 County Rd. 308
DURANGO, CO. 81303
(970) 385-0851