

### AS BUILT WELLBORE DIAGRAM

|                 |                              |
|-----------------|------------------------------|
| Operator:       | <b>GMT Expl., LLC</b>        |
| Well:           | <b>Bennett 10-1</b>          |
| Sec-Twp-Rng:    | <b>NENE 10-6S-65W</b>        |
| SHL:            | <b>0</b>                     |
| Lat/Long:       | <b>39.548616 -104.644401</b> |
| State & County: | <b>Elbert County, CO</b>     |
| API #:          | <b>05-039-06482</b>          |

Notes: Cement is Class "G" 15.8 ppg 1.16 yield.

Spud date: 1/0/1900

G.L.= 6146


K.B.= 6157

11


**Updated**

Date: **6/30/2022**

Initials: **MH**

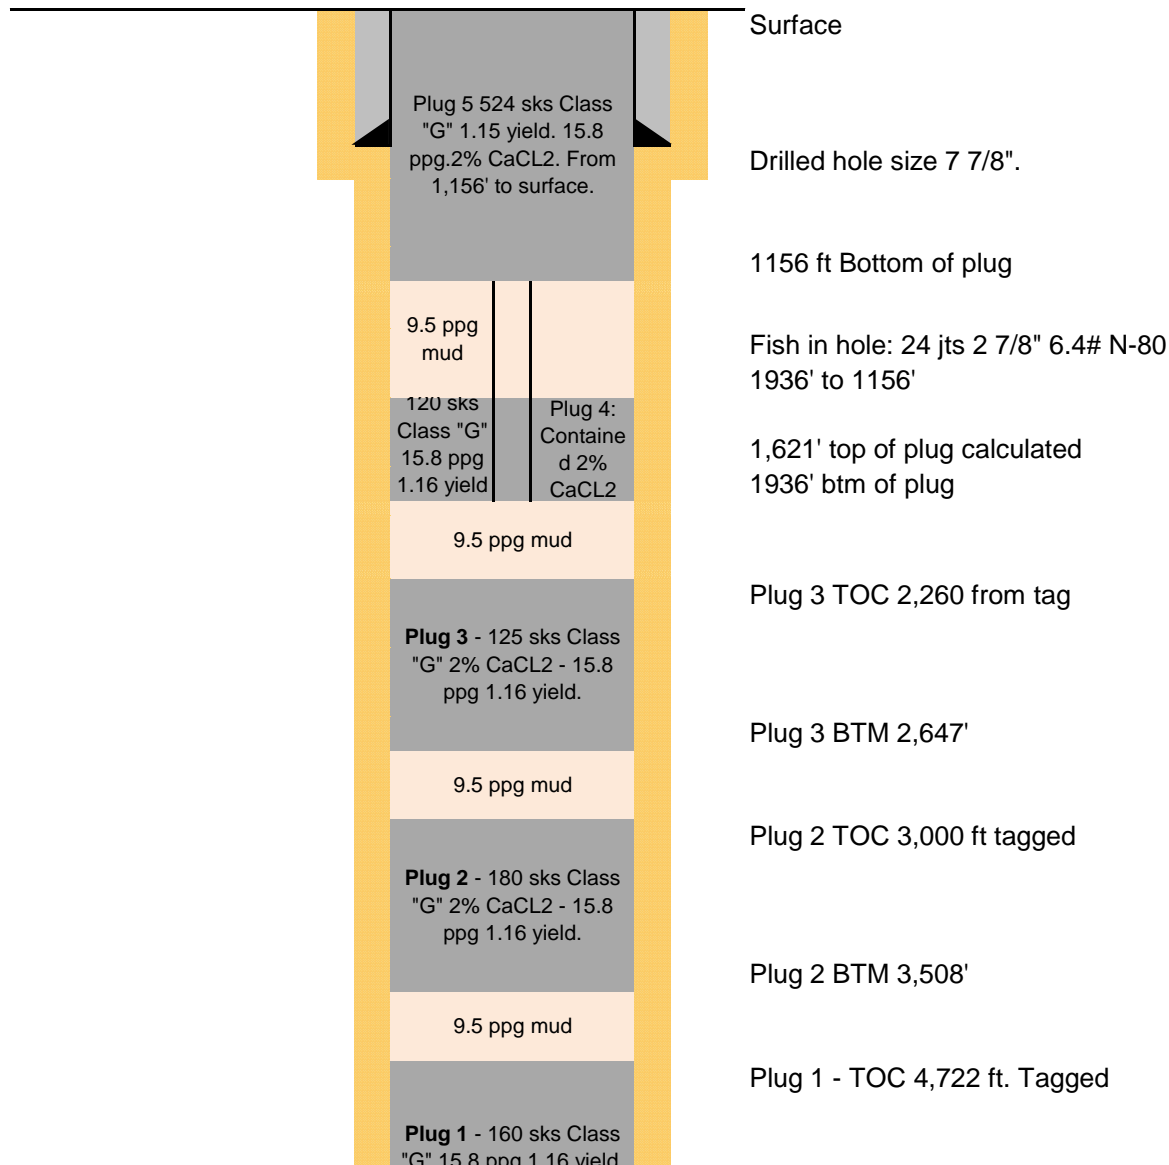

Niobrara 7978  
Greenhorn 8400  
D-Sand 8713  
J-Sand 8753

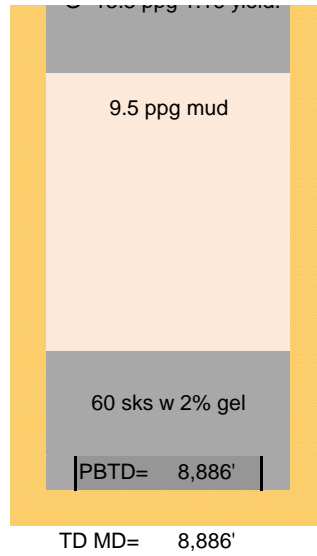

Plug 1 BTM 5,011'  
Start Plugging from this point as Per  
COGCC Eric Jacobson.

Plug placed by Drilling Rig  
8,612' to 8,812'.