


Remed #1768 5/28/06



FIGURES

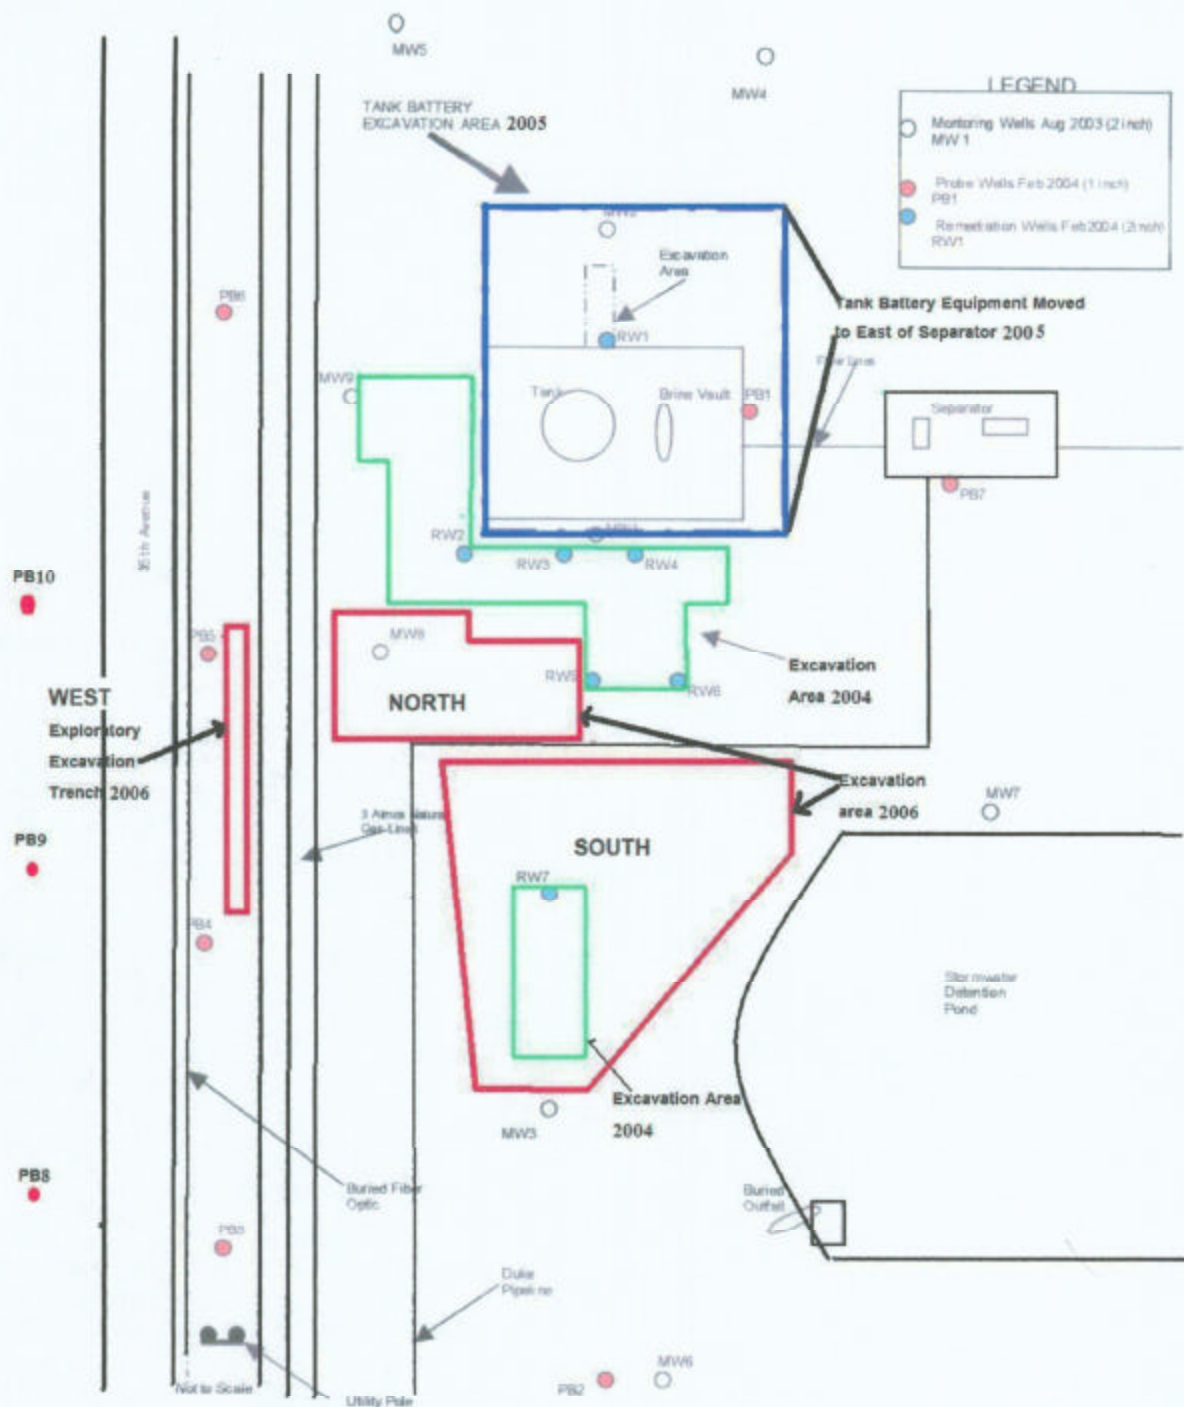

**FIGURE 1 SITE PLAN
ANDERSON COMBS 6
2004, 2005, and 2006 EXCAVATION AREAS**

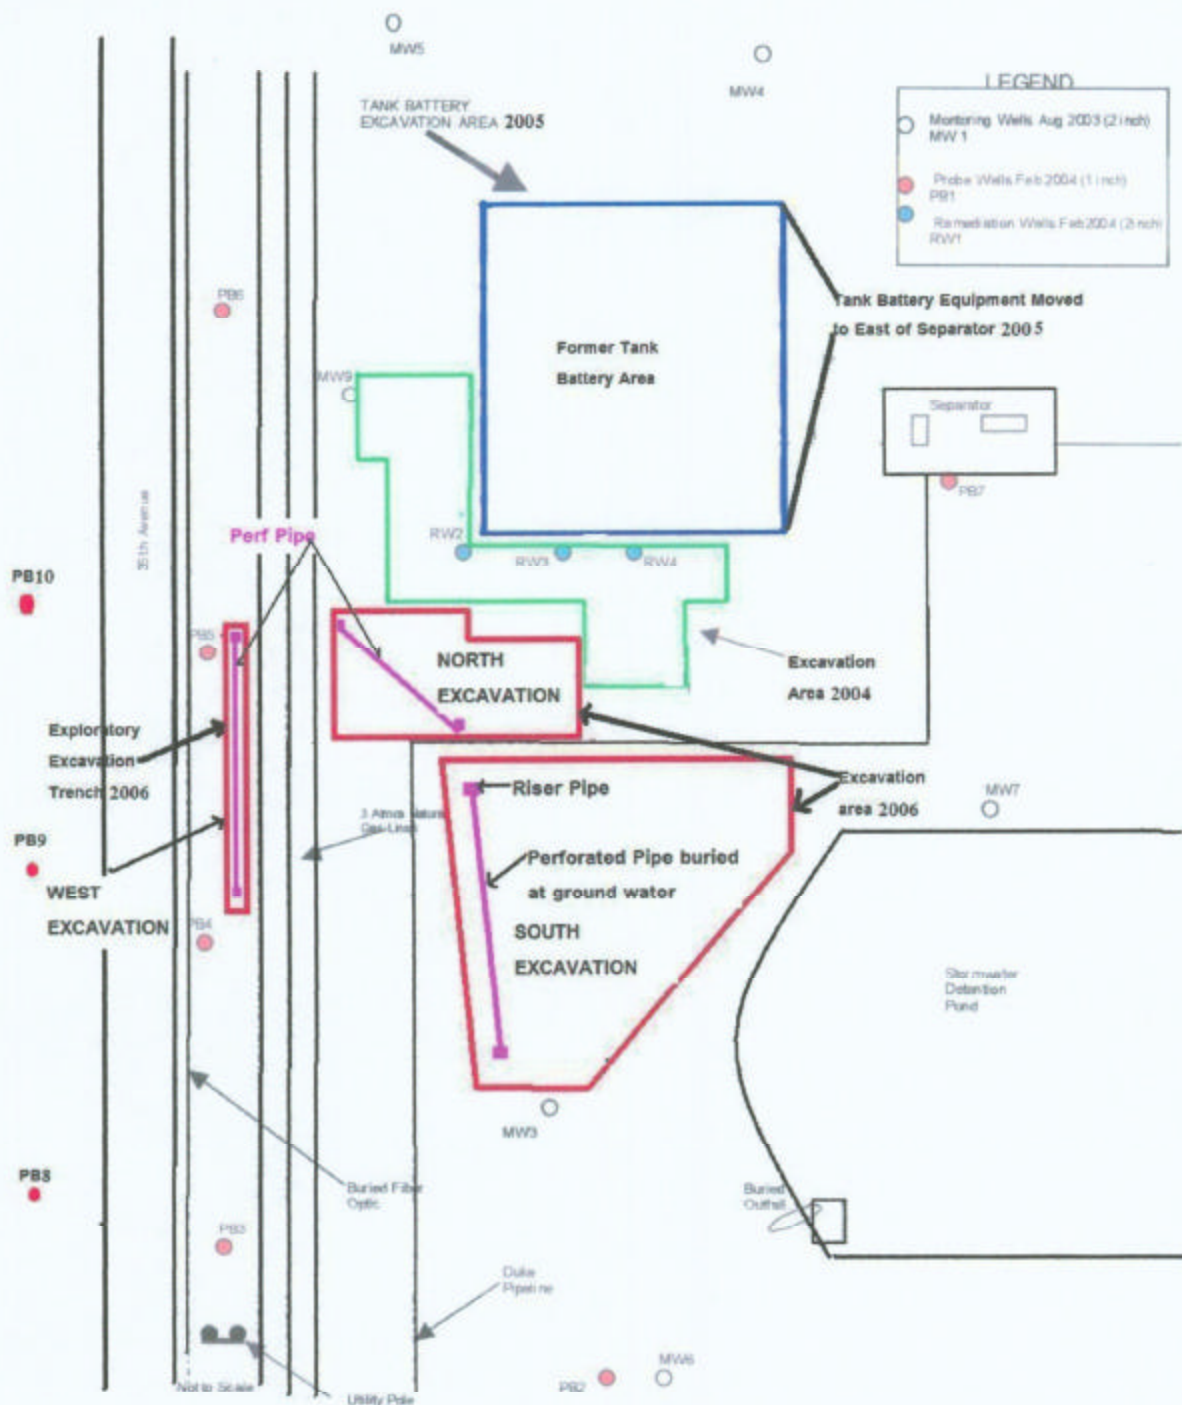



FIGURE 2

EXCAVATION and PERFORATED PIPE LOCATION

ANDERSON COMBS #6

APRIL 2006

EVANS, WELD COUNTY, COLORADO

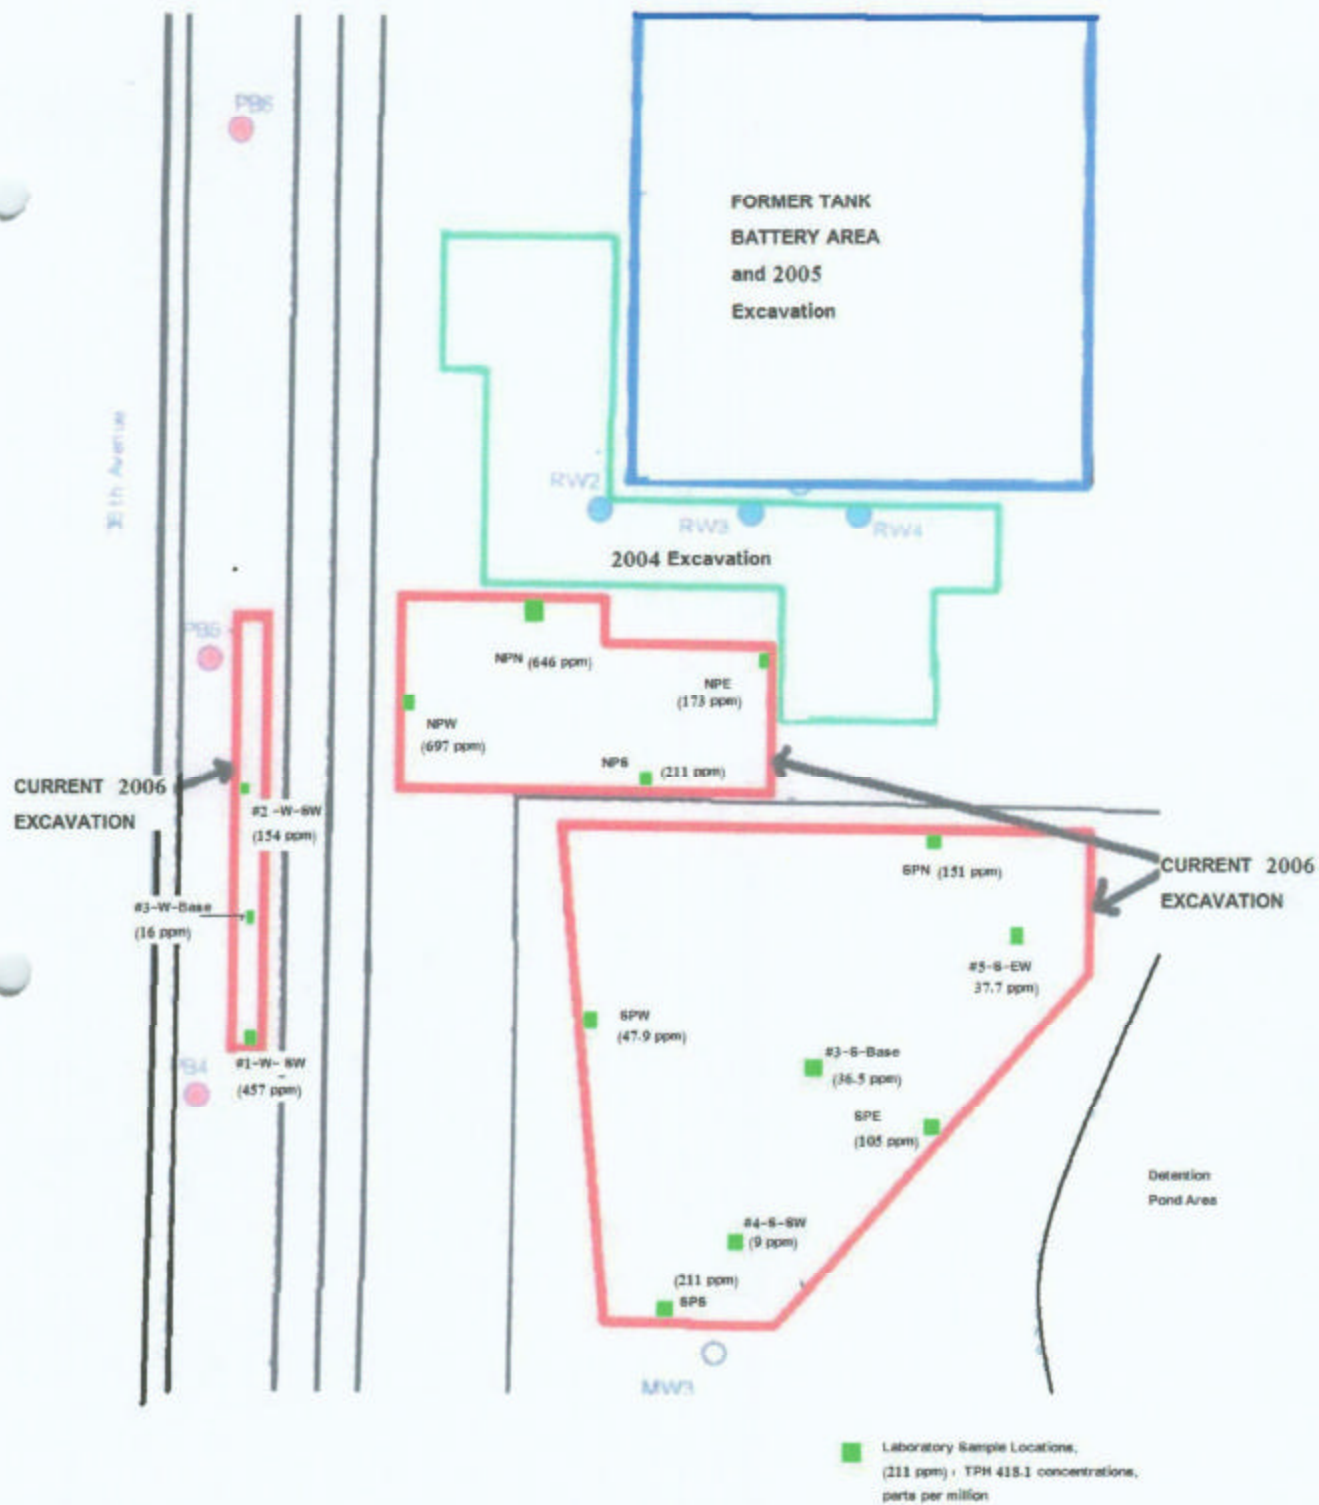


**FIGURE 3: EXCAVATION LABORATORY SAMPLE LOCATIONS
ANDERSON COMBS 6
35th Avenue and 37th Street
Evans, Weld County, Co.**

FIGURE 4

ILLUSTRATION OF SITE DEVELOPMENT
ANDERSON COMBS #6
35TH AVENUE AND 37TH STREET
EVANS, COLORADO

AIR PHOTO 1999

ILLUSTRATION DEPICTS CURRENT VICINITY DEVELOPMENT,
MAY 2006

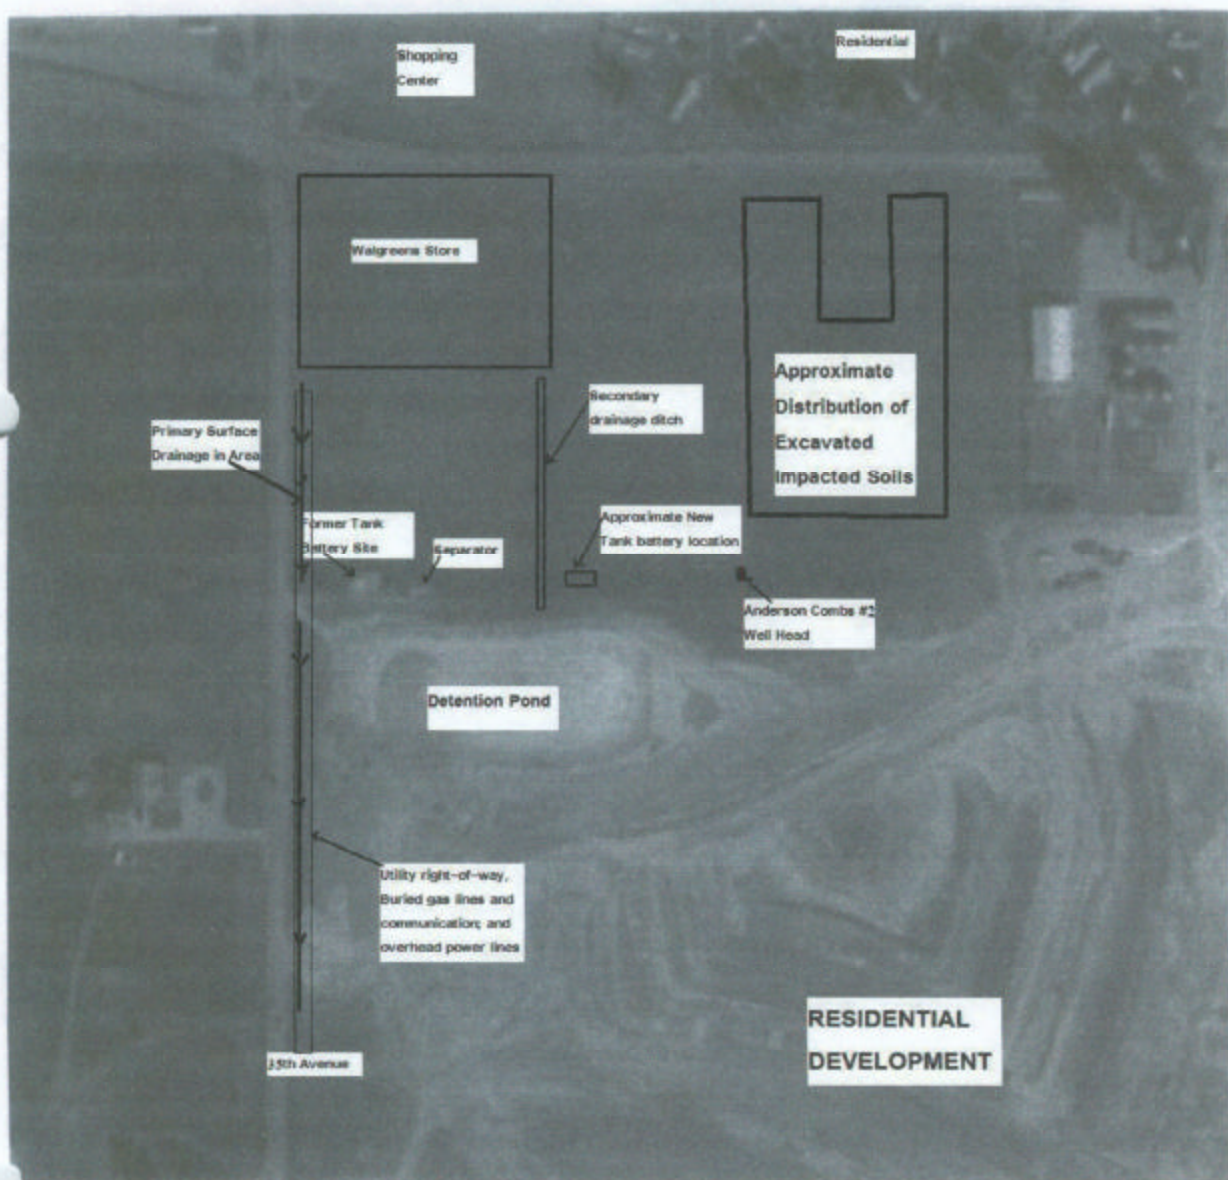

0 0.1 Mi
0 500 Ft

North