


Well Location Sketch:

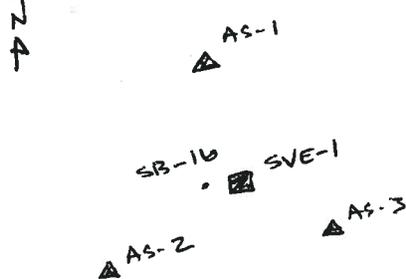

Compliance · Engineering · Remediation

LT Environmental, Inc.

4600 W. 60th Avenue

Arvada, Colorado 80003

BORING LOG/MONITORING WELL COMPLETION DIAGRAM

Boring/Well Number: SVE-1	Project: Noble Bakery
Date: 11-7-08	Project Number: NEP0826
Logged By: James F.	Drilled By: Gabe (Dakota)

Elevation: _____	Detector: MiniRae PID	Drilling Method: HSA	Sampling Method: Cuttings
------------------	---------------------------------	--------------------------------	-------------------------------------

Gravel Pack: Colorado Silica #10-20	Seal: Butonite Chips	Grout: Portland
---	--------------------------------	---------------------------

Casing Type: Sch. 40 PVC	Diameter: 2" #	Length: 5	Hole Diameter: 8"	Depth to Liquid: _____
------------------------------------	--------------------------	---------------------	-----------------------------	------------------------


Screen Type: Sch. 40 PVC	Slot: 0.02"	Diameter: 2" #	Length: 18" 3'	Total Depth: 16' 6'	Depth to Water: _____
------------------------------------	-----------------------	--------------------------	--------------------------	-------------------------------	-----------------------

Penetration Resistance	Moisture Content	Vapor (ppm)	Staining	Sample #	Depth (ft. bgs.)	Sample Run	Recovery	Soil/Rock Type	Lithology/Remarks	Well Completion Diagram
------------------------	------------------	-------------	----------	----------	------------------	------------	----------	----------------	-------------------	-------------------------

					2			SC	sand, fg-mg, clayey, brown. - staining & odor	
			N		4					
		361	Y		6					
					8					
					10					
					12					
					14					
					16					
					18					
					20					
					22					
					24					
					26					
					28					
					30					
					32					
					34					
					36					
					38					

NOTES:

Well Location Sketch:

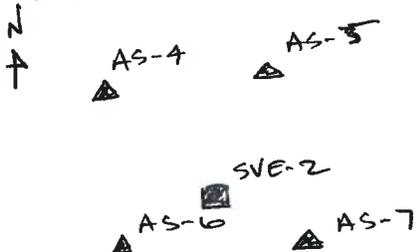

Compliance · Engineering · Remediation

LT Environmental, Inc.

4600 W. 60th Avenue

Arvada, Colorado 80003

BORING LOG/MONITORING WELL COMPLETION DIAGRAM

Boring/Well Number: SVE-2	Project: Noble Beauty
Date: 11-7-08	Project Number: NEP0826
Logged By: James F.	Drilled By: Gabe (Dakota)

Elevation: _____	Detector: MiniPac PID	Drilling Method: HSA	Sampling Method: Cuttings
------------------	--------------------------	-------------------------	------------------------------

Gravel Pack: Colorado Silica #10-20	Seal: Bentonite chips	Grout: Portland
--	--------------------------	--------------------

Casing Type: Sch. 40 PVC	Diameter: 2" 1 1/2	Length: 5'	Hole Diameter: 8"	Depth to Liquid: _____
-----------------------------	----------------------------------	---------------	----------------------	------------------------


Screen Type: Sch 40 PVC	Slot: 0.02"	Diameter: 2" 1 1/2	Length: 18' 3'	Total Depth: 16' 6'	Depth to Water: _____
----------------------------	----------------	----------------------------------	------------------------------	-----------------------------------	-----------------------

Penetration Resistance	Moisture Content	Vapor (ppm)	Staining	Sample #	Depth (ft. bgs.)	Sample Run	Recovery	Soil/Rock Type	Lithology/Remarks	Well Completion Diagram
------------------------	------------------	-------------	----------	----------	------------------	------------	----------	----------------	-------------------	-------------------------

			2		2			SC	Sand, fg-my, clayey, brown, no odor	
		645	✓		4				staining	
					6					
					8					
					10					
					12					
					14					
					16					
					18					
					20					
					22					
					24					
					26					
					28					
					30					
					32					
					34					
					36					
					38					

NOTES:

Well Location Sketch:

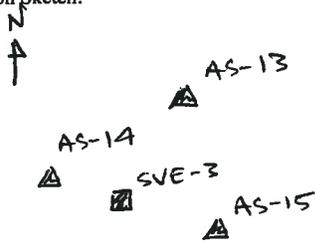

Compliance · Engineering · Remediation

LT Environmental, Inc.

4600 W. 60th Avenue

Arvada, Colorado 80003

BORING LOG/MONITORING WELL COMPLETION DIAGRAM

Boring/Well Number: SVE-3	Project: Noble Beckey
Date: 11-7-08	Project Number: NEP0826
Logged By: James F.	Drilled By: Gabe (Dakota)

Elevation: _____	Detector: MiniRae PID	Drilling Method: HSA	Sampling Method: Cuttings
------------------	--------------------------	-------------------------	------------------------------

Gravel Pack: Colorado Silica #10-20	Seal: Bentonite Chips	Grout: Portland
--	--------------------------	--------------------

Casing Type: Sch 40 PVC	Diameter: 1"	Length: 5' + 4.5' + 0.5'	Hole Diameter: 8"	Depth to Liquid: _____
----------------------------	-----------------	-----------------------------	----------------------	------------------------


Screen Type: Sch. 40 PVC	Slot: 0.02"	Diameter: 1"	Length: + 8' + 3'	Total Depth: + 6' 6"	Depth to Water: _____
-----------------------------	----------------	-----------------	----------------------	-------------------------	-----------------------

Penetration Resistance	Moisture Content	Vapor (ppm)	Staining	Sample #	Depth (ft. bgs.)	Sample Run	Recovery	Soil/Rock Type	Lithology/Remarks	Well Completion Diagram
------------------------	------------------	-------------	----------	----------	------------------	------------	----------	----------------	-------------------	-------------------------

			N		2			SC	sub, fg-mg, clayey, brown	
		516	Y		4				stained	
					6					
					8					
					10					
					12					
					14					
					16					
					18					
					20					
					22					
					24					
					26					
					28					
					30					
					32					
					34					
					36					
					38					

NOTES:

Well Location Sketch:

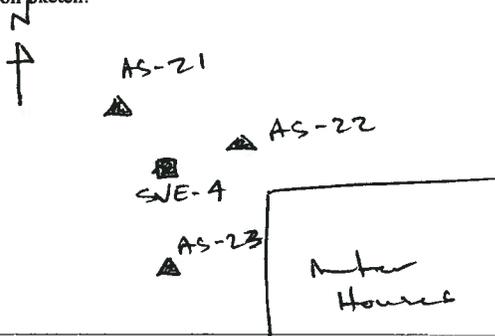

Compliance · Engineering · Remediation

LT Environmental, Inc.

4600 W. 60th Avenue

Arvada, Colorado 80003

BORING LOG/MONITORING WELL COMPLETION DIAGRAM

Boring/Well Number: SVE-4	Project: Noble Bucky
Date: 11-7-08	Project Number: NEP0826
Logged By: James F.	Drilled By: Garza (Dakota)

Elevation: _____	Detector: MiniRoc PID	Drilling Method: HSA	Sampling Method: Cuttings
------------------	--------------------------	-------------------------	------------------------------

Gravel Pack: Colorado Silica #10-20	Seal: Bentonite Chips	Grout: Portland
--	--------------------------	--------------------

Casing Type: Sch 40 PVC	Diameter: 2"	Length: 5'	Hole Diameter: 8"	Depth to Liquid: _____
----------------------------	-----------------	---------------	----------------------	------------------------

Screen Type: Sch 40 PVC	Slot: 0.02"	Diameter: 2"	Length: 3'	Total Depth: 6'	Depth to Water: _____
----------------------------	----------------	-----------------	---------------	--------------------	-----------------------

Penetration Resistance	Moisture Content	Vapor (ppm)	Staining	Sample #	Depth (ft. bgs.)	Sample Run	Recovery	Soil/Rock Type	Lithology/Remarks	Well Completion Diagram
------------------------	------------------	-------------	----------	----------	------------------	------------	----------	----------------	-------------------	-------------------------

			N		2			SC	S&S, Ag-mg, clayey, brown	
		280	Y		4				- stained	
					6					
					8					
					10					
					12					
					14					
					16					
					18					
					20					
					22					
					24					
					26					
					28					
					30					
					32					
					34					
					36					
					38					

NOTES:

Well Location Sketch:

▲ AS-10

■ SVE-10

▲ AS-9

▲ AS-11



Compliance · Engineering · Remediation

LT Environmental, Inc.

4600 W. 60th Avenue

Arvada, Colorado 80003

BORING LOG/MONITORING WELL COMPLETION DIAGRAM

Boring/Well Number: SVE-5	Project: Noble Building
Date: 11-7-08	Project Number: NEP0826
Logged By: James F.	Drilled By: Garbe (Dakota)

Elevation:	Detector: MiniRae PID	Drilling Method: HSA	Sampling Method: Cuttings
------------	--------------------------	-------------------------	------------------------------

Gravel Pack: Colorado Silica #10-20	Seal: Bentonite Chips	Grout: Portland
--	--------------------------	--------------------

Casing Type: Sch. 40 PVC	Diameter: 2"	Length: 5'	Hole Diameter: 8"	Depth to Liquid:
-----------------------------	-----------------	---------------	----------------------	------------------


Screen Type: Sch 40 PVC	Slot:	Diameter: 2"	Length: 3'	Total Depth: 6'	Depth to Water:
----------------------------	-------	-----------------	---------------	--------------------	-----------------

Penetration Resistance	Moisture Content	Vapor (ppm)	Staining	Sample #	Depth (ft. bgs.)	Sample Run	Recovery	Soil/Rock Type	Lithology/Remarks	Well Completion Diagram
------------------------	------------------	-------------	----------	----------	------------------	------------	----------	----------------	-------------------	-------------------------

					2			SC	Sand, fg - mg, clayey, brown.	
		174	Y		4				stained	
					6					
					8					
					10					
					12					
					14					
					16					
					18					
					20					
					22					
					24					
					26					
					28					
					30					
					32					
					34					
					36					
					38					

NOTES:

Well Location Sketch:

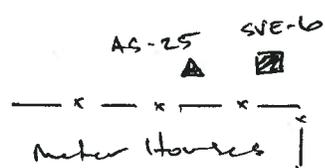

Compliance · Engineering · Remediation

LT Environmental, Inc.
 4600 W. 60th Avenue
 Arvada, Colorado 80003

BORING LOG/MONITORING WELL COMPLETION DIAGRAM

Boring/Well Number: SVE-6	Project: Noble Bucky
Date: 11-7-08	Project Number: NEP0826
Logged By: James F.	Drilled By: Gabe (Dakota)

Elevation:	Detector: MiniRae PID	Drilling Method: HSA	Sampling Method: Cuttings
------------	--------------------------	-------------------------	------------------------------

Gravel Pack: Colorado Silica #10-20	Seal: Bedonite Chips	Grout: Portland
--	-------------------------	--------------------

Casing Type: Sch. 40 PVC	Diameter: 2"	Length: 5'	Hole Diameter: 8"	Depth to Liquid:
-----------------------------	-----------------	---------------	----------------------	------------------


Screen Type: Sch. 40 PVC	Slot:	Diameter: 2"	Length: 3'	Total Depth: 6'	Depth to Water:
-----------------------------	-------	-----------------	---------------	--------------------	-----------------

Penetration Resistance	Moisture Content	Vapor (ppm)	Staining	Sample #	Depth (ft. bgs.)	Sample Run	Recovery	Soil/Rock Type	Lithology/Remarks	Well Completion Diagram
------------------------	------------------	-------------	----------	----------	------------------	------------	----------	----------------	-------------------	-------------------------

					2			SC	Sand, fg-mg, clayey, brown.	
					4					
					6					
					8					
					10					
					12					
					14					
					16					
					18					
					20					
					22					
					24					
					26					
					28					
					30					
					32					
					34					
					36					
					38					

NOTES:

Well Location Sketch:

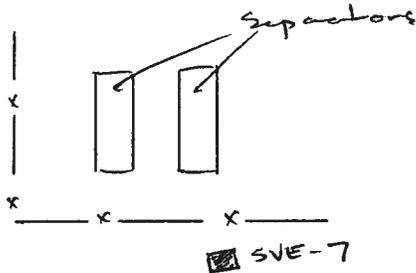

Compliance · Engineering · Remediation

LT Environmental, Inc.
4600 W. 60th Avenue
Arvada, Colorado 80003

BORING LOG/MONITORING WELL COMPLETION DIAGRAM

Boring/Well Number: SVE-7	Project: Noble Bucky
Date: 11-7-08	Project Number: NEP0826
Logged By: James F.	Drilled By: Gabe (Dakota)

Elevation: _____	Detector: MintPac PID	Drilling Method: HSA	Sampling Method: Cuttings
------------------	--------------------------	-------------------------	------------------------------

Gravel Pack: Colorado Silica #10-20	Seal: Baton's Chips	Grout: Portland
--	------------------------	--------------------


Casing Type: Sch. 40 PVC	Diameter: 2"	Length: 5'	Hole Diameter: 8"	Depth to Liquid: _____
-----------------------------	-----------------	---------------	----------------------	------------------------

Screen Type: Sch. 40 PVC	Slot: _____	Diameter: 2"	Length: 3'	Total Depth: 6'	Depth to Water: _____
-----------------------------	-------------	-----------------	---------------	--------------------	-----------------------

Penetration Resistance	Moisture Content	Vapor (ppm)	Staining	Sample #	Depth (ft. bgs.)	Sample Run	Recovery	Soil/Rock Type	Lithology/Remarks	Well Completion Diagram
			Y		2			SC	Sand, fg-mg, clayey, brown. - black staining	
	1107				4					
					6					
					8					
					10					
					12					
					14					
					16					
					18					
					20					
					22					
					24					
					26					
					28					
					30					
					32					
					34					
					36					
					38					

NOTES:

Well Location Sketch:

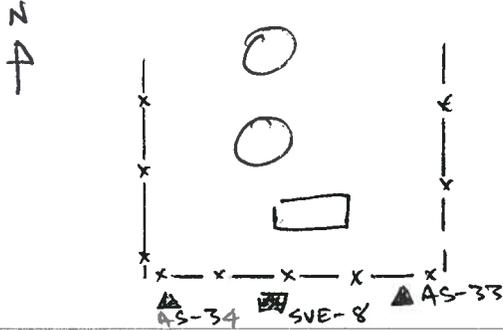

Compliance · Engineering · Remediation

LT Environmental, Inc.
 4600 W. 60th Avenue
 Arvada, Colorado 80003

BORING LOG/MONITORING WELL COMPLETION DIAGRAM

Boring/Well Number: SVE-8	Project: Noble Bucky
Date: 11-7-08	Project Number: NEPO826
Logged By: James F.	Drilled By: Gabe (Dakota)

Elevation: _____	Detector: MiniRae PID	Drilling Method: HSA	Sampling Method: Cuttings
------------------	---------------------------------	--------------------------------	-------------------------------------

Gravel Pack: Colorado Silica #10-20	Seal: Bentonite Chips	Grout: Portland
---	---------------------------------	---------------------------

Casing Type: Sch 40 PVC	Diameter: 2"	Length: 5'	Hole Diameter: 8"	Depth to Liquid: _____
-----------------------------------	------------------------	----------------------	-----------------------------	------------------------

Screen Type: Sch. 40 PVC	Slot: _____	Diameter: 2"	Length: 3'	Total Depth: 6	Depth to Water: _____
------------------------------------	-------------	------------------------	----------------------	-----------------------	-----------------------

Penetration Resistance	Moisture Content	Vapor (ppm)	Staining	Sample #	Depth (ft. bgs.)	Sample Run	Recovery	Soil/Rock Type	Lithology/Remarks	Well Completion Diagram
------------------------	------------------	-------------	----------	----------	------------------	------------	----------	----------------	-------------------	-------------------------

			N						SC Sand, fg-mg. clayey, brown-gray-black staining	
			Y		2					
	872				4					
					6					
					8					
					10					
					12					
					14					
					16					
					18					
					20					
					22					
					24					
					26					
					28					
					30					
					32					
					34					
					36					
					38					

NOTES:

ATTACHMENT 2
LABORATORY ANALYTICAL REPORTS





4640 Pecos Street | Unit C | Denver, Colorado 80211
303.433.1322 Phone 303.265.9645 Fax

November 18, 2008

LT Environmental, Inc.
4600 West 60th Avenue
Arvada CO 80003

Matt Vielhaber
Project Number: NEP0826.01
Project: Becky #2-6

Attached are the analytical results for Becky #2-6 received by Origins Laboratory, Inc. 11/10/2008 4:35:00PM. Please let us know if you have any questions, or if we can help with anything at all.

A handwritten signature in black ink, appearing to read "Noelle E Doyle", written in a cursive style.

Laboratory Manager
Noelle E Doyle

The analytical results in the following report were analyzed under the guidelines of EPA Methods specified in SW-846. The analytical results apply specifically to the samples and analyses specified per the attached Chain of Custody. This laboratory report is intended solely for the above addressee and it is only to be used and or reproduced in its entirety.

4640 Pecos Street | Unit C
Denver, Colorado 80211
303.433.1322 | Laboratory
303.265.9645 | Fax



LT Environmental, Inc.
4600 West 60th Avenue
Arvada CO 80003

Matt Vielhaber
Project Number: NEP0826.01
Project: Becky #2-6

CROSS REFERENCE REPORT

Laboratory ID	Sample ID	Matrix	Sampled	Date Received
MW-1	X811042-01	Water	11/10/2008 8:40:00AM	11/10/2008 16:35
MW-3	X811042-02	Water	11/10/2008 8:50:00AM	11/10/2008 16:35
MW-4	X811042-03	Water	11/10/2008 10:00:00AM	11/10/2008 16:35
MW-32	X811042-04	Water	11/10/2008 9:55:00AM	11/10/2008 16:35
MW-34	X811042-05	Water	11/10/2008 9:15:00AM	11/10/2008 16:35
MW-23	X811042-06	Water	11/10/2008 9:25:00AM	11/10/2008 16:35
MW-7	X811042-07	Water	11/10/2008 10:15:00AM	11/10/2008 16:35
MW-8	X811042-08	Water	11/10/2008 12:00:00PM	11/10/2008 16:35
MW-9	X811042-09	Water	11/10/2008 12:20:00PM	11/10/2008 16:35
MW-24	X811042-10	Water	11/10/2008 12:25:00PM	11/10/2008 16:35
MW-11	X811042-11	Water	11/10/2008 11:50:00AM	11/10/2008 16:35
MW-25	X811042-12	Water	11/10/2008 11:00:00AM	11/10/2008 16:35
MW-13	X811042-13	Water	11/10/2008 1:00:00PM	11/10/2008 16:35
MW-14	X811042-14	Water	11/10/2008 1:20:00PM	11/10/2008 16:35
MW-26	X811042-15	Water	11/10/2008 11:10:00AM	11/10/2008 16:35
MW-30	X811042-16	Water	11/10/2008 12:40:00PM	11/10/2008 16:35
MW-27	X811042-17	Water	11/10/2008 11:30:00AM	11/10/2008 16:35

Origins Laboratory, Inc.

Noelle E Doyle, Laboratory Manager

The results in this report apply to the samples analyzed in accordance with the chain of custody document. This analytical report must be reproduced in its entirety.

4640 Pecos Street | Unit C
Denver, Colorado 80211
303.433.1322 | Laboratory
303.265.9645 | Fax



LT Environmental, Inc.
4600 West 60th Avenue
Arvada CO 80003

Matt Vielhaber
Project Number: NEP0826.01
Project: Becky #2-6

CROSS REFERENCE REPORT

Laboratory ID	Sample ID	Matrix	Sampled	Date Received
MW-15	X811042-18	Water	11/10/2008 1:30:00PM	11/10/2008 16:35
MW-18	X811042-19	Water	11/10/2008 2:00:00PM	11/10/2008 16:35
MW-29	X811042-20	Water	11/10/2008 1:35:00PM	11/10/2008 16:35
MW-17	X811042-21	Water	11/10/2008 2:10:00PM	11/10/2008 16:35

Origins Laboratory, Inc.

Noelle E Doyle, Laboratory Manager

The results in this report apply to the samples analyzed in accordance with the chain of custody document. This analytical report must be reproduced in its entirety.



LT Environmental, Inc.
 4600 West 60th Avenue
 Arvada CO 80003

Matt Vielhaber
 Project Number: NEP0826.01
 Project: Becky #2-6

811049
 page 1 of 2

originslaboratory.com
 Project Manager: Matt Vielhaber
 Project Name: NOBLE BECKY 2-6
 Project Number: NEP0826
 Sampler Collected by: Julia Kofke/Wilhelm
 Client: LT Environmental
 Address: 4600 W 60th Ave
 Arvada CO 80003
 Telephone Number: 303 433 9788
 E-Mail Address: mvvielhaber@ltenv.com

Sample ID - Description	Date Sampled	Time Sampled	Number of Containers	Preservative				Matrix				Analysis	Sample Instructions	
				Unpreserved	HCl	HNO ₃	Other	Groundwater	Soil	Air - Summa Canister	Other			
MW1	11/10/08	940	3	X	X	X	X	X	X	X	X	X		
MW2	11/10/08	850	3	X	X	X	X	X	X	X	X	X		
MW3		1000	3	X	X	X	X	X	X	X	X	X		
MW2K		955	3	X	X	X	X	X	X	X	X	X		
MW3K		915	3	X	X	X	X	X	X	X	X	X		
MW2D		925	3	X	X	X	X	X	X	X	X	X		
MW7		105	3	X	X	X	X	X	X	X	X	X		
MW5		1200	3	X	X	X	X	X	X	X	X	X		
MW9		1220	3	X	X	X	X	X	X	X	X	X		
MW12A		1225	3	X	X	X	X	X	X	X	X	X		
Requested by: <i>Julia Kofke</i>	Date: 11/10/08	Time: 10:35	Received by: <i>[Signature]</i>	Date: 11-6-08	Time: 1:55	Temperature Upon Receipt: 5.1C	Turn Around Time: 24-hr	Standard: <input checked="" type="checkbox"/>						

Page 4 of 31
 Laboratory: 303.433.1322 Fax: 303.265.9645

Origins Laboratory, Inc.

Noelle E Doyle

Noelle E Doyle, Laboratory Manager

The results in this report apply to the samples analyzed in accordance with the chain of custody document. This analytical report must be reproduced in its entirety.



LT Environmental, Inc.
 4600 West 60th Avenue
 Arvada CO 80003

Matt Vielhaber
 Project Number: NEP0826.01
 Project: Becky #2-6

X811042
 page 2 of 3

originslaboratory.com

Client: LT Environmental
 Address: 4600 W. 60th Ave
 Telephone Number: 303 433 9788
 E-Mail Address: mvvielhaber@ltenv.com

Project Manager: Matt Vielhaber
 Project Name: Becky #2-6
 Project Number: NEP0826
 Samples Collected by: Julia Rutter, MacKee

Sample ID - Description	Date Sampled	Time Sampled	Number of Containers	Preservative				Matrix				Analysis				Sample Instructions
				Unpreserved	HCl	HNO ₃	Other	Groundwater	Soil	Air - Summa Canister #	Other	Time	Date	Time	Date	
MW11	11/10/08	11:50	3	X	X	X	X	X	X	X	X	X	X	X		
MW25		11:00	3	X	X	X	X	X	X	X	X	X	X	X		
MW13		13:00	3	X	X	X	X	X	X	X	X	X	X	X		
MW14		13:20	3	X	X	X	X	X	X	X	X	X	X	X		
MW26		11:10	3	X	X	X	X	X	X	X	X	X	X	X		
MW30		12:40	3	X	X	X	X	X	X	X	X	X	X	X		
MW27		11:30	3	X	X	X	X	X	X	X	X	X	X	X		
MW15		13:50	3	X	X	X	X	X	X	X	X	X	X	X		
MW18		14:00	3	X	X	X	X	X	X	X	X	X	X	X		
MW29		13:55	3	X	X	X	X	X	X	X	X	X	X	X		
Requested by: <u>Julia Rutter</u>	Date: <u>11/10/08</u>	Time: <u>16:35</u>	Received by: <u>[Signature]</u>	Date: <u>11-6-08</u>	Time: <u>16:35</u>	Standard: <u>[X]</u>	Turn Around Time: <u>[X]</u>	24-hr	48-hr	72-hr	Standard					

Origins Laboratory, Inc.

Noelle E Doyle, Laboratory Manager

The results in this report apply to the samples analyzed in accordance with the chain of custody document. This analytical report must be reproduced in its entirety.

4640 Pecos Street | Unit C
 Denver, Colorado 80211
 303.433.1322 | Laboratory
 303.265.9645 | Fax



LT Environmental, Inc.
 4600 West 60th Avenue
 Arvada CO 80003

Matt Vielhaber
 Project Number: NEP0826.01
 Project: Becky #2-6

MW-1
 X811042-01 (Water)

Analyte	Result	Reporting Limit	Units	Dilution	Batch	Prepared	Analyzed	Notes
---------	--------	-----------------	-------	----------	-------	----------	----------	-------

Origins Laboratory, Inc.

BTEX by EPA 8260B

Benzene	ND	0.00100	mg/L	1	8K14002	11/14/2008	11/15/2008	
Toluene	ND	0.00100	"	"	"	"	"	
Ethylbenzene	ND	0.00100	"	"	"	"	"	
o-Xylene	ND	0.00100	"	"	"	"	"	
m,p-Xylene	ND	0.00200	"	"	"	"	"	

Surrogate: 1,2-Dichloroethane-d4	99.5 %	70.3-123			"	"	"	
Surrogate: Toluene-d8	104 %	75.9-123			"	"	"	
Surrogate: 4-Bromofluorobenzene	120 %	83-123			"	"	"	

Origins Laboratory, Inc.

Noelle E Doyle, Laboratory Manager

The results in this report apply to the samples analyzed in accordance with the chain of custody document. This analytical report must be reproduced in its entirety.

4640 Pecos Street | Unit C
 Denver, Colorado 80211
 303.433.1322 | Laboratory
 303.265.9645 | Fax



LT Environmental, Inc.
 4600 West 60th Avenue
 Arvada CO 80003

Matt Vielhaber
 Project Number: NEP0826.01
 Project: Becky #2-6

MW-3
 X811042-02 (Water)

Analyte	Result	Reporting		Units	Dilution	Batch	Prepared	Analyzed	Notes
		Limit							

Origins Laboratory, Inc.

BTEX by EPA 8260B

Benzene	0.00126	0.00100	mg/L	1	8K14002	11/14/2008	11/15/2008	
Toluene	ND	0.00100	"	"	"	"	"	
Ethylbenzene	ND	0.00100	"	"	"	"	"	
o-Xylene	ND	0.00100	"	"	"	"	"	
m,p-Xylene	ND	0.00200	"	"	"	"	"	

Surrogate: 1,2-Dichloroethane-d4	99.6 %	70.3-123			"	"	"	
Surrogate: Toluene-d8	105 %	75.9-123			"	"	"	
Surrogate: 4-Bromofluorobenzene	119 %	83-123			"	"	"	

Origins Laboratory, Inc.

Noelle E Doyle, Laboratory Manager

The results in this report apply to the samples analyzed in accordance with the chain of custody document. This analytical report must be reproduced in its entirety.

4640 Pecos Street | Unit C
 Denver, Colorado 80211
 303.433.1322 | Laboratory
 303.265.9645 | Fax



LT Environmental, Inc.
 4600 West 60th Avenue
 Arvada CO 80003

Matt Vielhaber
 Project Number: NEP0826.01
 Project: Becky #2-6

MW-4
 X811042-03 (Water)

Analyte	Result	Reporting Limit	Units	Dilution	Batch	Prepared	Analyzed	Notes
---------	--------	-----------------	-------	----------	-------	----------	----------	-------

Origins Laboratory, Inc.

BTEX by EPA 8260B

Benzene	ND	0.00100	mg/L	1	8K14002	11/14/2008	11/15/2008	
Toluene	ND	0.00100	"	"	"	"	"	
Ethylbenzene	ND	0.00100	"	"	"	"	"	
o-Xylene	ND	0.00100	"	"	"	"	"	
m,p-Xylene	ND	0.00200	"	"	"	"	"	

Surrogate: 1,2-Dichloroethane-d4	101 %	70.3-123			"	"	"	
Surrogate: Toluene-d8	104 %	75.9-123			"	"	"	
Surrogate: 4-Bromofluorobenzene	120 %	83-123			"	"	"	

Origins Laboratory, Inc.

The results in this report apply to the samples analyzed in accordance with the chain of custody document. This analytical report must be reproduced in its entirety.

Noelle E Doyle, Laboratory Manager

4640 Pecos Street | Unit C
 Denver, Colorado 80211
 303.433.1322 | Laboratory
 303.265.9645 | Fax



LT Environmental, Inc.
 4600 West 60th Avenue
 Arvada CO 80003

Matt Vielhaber
 Project Number: NEP0826.01
 Project: Becky #2-6

MW-32

X811042-04 (Water)

Analyte	Result	Reporting		Units	Dilution	Batch	Prepared	Analyzed	Notes
		Limit							

Origins Laboratory, Inc.

BTEX by EPA 8260B

Benzene	ND	0.00100	mg/L	1	8K14002	11/14/2008	11/15/2008	
Toluene	ND	0.00100	"	"	"	"	"	
Ethylbenzene	ND	0.00100	"	"	"	"	"	
o-Xylene	ND	0.00100	"	"	"	"	"	
m,p-Xylene	ND	0.00200	"	"	"	"	"	

Surrogate: 1,2-Dichloroethane-d4	99.1 %	70.3-123			"	"	"
Surrogate: Toluene-d8	105 %	75.9-123			"	"	"
Surrogate: 4-Bromofluorobenzene	118 %	83-123			"	"	"

Origins Laboratory, Inc.

The results in this report apply to the samples analyzed in accordance with the chain of custody document. This analytical report must be reproduced in its entirety.

Noelle E Doyle, Laboratory Manager

4640 Pecos Street | Unit C
 Denver, Colorado 80211
 303.433.1322 | Laboratory
 303.265.9645 | Fax



LT Environmental, Inc.
 4600 West 60th Avenue
 Arvada CO 80003

Matt Vielhaber
 Project Number: NEP0826.01
 Project: Becky #2-6

MW-34
 X811042-05 (Water)

Analyte	Result	Reporting Limit	Units	Dilution	Batch	Prepared	Analyzed	Notes
---------	--------	-----------------	-------	----------	-------	----------	----------	-------

Origins Laboratory, Inc.

BTEX by EPA 8260B

Benzene	0.0857	0.00100	mg/L	1	8K14002	11/14/2008	11/15/2008	
Toluene	ND	0.00100	"	"	"	"	"	
Ethylbenzene	0.0894	0.00100	"	"	"	"	"	
o-Xylene	ND	0.00100	"	"	"	"	"	
m,p-Xylene	0.108	0.00200	"	"	"	"	"	

Surrogate: 1,2-Dichloroethane-d4	94.1 %	70.3-123			"	"	"	
Surrogate: Toluene-d8	99.1 %	75.9-123			"	"	"	
Surrogate: 4-Bromofluorobenzene	101 %	83-123			"	"	"	

Origins Laboratory, Inc.

The results in this report apply to the samples analyzed in accordance with the chain of custody document. This analytical report must be reproduced in its entirety.

Noelle E Doyle, Laboratory Manager

4640 Pecos Street | Unit C
 Denver, Colorado 80211
 303.433.1322 | Laboratory
 303.265.9645 | Fax



LT Environmental, Inc.
 4600 West 60th Avenue
 Arvada CO 80003

Matt Vielhaber
 Project Number: NEP0826.01
 Project: Becky #2-6

MW-23
 X811042-06 (Water)

Analyte	Result	Reporting Limit	Units	Dilution	Batch	Prepared	Analyzed	Notes
---------	--------	-----------------	-------	----------	-------	----------	----------	-------

Origins Laboratory, Inc.

BTEX by EPA 8260B

Benzene	0.00146	0.00100	mg/L	1	8K14002	11/14/2008	11/15/2008	
Toluene	ND	0.00100	"	"	"	"	"	
Ethylbenzene	0.00154	0.00100	"	"	"	"	"	
o-Xylene	ND	0.00100	"	"	"	"	"	
m,p-Xylene	ND	0.00200	"	"	"	"	"	

Surrogate: 1,2-Dichloroethane-d4	100 %	70.3-123			"	"	"	
Surrogate: Toluene-d8	105 %	75.9-123			"	"	"	
Surrogate: 4-Bromofluorobenzene	111 %	83-123			"	"	"	

Origins Laboratory, Inc.

Noelle E Doyle, Laboratory Manager

The results in this report apply to the samples analyzed in accordance with the chain of custody document. This analytical report must be reproduced in its entirety.

4640 Pecos Street | Unit C
 Denver, Colorado 80211
 303.433.1322 | Laboratory
 303.265.9645 | Fax



LT Environmental, Inc.
 4600 West 60th Avenue
 Arvada CO 80003

Matt Vielhaber
 Project Number: NEP0826.01
 Project: Becky #2-6

MW-7
X811042-07 (Water)

Analyte	Result	Reporting Limit	Units	Dilution	Batch	Prepared	Analyzed	Notes
---------	--------	-----------------	-------	----------	-------	----------	----------	-------

Origins Laboratory, Inc.

BTEX by EPA 8260B

Benzene	0.725	0.0200	mg/L	20	8K14002	11/14/2008	11/17/2008	
Toluene	ND	0.00100	"	1	"	"	11/15/2008	
Ethylbenzene	0.493	0.0200	"	20	"	"	11/17/2008	
o-Xylene	0.0288	0.00100	"	1	"	"	11/15/2008	
m,p-Xylene	5.98	0.0400	"	20	"	"	11/17/2008	

Surrogate: 1,2-Dichloroethane-d4	83.9 %	70.3-123			"	"	11/15/2008	
Surrogate: Toluene-d8	98.4 %	75.9-123			"	"	"	
Surrogate: 4-Bromofluorobenzene	96.3 %	83-123			"	"	"	

Origins Laboratory, Inc.

Noelle E Doyle, Laboratory Manager

The results in this report apply to the samples analyzed in accordance with the chain of custody document. This analytical report must be reproduced in its entirety.

4640 Pecos Street | Unit C
 Denver, Colorado 80211
 303.433.1322 | Laboratory
 303.265.9645 | Fax



LT Environmental, Inc.
 4600 West 60th Avenue
 Arvada CO 80003

Matt Vielhaber
 Project Number: NEP0826.01
 Project: Becky #2-6

MW-8
 X811042-08 (Water)

Analyte	Result	Reporting Limit	Units	Dilution	Batch	Prepared	Analyzed	Notes
---------	--------	-----------------	-------	----------	-------	----------	----------	-------

Origins Laboratory, Inc.

BTEX by EPA 8260B

Benzene	ND	0.00100	mg/L	1	8K14002	11/14/2008	11/15/2008	
Toluene	ND	0.00100	"	"	"	"	"	
Ethylbenzene	ND	0.00100	"	"	"	"	"	
o-Xylene	ND	0.00100	"	"	"	"	"	
m,p-Xylene	ND	0.00200	"	"	"	"	"	

Surrogate: 1,2-Dichloroethane-d4	98.8 %	70.3-123			"	"	"	
Surrogate: Toluene-d8	103 %	75.9-123			"	"	"	
Surrogate: 4-Bromofluorobenzene	110 %	83-123			"	"	"	

Origins Laboratory, Inc.

Noelle E Doyle, Laboratory Manager

The results in this report apply to the samples analyzed in accordance with the chain of custody document. This analytical report must be reproduced in its entirety.

4640 Pecos Street | Unit C
 Denver, Colorado 80211
 303.433.1322 | Laboratory
 303.265.9645 | Fax



LT Environmental, Inc.
 4600 West 60th Avenue
 Arvada CO 80003

Matt Vielhaber
 Project Number: NEP0826.01
 Project: Becky #2-6

MW-9
 X811042-09 (Water)

Analyte	Result	Reporting Limit	Units	Dilution	Batch	Prepared	Analyzed	Notes
---------	--------	-----------------	-------	----------	-------	----------	----------	-------

Origins Laboratory, Inc.

BTEX by EPA 8260B

Benzene	0.175	0.00100	mg/L	1	8K14002	11/14/2008	11/15/2008	
Toluene	ND	0.00100	"	"	"	"	"	
Ethylbenzene	0.0247	0.00100	"	"	"	"	"	
o-Xylene	ND	0.00100	"	"	"	"	"	
m,p-Xylene	0.0779	0.00200	"	"	"	"	"	

Surrogate: 1,2-Dichloroethane-d4	92.4 %	70.3-123			"	"	"	
Surrogate: Toluene-d8	103 %	75.9-123			"	"	"	
Surrogate: 4-Bromofluorobenzene	102 %	83-123			"	"	"	

Origins Laboratory, Inc.

The results in this report apply to the samples analyzed in accordance with the chain of custody document. This analytical report must be reproduced in its entirety.

Noelle E Doyle, Laboratory Manager

4640 Pecos Street | Unit C
 Denver, Colorado 80211
 303.433.1322 | Laboratory
 303.265.9645 | Fax



LT Environmental, Inc.
 4600 West 60th Avenue
 Arvada CO 80003

Matt Vielhaber
 Project Number: NEP0826.01
 Project: Becky #2-6

MW-24
 X811042-10 (Water)

Analyte	Result	Reporting Limit	Units	Dilution	Batch	Prepared	Analyzed	Notes
---------	--------	-----------------	-------	----------	-------	----------	----------	-------

Origins Laboratory, Inc.

BTEX by EPA 8260B

Benzene	ND	0.00100	mg/L	1	8K14002	11/14/2008	11/15/2008	
Toluene	ND	0.00100	"	"	"	"	"	
Ethylbenzene	ND	0.00100	"	"	"	"	"	
o-Xylene	ND	0.00100	"	"	"	"	"	
m,p-Xylene	0.00627	0.00200	"	"	"	"	"	

Surrogate: 1,2-Dichloroethane-d4	98.2 %	70.3-123			"	"	"	
Surrogate: Toluene-d8	105 %	75.9-123			"	"	"	
Surrogate: 4-Bromofluorobenzene	115 %	83-123			"	"	"	

Origins Laboratory, Inc.

Noelle E Doyle, Laboratory Manager

The results in this report apply to the samples analyzed in accordance with the chain of custody document. This analytical report must be reproduced in its entirety.

4640 Pecos Street | Unit C
 Denver, Colorado 80211
 303.433.1322 | Laboratory
 303.265.9645 | Fax



LT Environmental, Inc.
 4600 West 60th Avenue
 Arvada CO 80003

Matt Vielhaber
 Project Number: NEP0826.01
 Project: Becky #2-6

MW-11
 X811042-11 (Water)

Analyte	Result	Reporting Limit	Units	Dilution	Batch	Prepared	Analyzed	Notes
---------	--------	-----------------	-------	----------	-------	----------	----------	-------

Origins Laboratory, Inc.

BTEX by EPA 8260B

Benzene	ND	0.00100	mg/L	1	8K14002	11/14/2008	11/15/2008	
Toluene	ND	0.00100	"	"	"	"	"	
Ethylbenzene	ND	0.00100	"	"	"	"	"	
o-Xylene	ND	0.00100	"	"	"	"	"	
m,p-Xylene	0.00500	0.00200	"	"	"	"	"	

Surrogate: 1,2-Dichloroethane-d4	99.5 %	70.3-123			"	"	"	
Surrogate: Toluene-d8	104 %	75.9-123			"	"	"	
Surrogate: 4-Bromofluorobenzene	107 %	83-123			"	"	"	

Origins Laboratory, Inc.

Noelle E Doyle, Laboratory Manager

The results in this report apply to the samples analyzed in accordance with the chain of custody document. This analytical report must be reproduced in its entirety.

4640 Pecos Street | Unit C
 Denver, Colorado 80211
 303.433.1322 | Laboratory
 303.265.9645 | Fax



LT Environmental, Inc.
 4600 West 60th Avenue
 Arvada CO 80003

Matt Vielhaber
 Project Number: NEP0826.01
 Project: Becky #2-6

MW-25
 X811042-12 (Water)

Analyte	Result	Reporting		Units	Dilution	Batch	Prepared	Analyzed	Notes
		Limit							

Origins Laboratory, Inc.

BTEX by EPA 8260B

Benzene	0.0475	0.00100	mg/L	1	8K14002	11/14/2008	11/15/2008	
Toluene	ND	0.00100	"	"	"	"	"	
Ethylbenzene	0.00773	0.00100	"	"	"	"	"	
o-Xylene	ND	0.00100	"	"	"	"	"	
m,p-Xylene	0.0288	0.00200	"	"	"	"	"	

Surrogate: 1,2-Dichloroethane-d4	97.6 %	70.3-123			"	"	"	
Surrogate: Toluene-d8	105 %	75.9-123			"	"	"	
Surrogate: 4-Bromofluorobenzene	106 %	83-123			"	"	"	

Origins Laboratory, Inc.

The results in this report apply to the samples analyzed in accordance with the chain of custody document. This analytical report must be reproduced in its entirety.

Noelle E Doyle, Laboratory Manager

4640 Pecos Street | Unit C
 Denver, Colorado 80211
 303.433.1322 | Laboratory
 303.265.9645 | Fax



LT Environmental, Inc.
 4600 West 60th Avenue
 Arvada CO 80003

Matt Vielhaber
 Project Number: NEP0826.01
 Project: Becky #2-6

MW-13
 X811042-13 (Water)

Analyte	Result	Reporting		Units	Dilution	Batch	Prepared	Analyzed	Notes
		Limit							

Origins Laboratory, Inc.

BTEX by EPA 8260B

Benzene	0.684	0.0100	mg/L	10	8K14002	11/14/2008	11/17/2008
Toluene	ND	0.00100	"	1	"	"	11/15/2008
Ethylbenzene	0.0840	0.00100	"	"	"	"	"
o-Xylene	0.00311	0.00100	"	"	"	"	"
m,p-Xylene	0.149	0.00200	"	"	"	"	"

Surrogate: 1,2-Dichloroethane-d4	90.0 %	70.3-123			"	"	"
Surrogate: Toluene-d8	102 %	75.9-123			"	"	"
Surrogate: 4-Bromofluorobenzene	99.6 %	83-123			"	"	"

Origins Laboratory, Inc.

Noelle E Doyle, Laboratory Manager

The results in this report apply to the samples analyzed in accordance with the chain of custody document. This analytical report must be reproduced in its entirety.

4640 Pecos Street | Unit C
 Denver, Colorado 80211
 303.433.1322 | Laboratory
 303.265.9645 | Fax



LT Environmental, Inc.
 4600 West 60th Avenue
 Arvada CO 80003

Matt Vielhaber
 Project Number: NEP0826.01
 Project: Becky #2-6

MW-14
 X811042-14 (Water)

Analyte	Result	Reporting		Units	Dilution	Batch	Prepared	Analyzed	Notes
		Limit							

Origins Laboratory, Inc.

BTEX by EPA 8260B

Benzene	ND	0.00100	mg/L	1	8K14002	11/14/2008	11/15/2008	
Toluene	ND	0.00100	"	"	"	"	"	
Ethylbenzene	ND	0.00100	"	"	"	"	"	
o-Xylene	ND	0.00100	"	"	"	"	"	
m,p-Xylene	ND	0.00200	"	"	"	"	"	

Surrogate: 1,2-Dichloroethane-d4	95.8 %	70.3-123			"	"	"
Surrogate: Toluene-d8	105 %	75.9-123			"	"	"
Surrogate: 4-Bromofluorobenzene	102 %	83-123			"	"	"

Origins Laboratory, Inc.

The results in this report apply to the samples analyzed in accordance with the chain of custody document. This analytical report must be reproduced in its entirety.

Noelle E Doyle, Laboratory Manager

4640 Pecos Street | Unit C
 Denver, Colorado 80211
 303.433.1322 | Laboratory
 303.265.9645 | Fax



LT Environmental, Inc.
 4600 West 60th Avenue
 Arvada CO 80003

Matt Vielhaber
 Project Number: NEP0826.01
 Project: Becky #2-6

MW-26
 X811042-15 (Water)

Analyte	Result	Reporting Limit	Units	Dilution	Batch	Prepared	Analyzed	Notes
---------	--------	-----------------	-------	----------	-------	----------	----------	-------

Origins Laboratory, Inc.

BTEX by EPA 8260B

Benzene	0.0574	0.00100	mg/L	1	8K14002	11/14/2008	11/15/2008	
Toluene	ND	0.00100	"	"	"	"	"	
Ethylbenzene	0.0364	0.00100	"	"	"	"	"	
o-Xylene	ND	0.00100	"	"	"	"	"	
m,p-Xylene	0.0476	0.00200	"	"	"	"	"	

Surrogate: 1,2-Dichloroethane-d4	95.2 %	70.3-123			"	"	"	
Surrogate: Toluene-d8	102 %	75.9-123			"	"	"	
Surrogate: 4-Bromofluorobenzene	99.4 %	83-123			"	"	"	

Origins Laboratory, Inc.

The results in this report apply to the samples analyzed in accordance with the chain of custody document. This analytical report must be reproduced in its entirety.

Noelle E Doyle, Laboratory Manager

4640 Pecos Street | Unit C
 Denver, Colorado 80211
 303.433.1322 | Laboratory
 303.265.9645 | Fax



LT Environmental, Inc.
 4600 West 60th Avenue
 Arvada CO 80003

Matt Vielhaber
 Project Number: NEP0826.01
 Project: Becky #2-6

MW-30
 X811042-16 (Water)

Analyte	Result	Reporting Limit	Units	Dilution	Batch	Prepared	Analyzed	Notes
---------	--------	-----------------	-------	----------	-------	----------	----------	-------

Origins Laboratory, Inc.

BTEX by EPA 8260B

Benzene	ND	0.00100	mg/L	1	8K14002	11/14/2008	11/15/2008	
Toluene	ND	0.00100	"	"	"	"	"	
Ethylbenzene	ND	0.00100	"	"	"	"	"	
o-Xylene	ND	0.00100	"	"	"	"	"	
m,p-Xylene	0.00288	0.00200	"	"	"	"	"	

Surrogate: 1,2-Dichloroethane-d4	102 %	70.3-123			"	"	"	
Surrogate: Toluene-d8	102 %	75.9-123			"	"	"	
Surrogate: 4-Bromofluorobenzene	110 %	83-123			"	"	"	

Origins Laboratory, Inc.

The results in this report apply to the samples analyzed in accordance with the chain of custody document. This analytical report must be reproduced in its entirety.

Noelle E Doyle, Laboratory Manager

4640 Pecos Street | Unit C
 Denver, Colorado 80211
 303.433.1322 | Laboratory
 303.265.9645 | Fax



LT Environmental, Inc.
 4600 West 60th Avenue
 Arvada CO 80003

Matt Vielhaber
 Project Number: NEP0826.01
 Project: Becky #2-6

MW-27

X811042-17 (Water)

Analyte	Result	Reporting Limit	Units	Dilution	Batch	Prepared	Analyzed	Notes
---------	--------	-----------------	-------	----------	-------	----------	----------	-------

Origins Laboratory, Inc.

BTEX by EPA 8260B

Benzene	0.00172	0.00100	mg/L	1	8K14002	11/14/2008	11/15/2008	
Toluene	ND	0.00100	"	"	"	"	"	
Ethylbenzene	ND	0.00100	"	"	"	"	"	
o-Xylene	ND	0.00100	"	"	"	"	"	
m,p-Xylene	0.0184	0.00200	"	"	"	"	"	

Surrogate: 1,2-Dichloroethane-d4	100 %	70.3-123			"	"	"	
Surrogate: Toluene-d8	103 %	75.9-123			"	"	"	
Surrogate: 4-Bromofluorobenzene	116 %	83-123			"	"	"	

Origins Laboratory, Inc.

Noelle E Doyle, Laboratory Manager

The results in this report apply to the samples analyzed in accordance with the chain of custody document. This analytical report must be reproduced in its entirety.

4640 Pecos Street | Unit C
 Denver, Colorado 80211
 303.433.1322 | Laboratory
 303.265.9645 | Fax



LT Environmental, Inc.
 4600 West 60th Avenue
 Arvada CO 80003

Matt Vielhaber
 Project Number: NEP0826.01
 Project: Becky #2-6

MW-15
 X811042-18 (Water)

Analyte	Result	Reporting		Units	Dilution	Batch	Prepared	Analyzed	Notes
		Limit							

Origins Laboratory, Inc.

BTEX by EPA 8260B

Benzene	ND	0.00100	mg/L	1	8K14002	11/14/2008	11/15/2008	
Toluene	ND	0.00100	"	"	"	"	"	
Ethylbenzene	ND	0.00100	"	"	"	"	"	
o-Xylene	ND	0.00100	"	"	"	"	"	
m,p-Xylene	ND	0.00200	"	"	"	"	"	

Surrogate: 1,2-Dichloroethane-d4	96.1 %	70.3-123			"	"	"
Surrogate: Toluene-d8	102 %	75.9-123			"	"	"
Surrogate: 4-Bromofluorobenzene	111 %	83-123			"	"	"

Origins Laboratory, Inc.

Noelle E Doyle, Laboratory Manager

The results in this report apply to the samples analyzed in accordance with the chain of custody document. This analytical report must be reproduced in its entirety.

4640 Pecos Street | Unit C
 Denver, Colorado 80211
 303.433.1322 | Laboratory
 303.265.9645 | Fax



LT Environmental, Inc.
 4600 West 60th Avenue
 Arvada CO 80003

Matt Vielhaber
 Project Number: NEP0826.01
 Project: Becky #2-6

MW-18
 X811042-19 (Water)

Analyte	Result	Reporting Limit	Units	Dilution	Batch	Prepared	Analyzed	Notes
---------	--------	-----------------	-------	----------	-------	----------	----------	-------

Origins Laboratory, Inc.

BTEX by EPA 8260B

Benzene	ND	0.00100	mg/L	1	8K14002	11/14/2008	11/15/2008	
Toluene	ND	0.00100	"	"	"	"	"	
Ethylbenzene	ND	0.00100	"	"	"	"	"	
o-Xylene	ND	0.00100	"	"	"	"	"	
m,p-Xylene	0.00336	0.00200	"	"	"	"	"	

Surrogate: 1,2-Dichloroethane-d4	98.8 %	70.3-123			"	"	"	
Surrogate: Toluene-d8	108 %	75.9-123			"	"	"	
Surrogate: 4-Bromofluorobenzene	105 %	83-123			"	"	"	

Origins Laboratory, Inc.

Noelle E Doyle, Laboratory Manager

The results in this report apply to the samples analyzed in accordance with the chain of custody document. This analytical report must be reproduced in its entirety.

4640 Pecos Street | Unit C
 Denver, Colorado 80211
 303.433.1322 | Laboratory
 303.265.9645 | Fax



LT Environmental, Inc.
 4600 West 60th Avenue
 Arvada CO 80003

Matt Vielhaber
 Project Number: NEP0826.01
 Project: Becky #2-6

MW-29
 X811042-20 (Water)

Analyte	Result	Reporting Limit	Units	Dilution	Batch	Prepared	Analyzed	Notes
---------	--------	-----------------	-------	----------	-------	----------	----------	-------

Origins Laboratory, Inc.

BTEX by EPA 8260B

Benzene	ND	0.00100	mg/L	1	8K14002	11/14/2008	11/15/2008	
Toluene	ND	0.00100	"	"	"	"	"	
Ethylbenzene	ND	0.00100	"	"	"	"	"	
o-Xylene	ND	0.00100	"	"	"	"	"	
m,p-Xylene	ND	0.00200	"	"	"	"	"	

Surrogate: 1,2-Dichloroethane-d4	101 %	70.3-123			"	"	"	
Surrogate: Toluene-d8	103 %	75.9-123			"	"	"	
Surrogate: 4-Bromofluorobenzene	107 %	83-123			"	"	"	

Origins Laboratory, Inc.

Noelle E Doyle, Laboratory Manager

The results in this report apply to the samples analyzed in accordance with the chain of custody document. This analytical report must be reproduced in its entirety.

4640 Pecos Street | Unit C
 Denver, Colorado 80211
 303.433.1322 | Laboratory
 303.265.9645 | Fax



LT Environmental, Inc.
 4600 West 60th Avenue
 Arvada CO 80003

Matt Vielhaber
 Project Number: NEP0826.01
 Project: Becky #2-6

MW-17
 X811042-21 (Water)

Analyte	Result	Reporting Limit	Units	Dilution	Batch	Prepared	Analyzed	Notes
---------	--------	-----------------	-------	----------	-------	----------	----------	-------

Origins Laboratory, Inc.

BTEX by EPA 8260B

Benzene	ND	0.00100	mg/L	1	8K14002	11/14/2008	11/15/2008	
Toluene	ND	0.00100	"	"	"	"	"	
Ethylbenzene	ND	0.00100	"	"	"	"	"	
o-Xylene	ND	0.00100	"	"	"	"	"	
m,p-Xylene	ND	0.00200	"	"	"	"	"	

Surrogate: 1,2-Dichloroethane-d4	99.8 %	70.3-123			"	"	"	
Surrogate: Toluene-d8	102 %	75.9-123			"	"	"	
Surrogate: 4-Bromofluorobenzene	114 %	83-123			"	"	"	

Origins Laboratory, Inc.

Noelle E Doyle, Laboratory Manager

The results in this report apply to the samples analyzed in accordance with the chain of custody document. This analytical report must be reproduced in its entirety.



LT Environmental, Inc.
 4600 West 60th Avenue
 Arvada CO 80003

Matt Vielhaber
 Project Number: NEP0826.01
 Project: Becky #2-6

Volatile Organic Compounds by EPA Method 8260B – Quality Control
Origins Laboratory, Inc.

Analyte	Result	Reporting Limit	Units	Spike Level	Source Result	%REC	%REC Limits	RPD	RPD Limit	Notes
---------	--------	-----------------	-------	-------------	---------------	------	-------------	-----	-----------	-------

Batch 8K14002 – EPA 5030B

Blank (8K14002-BLK1)

Prepared: 11/14/2008 Analyzed: 11/15/2008

Benzene	ND	0.001	mg/L							
Toluene	ND	0.001	"							
Ethylbenzene	ND	0.001	"							
o-Xylene	ND	0.001	"							
m,p-Xylene	ND	0.002	"							
<i>Surrogate: 1,2-Dichloroethane-d4</i>	<i>61.4</i>		<i>ug/L</i>	<i>62.5</i>		<i>98.3</i>	<i>70.3-123</i>			
<i>Surrogate: Toluene-d8</i>	<i>66.8</i>		<i>"</i>	<i>62.5</i>		<i>107</i>	<i>75.9-123</i>			
<i>Surrogate: 4-Bromofluorobenzene</i>	<i>74.8</i>		<i>"</i>	<i>62.5</i>		<i>120</i>	<i>83-123</i>			

Blank (8K14002-BLK2)

Prepared: 11/14/2008 Analyzed: 11/15/2008

Benzene	ND	0.001	mg/L							
Toluene	ND	0.001	"							
Ethylbenzene	ND	0.001	"							
o-Xylene	ND	0.001	"							
m,p-Xylene	ND	0.002	"							
<i>Surrogate: 1,2-Dichloroethane-d4</i>	<i>60.0</i>		<i>ug/L</i>	<i>62.5</i>		<i>95.9</i>	<i>70.3-123</i>			
<i>Surrogate: Toluene-d8</i>	<i>67.3</i>		<i>"</i>	<i>62.5</i>		<i>108</i>	<i>75.9-123</i>			
<i>Surrogate: 4-Bromofluorobenzene</i>	<i>77.0</i>		<i>"</i>	<i>62.5</i>		<i>123</i>	<i>83-123</i>			

LCS (8K14002-BS1)

Prepared: 11/14/2008 Analyzed: 11/15/2008

Benzene	0.05	0.001	mg/L	0.0500		96.7	64.2-124			
Toluene	0.06	0.001	"	0.0500		113	63.9-119			
<i>Surrogate: 1,2-Dichloroethane-d4</i>	<i>60.4</i>		<i>ug/L</i>	<i>62.5</i>		<i>96.7</i>	<i>70.3-123</i>			
<i>Surrogate: Toluene-d8</i>	<i>66.2</i>		<i>"</i>	<i>62.5</i>		<i>106</i>	<i>75.9-123</i>			
<i>Surrogate: 4-Bromofluorobenzene</i>	<i>72.2</i>		<i>"</i>	<i>62.5</i>		<i>115</i>	<i>83-123</i>			

LCS (8K14002-BS2)

Prepared: 11/14/2008 Analyzed: 11/15/2008

Benzene	0.05	0.001	mg/L	0.0500		105	64.2-124			
Toluene	0.04	0.001	"	0.0500		86.2	63.9-119			

Origins Laboratory, Inc.

The results in this report apply to the samples analyzed in accordance with the chain of custody document. This analytical report must be reproduced in its entirety.



LT Environmental, Inc.
 4600 West 60th Avenue
 Arvada CO 80003

Matt Vielhaber
 Project Number: NEP0826.01
 Project: Becky #2-6

Volatile Organic Compounds by EPA Method 8260B - Quality Control
Origins Laboratory, Inc.

Analyte	Result	Reporting Limit	Units	Spike Level	Source Result	%REC	%REC Limits	RPD	RPD Limit	Notes
Batch 8K14002 - EPA 5030B										
LCS (8K14002-BS2)					Prepared: 11/14/2008 Analyzed: 11/15/2008					
Surrogate: 1,2-Dichloroethane-d4	61.2		ug/L	62.5		97.9	70.3-123			
Surrogate: Toluene-d8	67.1		"	62.5		107	75.9-123			
Surrogate: 4-Bromofluorobenzene	73.0		"	62.5		117	83-123			
Matrix Spike (8K14002-MS1)					Source: X811038-06		Prepared: 11/14/2008 Analyzed: 11/15/2008			
Benzene	0.05	0.001	mg/L	0.0500	ND	97.8	64.2-124			
Toluene	0.06	0.001	"	0.0500	ND	111	63.9-119			
Surrogate: 1,2-Dichloroethane-d4	61.4		ug/L	62.5		98.2	70.3-123			
Surrogate: Toluene-d8	66.8		"	62.5		107	75.9-123			
Surrogate: 4-Bromofluorobenzene	73.9		"	62.5		118	83-123			
Matrix Spike (8K14002-MS2)					Source: X811038-07		Prepared: 11/14/2008 Analyzed: 11/15/2008			
Benzene	0.05	0.001	mg/L	0.0500	ND	94.6	64.2-124			
Toluene	0.06	0.001	"	0.0500	ND	110	63.9-119			
Surrogate: 1,2-Dichloroethane-d4	60.9		ug/L	62.5		97.5	70.3-123			
Surrogate: Toluene-d8	67.1		"	62.5		107	75.9-123			
Surrogate: 4-Bromofluorobenzene	72.5		"	62.5		116	83-123			
Matrix Spike Dup (8K14002-MSD1)					Source: X811038-06		Prepared: 11/14/2008 Analyzed: 11/15/2008			
Benzene	0.05	0.001	mg/L	0.0500	ND	97.0	64.2-124	0.780	25	
Toluene	0.05	0.001	"	0.0500	ND	110	63.9-119	1.61	25	
Surrogate: 1,2-Dichloroethane-d4	60.7		ug/L	62.5		97.2	70.3-123			
Surrogate: Toluene-d8	66.9		"	62.5		107	75.9-123			
Surrogate: 4-Bromofluorobenzene	72.7		"	62.5		116	83-123			
Matrix Spike Dup (8K14002-MSD2)					Source: X811038-07		Prepared: 11/14/2008 Analyzed: 11/15/2008			
Benzene	0.05	0.001	mg/L	0.0500	ND	95.4	64.2-124	0.842	25	
Toluene	0.05	0.001	"	0.0500	ND	107	63.9-119	2.88	25	
Surrogate: 1,2-Dichloroethane-d4	60.9		ug/L	62.5		97.4	70.3-123			

Origins Laboratory, Inc.

Noelle E Doyle, Laboratory Manager

The results in this report apply to the samples analyzed in accordance with the chain of custody document. This analytical report must be reproduced in its entirety.

4640 Pecos Street | Unit C
Denver, Colorado 80211
303.433.1322 | Laboratory
303.265.9645 | Fax



LT Environmental, Inc.
4600 West 60th Avenue
Arvada CO 80003

Matt Vielhaber
Project Number: NEP0826.01
Project: Becky #2-6

Volatile Organic Compounds by EPA Method 8260B – Quality Control
Origins Laboratory, Inc.

Analyte	Result	Reporting Limit	Units	Spike Level	Source Result	%REC	%REC Limits	RPD	RPD Limit	Notes
---------	--------	-----------------	-------	-------------	---------------	------	-------------	-----	-----------	-------

Batch 8K14002 – EPA 5030B

Matrix Spike Dup (8K14002-MSD2)

Source: X811038-07

Prepared: 11/14/2008 Analyzed: 11/15/2008

Surrogate: Toluene-d8	66.4		ug/L	62.5	106	75.9-123
Surrogate: 4-Bromofluorobenzene	72.3		"	62.5	116	83-123

Origins Laboratory, Inc.

Noelle E Doyle, Laboratory Manager

The results in this report apply to the samples analyzed in accordance with the chain of custody document. This analytical report must be reproduced in its entirety.

4640 Pecos Street | Unit C
Denver, Colorado 80211
303.433.1322 | Laboratory
303.265.9645 | Fax



LT Environmental, Inc.
4600 West 60th Avenue
Arvada CO 80003

Matt Vielhaber
Project Number: NEP0826.01
Project: Becky #2-6

Notes and Definitions

ND Analyte NOT DETECTED at or above the reporting limit
RPD Relative Percent Difference

Origins Laboratory, Inc.

The results in this report apply to the samples analyzed in accordance with the chain of custody document. This analytical report must be reproduced in its entirety.

Noelle E Doyle, Laboratory Manager



4640 Pecos Street | Unit C | Denver, Colorado 80211
303.433.1322 Phone 303.265.9645 Fax

November 18, 2008

LT Environmental, Inc.
4600 West 60th Avenue
Arvada CO 80003

Matt Vielhaber
Project Number: NEP0826.01
Project: Becky #2-6

Attached are the analytical results for Becky #2-6 received by Origins Laboratory, Inc. 11/14/2008 2:28:00PM. Please let us know if you have any questions, or if we can help with anything at all.

A handwritten signature in black ink, appearing to read "Noelle E Doyle".

Laboratory Manager

Noelle E Doyle

The analytical results in the following report were analyzed under the guidelines of EPA Methods specified in SW-846. The analytical results apply specifically to the samples and analyses specified per the attached Chain of Custody. This laboratory report is intended solely for the above addressee and it is only to be used and or reproduced in its entirety.

4640 Pecos Street | Unit C
Denver, Colorado 80211
303.433.1322 | Laboratory
303.265.9645 | Fax



LT Environmental, Inc.
4600 West 60th Avenue
Arvada CO 80003

Matt Vielhaber
Project Number: NEP0826.01
Project: Becky #2-6

CROSS REFERENCE REPORT

Laboratory ID	Sample ID	Matrix	Sampled	Date Received
MW16	X811060-01	Water	11/13/2008 9:00:00AM	11/14/2008 14:28

Origins Laboratory, Inc.

Noelle E Doyle, Laboratory Manager

The results in this report apply to the samples analyzed in accordance with the chain of custody document. This analytical report must be reproduced in its entirety.

4640 Pecos Street | Unit C
 Denver, Colorado 80211
 303.433.1322 | Laboratory
 303.265.9645 | Fax



LT Environmental, Inc.
 4600 West 60th Avenue
 Arvada CO 80003

Matt Vielhaber
 Project Number: NEP0826.01
 Project: Becky #2-6

MW16
X811060-01 (Water)

Analyte	Result	Reporting Limit	Units	Dilution	Batch	Prepared	Analyzed	Notes
---------	--------	-----------------	-------	----------	-------	----------	----------	-------

Origins Laboratory, Inc.

BTEX by EPA 8260B

Benzene	ND	0.00100	mg/L	1	8K15002	11/15/2008	11/17/2008	
Toluene	ND	0.00100	"	"	"	"	"	
Ethylbenzene	ND	0.00100	"	"	"	"	"	
o-Xylene	0.00686	0.00100	"	"	"	"	"	
m,p-Xylene	0.214	0.00200	"	"	"	"	"	

Surrogate: 1,2-Dichloroethane-d4	106 %	70.3-123			"	"	11/17/2008	
Surrogate: Toluene-d8	101 %	75.9-123			"	"	"	
Surrogate: 4-Bromofluorobenzene	104 %	83-123			"	"	"	

Origins Laboratory, Inc.

Noelle E Doyle, Laboratory Manager

The results in this report apply to the samples analyzed in accordance with the chain of custody document. This analytical report must be reproduced in its entirety.

4640 Pecos Street | Unit C
 Denver, Colorado 80211
 303.433.1322 | Laboratory
 303.265.9645 | Fax



LT Environmental, Inc.
 4600 West 60th Avenue
 Arvada CO 80003

Matt Vielhaber
 Project Number: NEP0826.01
 Project: Becky #2-6

Volatile Organic Compounds by EPA Method 8260B – Quality Control
Origins Laboratory, Inc.

Analyte	Result	Reporting Limit	Units	Spike Level	Source Result	%REC	%REC Limits	RPD	RPD Limit	Notes
Batch 8K15002 – EPA 50308										
Blank (8K15002-BLK1)				Prepared: 11/15/2008 Analyzed: 11/18/2008						
Benzene	ND	0.001	mg/L							
Toluene	ND	0.001	"							
Ethylbenzene	ND	0.001	"							
o-Xylene	ND	0.001	"							
m,p-Xylene	ND	0.002	"							
Surrogate: 1,2-Dichloroethane-d4	63.8		ug/L	62.5		102	70.3-123			
Surrogate: Toluene-d8	62.5		"	62.5		100	75.9-123			
Surrogate: 4-Bromofluorobenzene	65.5		"	62.5		105	83-123			
LCS (8K15002-BS1)				Prepared: 11/15/2008 Analyzed: 11/16/2008						
Benzene	0.06	0.001	mg/L	0.0500		115	64.2-124			
Toluene	0.06	0.001	"	0.0500		119	63.9-119			
Surrogate: 1,2-Dichloroethane-d4	65.6		ug/L	62.5		105	70.3-123			
Surrogate: Toluene-d8	63.6		"	62.5		102	75.9-123			
Surrogate: 4-Bromofluorobenzene	63.1		"	62.5		101	83-123			
Matrix Spike (8K15002-MS1)				Source: X811059-01		Prepared: 11/15/2008 Analyzed: 11/16/2008				
Benzene	0.06	0.001	mg/L	0.0500	0.006	106	64.2-124			
Toluene	0.05	0.001	"	0.0500	0.0007	108	63.9-119			
Surrogate: 1,2-Dichloroethane-d4	65.0		ug/L	62.5		104	70.3-123			
Surrogate: Toluene-d8	63.3		"	62.5		101	75.9-123			
Surrogate: 4-Bromofluorobenzene	63.9		"	62.5		102	83-123			
Matrix Spike Dup (8K15002-MSD1)				Source: X811059-01		Prepared: 11/15/2008 Analyzed: 11/16/2008				
Benzene	0.06	0.001	mg/L	0.0500	0.006	98.2	64.2-124	6.51	25	
Toluene	0.05	0.001	"	0.0500	0.0007	102	63.9-119	5.98	25	
Surrogate: 1,2-Dichloroethane-d4	64.5		ug/L	62.5		103	70.3-123			
Surrogate: Toluene-d8	63.7		"	62.5		102	75.9-123			
Surrogate: 4-Bromofluorobenzene	63.0		"	62.5		101	83-123			

Origins Laboratory, Inc.

Noelle E Doyle, Laboratory Manager

The results in this report apply to the samples analyzed in accordance with the chain of custody document. This analytical report must be reproduced in its entirety.

4640 Pecos Street | Unit C
Denver, Colorado 80211
303.433.1322 | Laboratory
303.265.9645 | Fax



LT Environmental, Inc.
4600 West 60th Avenue
Arvada CO 80003

Matt Vielhaber
Project Number: NEP0826.01
Project: Becky #2-6

Notes and Definitions

ND Analyte NOT DETECTED at or above the reporting limit
RPD Relative Percent Difference

Origins Laboratory, Inc.

A handwritten signature in black ink, appearing to read "Noelle E Doyle".

Noelle E Doyle, Laboratory Manager

The results in this report apply to the samples analyzed in accordance with the chain of custody document. This analytical report must be reproduced in its entirety.