

7761 Shaffer Parkway  
Suite 100  
Littleton, CO 80127

303.792.5555 PHONE  
303.792.0122 FAX

www.TRCSolutions.com

May 6, 2009

Mr. Steven Lindblom, P.G.  
On-Site Inspection Specialist  
Colorado Oil and Gas Conservation Commission  
1120 Lincoln Street, Suite 801  
Denver, CO 80203

RE: Pan Energy Project – Fort Lupton Compressor Station Well Relocation  
COGCC Remediation No. 17

Dear Mr. Lindblom:

TRC proposes to replace two ground water monitoring wells (MWO6 and MWO7) at the Fort Lupton Compressor Station that were plugged and abandoned on November 3, 2008. The wells were abandoned at the request of Anadarko Petroleum Corporation, the facility owner/operator, due to their proximity to an above ground pipeline being constructed at the site. Pipeline construction was completed in March 2009. TRC proposes to construct these replacement wells to the east of the original locations, just outside the new pipeline corridor. Attached is a site plan showing the locations of the abandoned wells and the proposed replacement wells, well construction logs for the abandoned wells, and well construction logs for the proposed replacement wells.

Upon your approval of the location and construction details, TRC will install the replacement wells. If you have any questions, please feel free to call me at 303-395-4021. I look forward to hearing from you.


Sincerely,

A handwritten signature in blue ink, appearing to read 'S Reed', is written over a light blue horizontal line.

Scott Reed, Principal


cc: Greg Groene  
Trey Whitley

Attachments: Site Plan Showing Proposed Well Locations  
Constructions Logs for Abandoned Wells MWO6 and MWO7  
Constructions Logs for Proposed Wells MWO6R and MWO7R

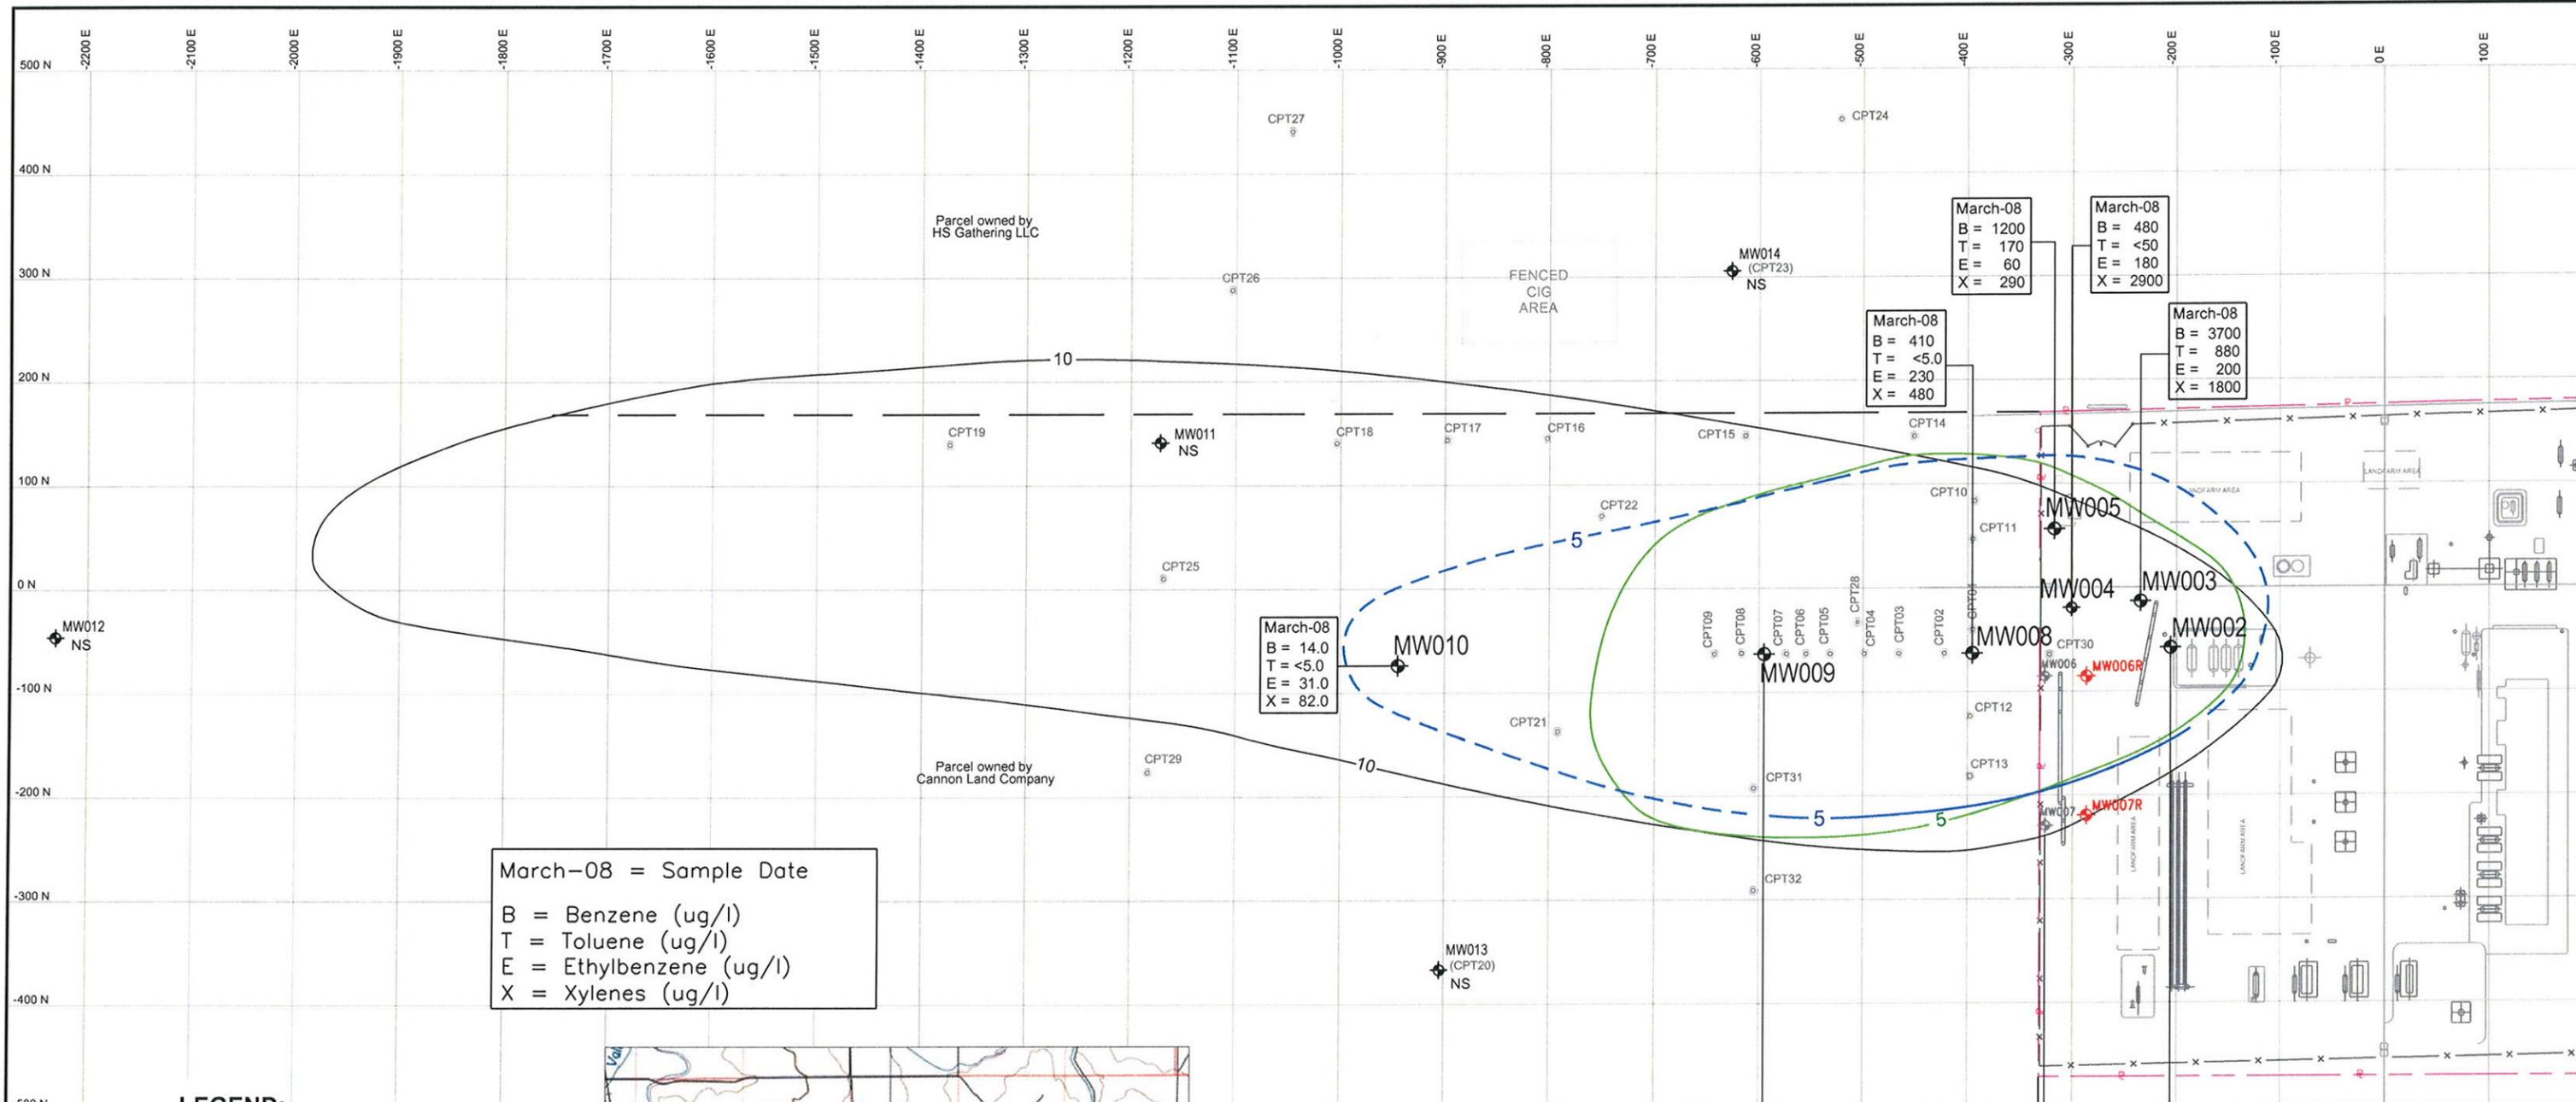


March-08 = Sample Date  
 B = Benzene (ug/l)  
 T = Toluene (ug/l)  
 E = Ethylbenzene (ug/l)  
 X = Xylenes (ug/l)

- LEGEND:**
- MW009 MONITORING WELL SAMPLED - 2008
  - MW012 MONITORING WELL NOT SAMPLED - 2008
  - MW006 MONITORING WELL PLUGGED & ABANDONED
  - MW006R PROPOSED MONITORING WELL
  - CPT13 CPT PROBE
  - NS NOT SAMPLED
  - PROPERTY LINE
  - APPROXIMATE PARCEL BOUNDARY
  - FENCE
  - BUILDING, STRUCTURE OR EQUIPMENT
  - FORMER LANDFARM AREA
  - RECOVERY TRENCH
  - 1997 BENZENE ISOCONCENTRATION CONTOUR (10 ug/L)
  - 2003/2004 BENZENE ISOCONCENTRATION CONTOUR (5 ug/L)
  - 2008 BENZENE ISOCONCENTRATION CONTOUR (5 ug/L)  
DASHED WHERE INFERRED

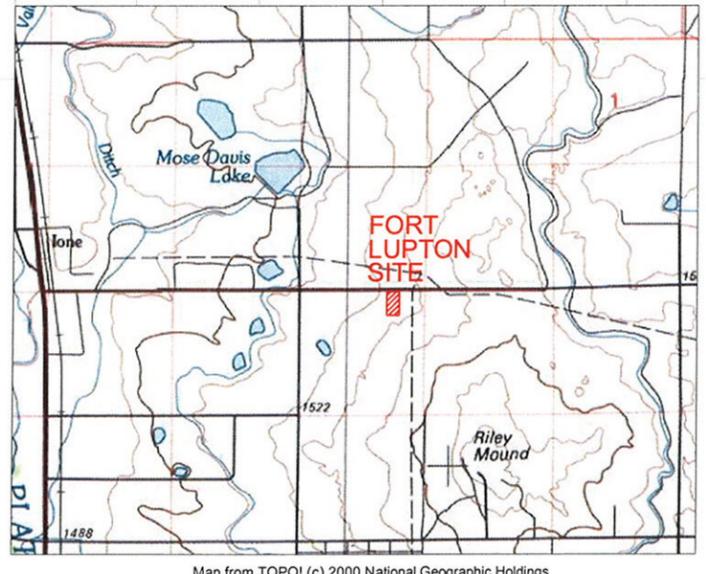

Map from TOPO! (c) 2000 National Geographic Holdings  
**LOCATION MAP**  
 SECTION 14  
 T2N, R66W

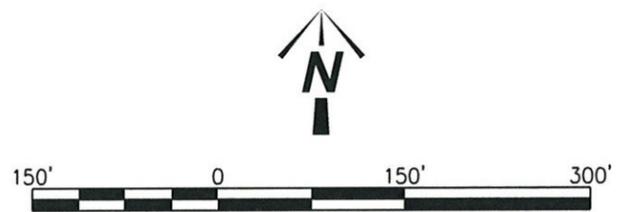

NOTE: THIS SITE MAP DEVELOPED FROM WALSH ENVIRONMENTAL SCIENTISTS AND ENGINEERS BASE MAP. SCANNED BY DDS INC. JANUARY 2002.

March-08  
 B = 1200  
 T = 170  
 E = 60  
 X = 290

March-08  
 B = 480  
 T = <50  
 E = 180  
 X = 2900

March-08  
 B = 410  
 T = <5.0  
 E = 230  
 X = 480

March-08  
 B = 3700  
 T = 880  
 E = 200  
 X = 1800

March-08  
 B = 14.0  
 T = <5.0  
 E = 31.0  
 X = 82.0

March-08  
 B = 650  
 T = <250  
 E = <25  
 X = 3400

March-08  
 B = 3.40  
 T = <5.00  
 E = 0.53  
 X = <1.50


March-08  
 B = 17,000  
 T = <500  
 E = 440  
 X = 6800

CLIENT/PROJECT:		<b>PAN ENERGY CORP</b>		
		<b>FORT LUPTON COMPRESSOR STATION</b>		
		<b>COGCC REMEDIATION NO. 17</b>		
		<b>Section 14, T.2 N., R.66 W.</b>		
		<b>WELD COUNTY, COLORADO</b>		
TITLE:		<b>PROPOSED WELL LOCATIONS - 2009</b>		
	7761 Shoffer Parkway Suite 100 Littleton, CO 80127 Phone 303-792-5555	DRAWN BY: KS REVIEWED BY: MF APPROVED BY: SR	DATE: 05/5/09 PROJECT NO.: 105521 FILE: Proposed Wells-2009.dwg	FIGURE: <b>1</b>

**WELL COMPLETION INFORMATION**  
**PANHANDLE EASTERN PIPELINE CORPORATION**  
**WATTENBERG GATHERING SYSTEM**

FACILITY Fl. Lupton  
 WELL NO. FL-KW06  
 INSTALL. DATE 3/11/93  
 BOREHOLE DIAM. 8"  
 RISER LENGTH 7'  
 SCREEN LENGTH 10'  
 SCREENED INT. 15'-10'


DRILLER Site Services Inc  
 PROT. CSG. CONST. Steel  
 RISER CONST. PVC-2"  
 SCREEN CONST PVC-2"  
 FILTER PACK Sand  
 GROUT MIXTURE Cement  
 SEAL MATERIAL Bentonite Cements

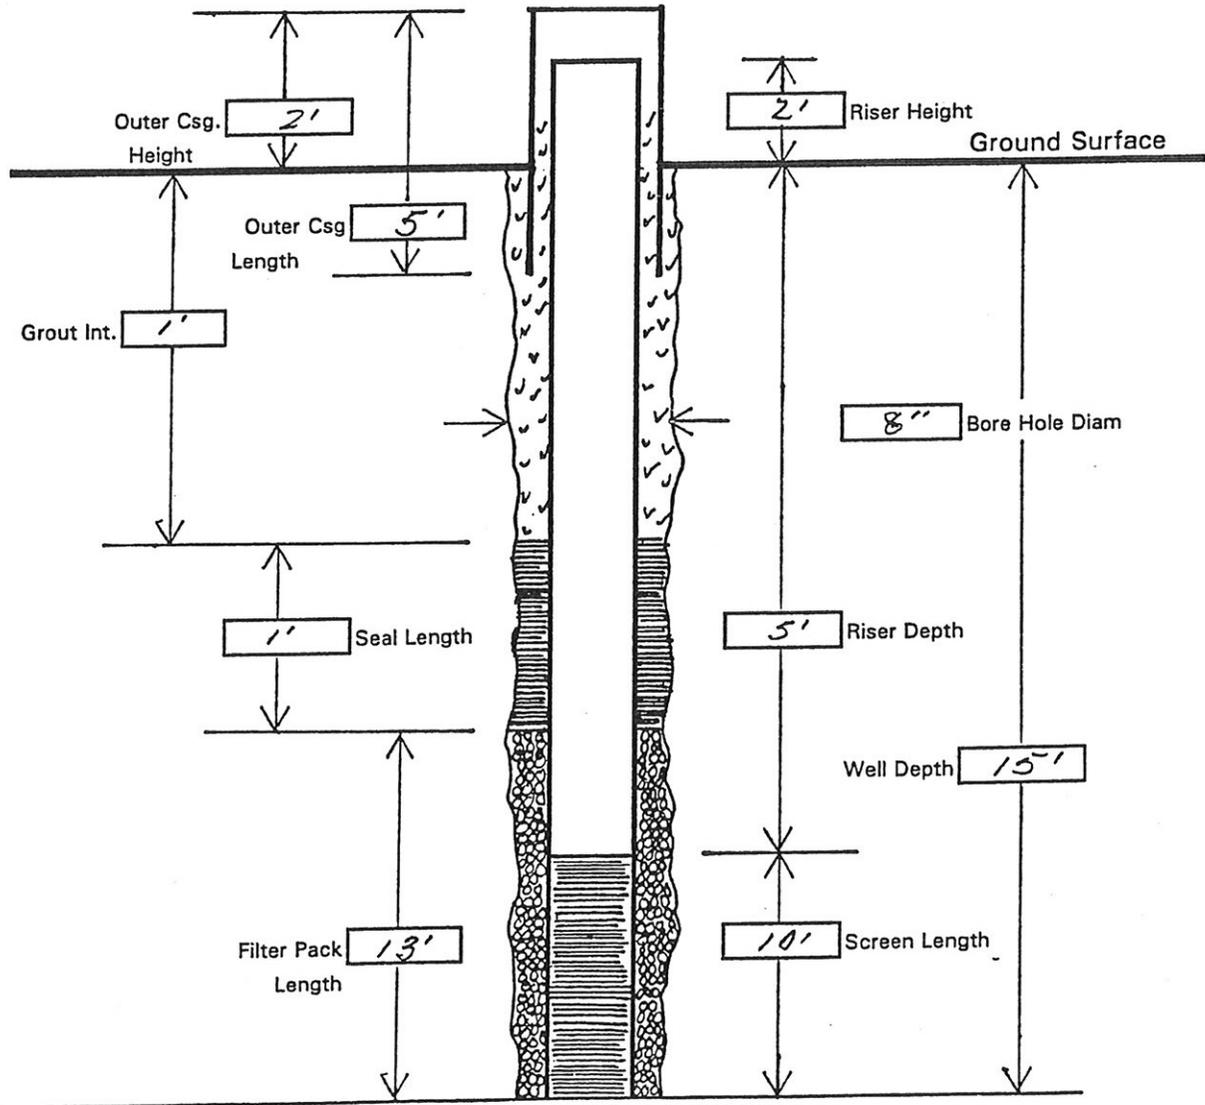

**WELL COMPLETION INFORMATION**  
**PANHANDLE EASTERN PIPELINE CORPORATION**  
**WATTENBERG GATHERING SYSTEM**

FACILITY Ft. Lupton  
 WELL NO. FL-MW07  
 INSTALL. DATE 3/11/93  
 BOREHOLE DIAM. 8"  
 RISER LENGTH 7'  
 SCREEN LENGTH 15'  
 SCREENED INT. 20'-5"

DRILLER Site Services Inc  
 PROT. CSG. CONST. Steel  
 RISER CONST. PVC-2"  
 SCREEN CONST. PVC-2"  
 FILTER PACK Sand  
 GROUT MIXTURE Cement  
 SEAL MATERIAL Bentonite Cements

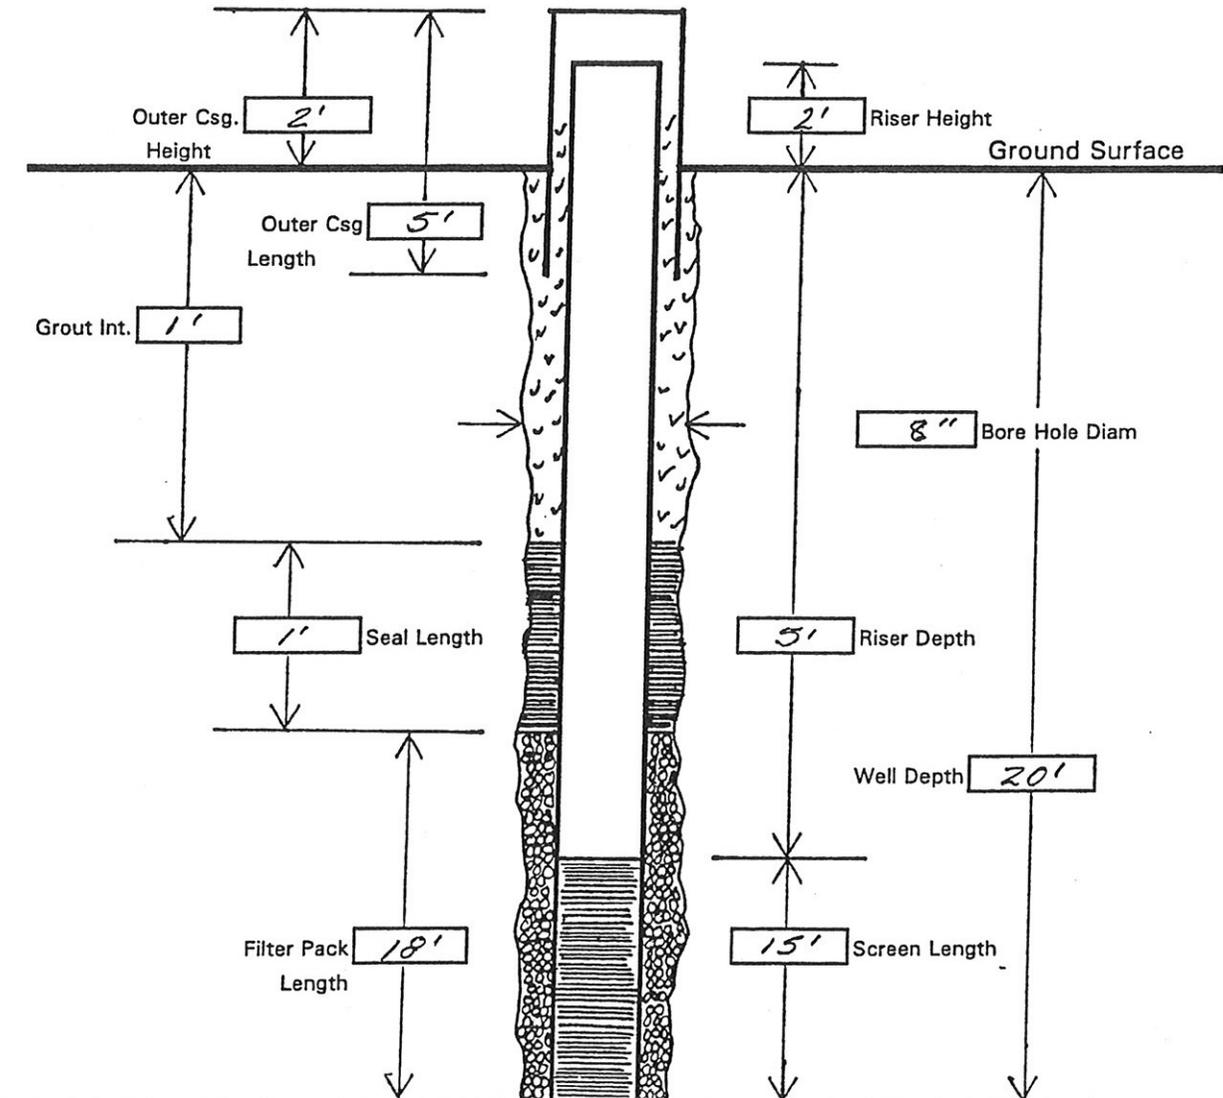


Project No.: 164519 Client: Anadarko Site: Ft. Lupton

WELL NO: MW006R

Well Location: \_\_\_\_\_ Date Installed: \_\_\_\_\_

Drilling Contractor: Site Services Drilling Method: Direct Push

## PROPOSED MONITORING WELL CONSTRUCTION DETAIL

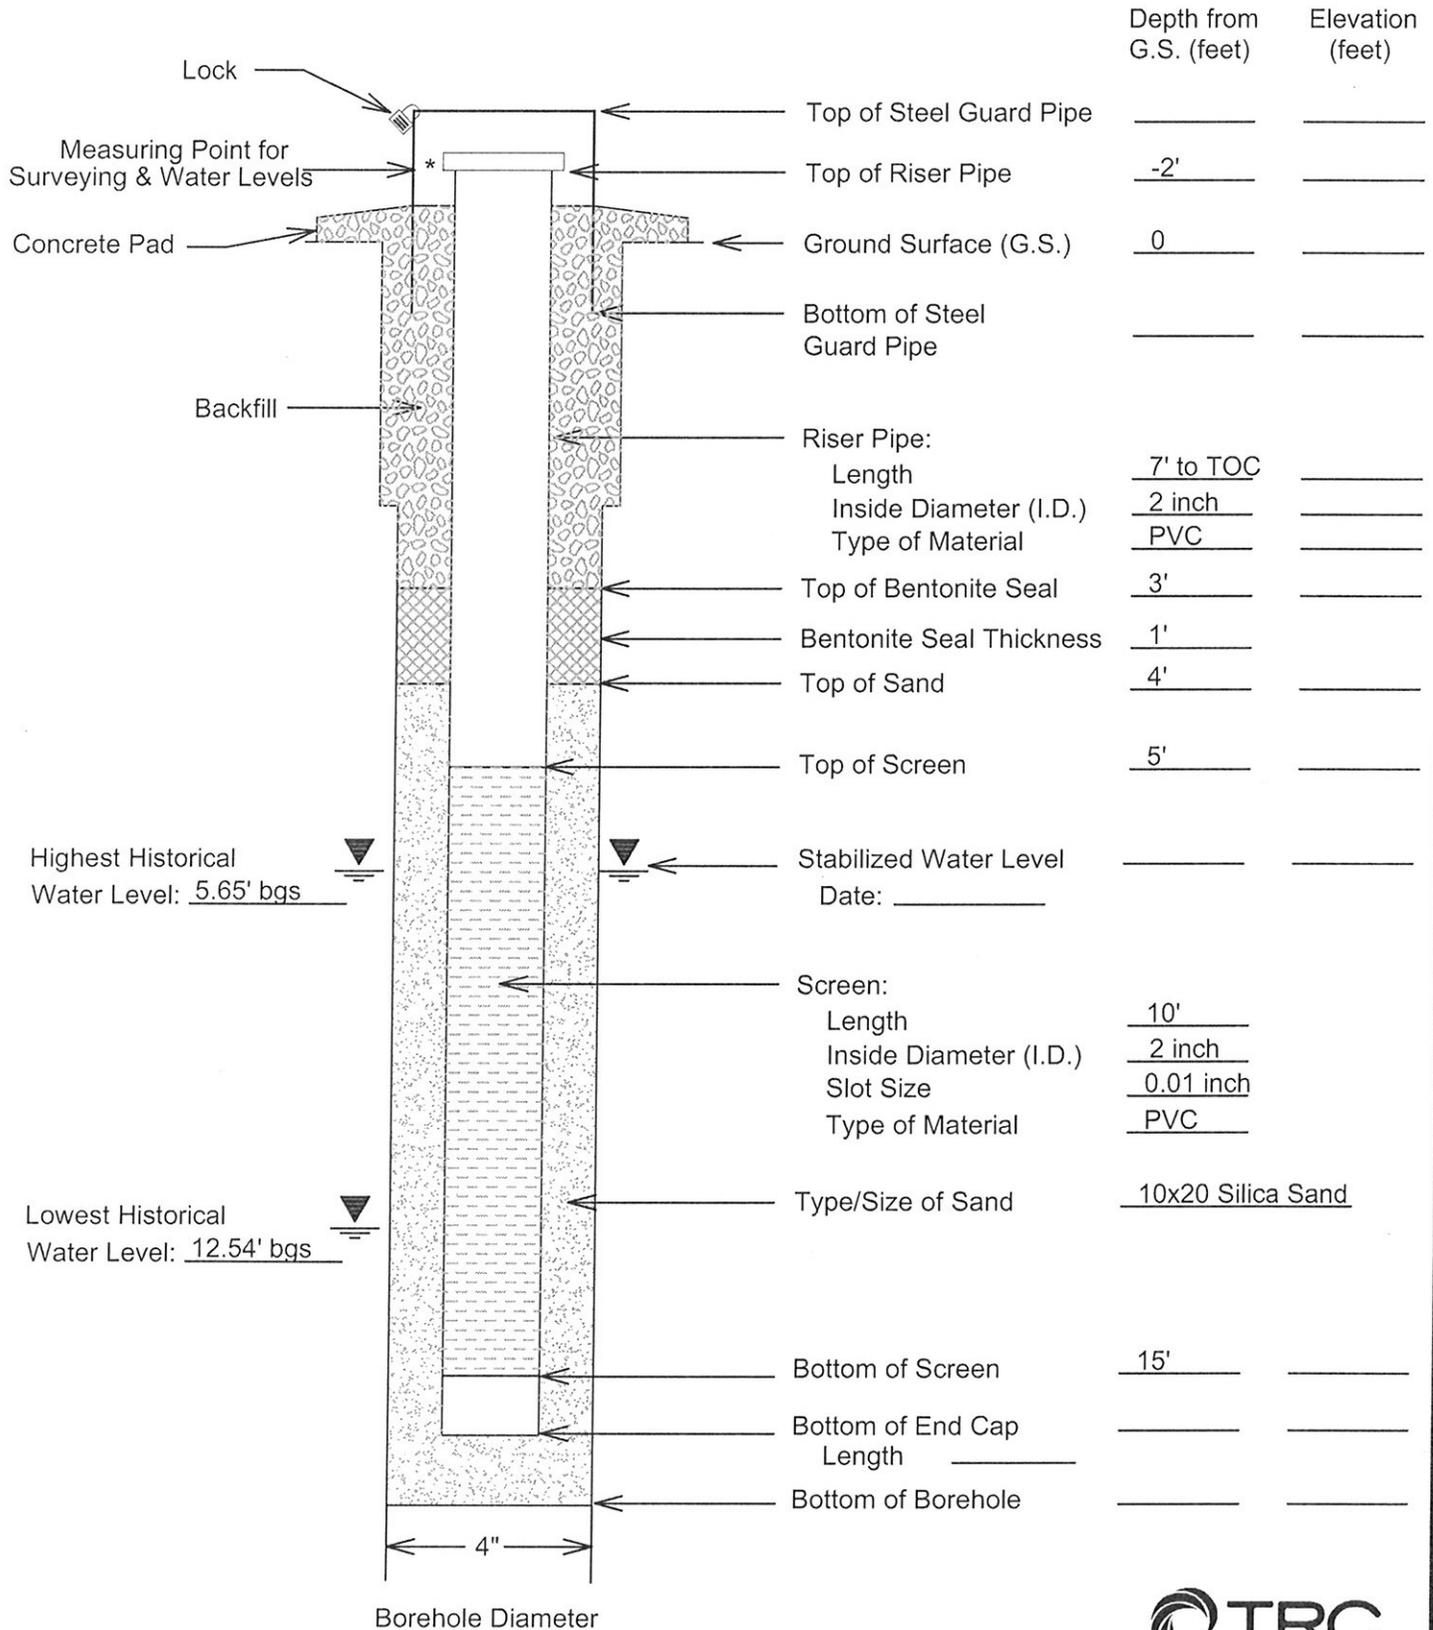

Project No.: 164519 Client: Anadarko Site: Ft. Lupton WELL NO: MW007R

Well Location: \_\_\_\_\_ Date Installed: \_\_\_\_\_

Drilling Contractor: Site Services Drilling Method: Direct Push

## PROPOSED MONITORING WELL CONSTRUCTION DETAIL

