

---

---

## **Appendix B**

### **Phase II Pit Status Evaluation Forms and Photographs**


---

**PIT STATUS EVALUATION FORM**

Facility ID: 111242

Pit Name: WHITEHEAD 11-20

Duplicate Record(s) Pit #

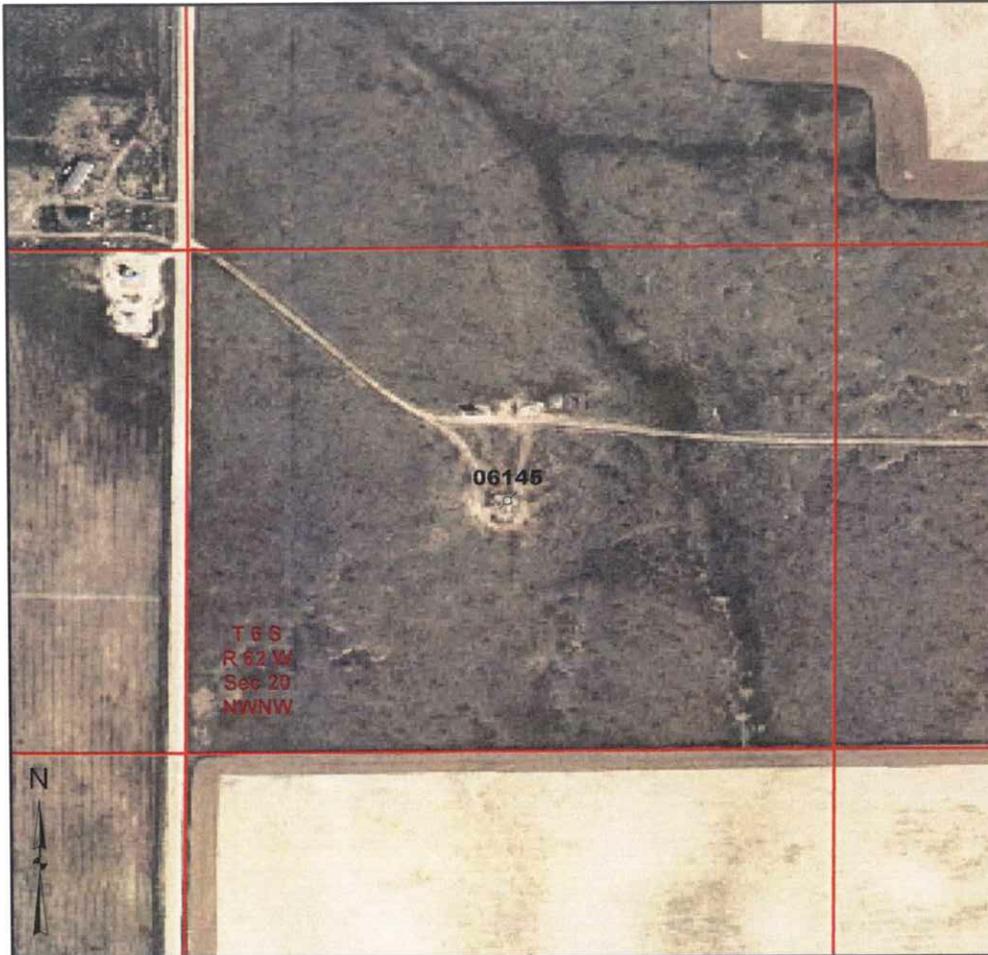

**Legend**

- Producing or Shut In Well
- ⊗ Temp Aban Well
- ⊗ Abandoned Well
- ⊗ Dry & Aban Well
- Earthen Pit
- Culvert
- \* Backfilled Pit(s)
- Vault
- Fiberglass Tank
- Steel Tank(s)
- | Separator
- Wellhead
- Earthen Pit Extent
- Area of Disturbance
- Backfilled Pit Extent
- - - - Tank Fence

1:6,000

Feet

0    250    500    750

Image Source:  
USDA National Agricultural Imagery Program (NAIP), 2006

S.S. PAPANOPULOS & ASSOCIATES, INC.

**COGCC Database Information**

Status: NR    Owner: K P KAUFFMAN COMPANY INC  
 T: 6S    R: 62W    Sec: 20    QQ: NWNW    6th Meridian  
 Latitude: 39.518767    Longitude: -104.364382    NAD83

County: Elbert, CO  
 County Code: 039

**Pit Status Evaluation**

- Active**
- Form 15: Pit Permit #581089 (1976) existing & #846303 (1998) existing Assoc. Well Seq No(s) \_\_\_\_\_
  - Other documentation \_\_\_\_\_
  - Aerial photo verification \_\_\_\_\_
- Closed**
- Form 27: Remediation Workplan \_\_\_\_\_
  - Form 4: Sundry Notice \_\_\_\_\_
  - Rule 903a.(2)B \_\_\_\_\_
  - Evidence pit(s) existed, no closure docs & well not PR, AC or SI  
 Well API Seq #(s) 06145 PA (9-28-2007) doc# 1925331 (10-15-2007) *aband. report*
  - Other documentation \_\_\_\_\_
- Abandoned**     Possible un-reclaimed pit(s) or adverse conditions, no closure docs     Site Visit
- Unknown**     No Site Visit     Add'l Review

Notes: No final site inspection forms online from 2008 (post PA'D)  
Field Inspection 6-3-2008: Site has been P&A'd; reclamation complete.



**Photo 1. Looking northeast towards reclaimed pit site**



**Photo 2. Looking northwest towards nearest building**



**Photo 3. Looking south towards plugged and abandoned wellhead**

**PIT STATUS EVALUATION FORM**

Facility ID: 111249

Pit Name: BIRD ELBERT CO 3-13

Duplicate Record(s) Pit #



**Legend**

- Producing or Shut In Well
- ⊗ Temp Aban Well
- ⊗ Abandoned Well
- ⊗ Dry & Aban Well
- ⊗ Earthen Pit
- Culvert
- \* Backfilled Pit(s)
- Vault
- Fiberglass Tank
- Steel Tank(s)
- | Separator
- Wellhead
- Earthen Pit Extent
- Area of Disturbance
- Backfilled Pit Extent
- - - Tank Fence

1:6,000

0 250 500 750 Feet

Image Source:  
USDA National Agricultural Imagery Program (NAIP), 2006

S.S. PAPANOPULOS & ASSOCIATES, INC.

**COGCC Database Information**

Status: NR Owner: K P KAUFFMAN COMPANY INC  
 T: 6S R: 63W Sec: 3 QQ: SWSW 6th Meridian  
 Latitude: 39.551711 Longitude: -104.440459 NAD83

County: Elbert, CO  
 County Code: 039

**Pit Status Evaluation**

**Active**       Form 15: Pit Permit (1998) existing      Assoc. Well Seq No(s) 06569 PR(5-12-96)  
 Other documentation LIF# 587129 (8-18-1987)  
 Aerial photo verification

**Closed**       Form 27: Remediation Workplan \_\_\_\_\_  
 Form 4: Sundry Notice \_\_\_\_\_  
 Rule 903a.(2)B \_\_\_\_\_  
 Evidence pit(s) existed, no closure docs & well not PR, AC or SI  
     Well API Seq #(s) \_\_\_\_\_  
 Other documentation \_\_\_\_\_

**Abandoned**       Possible un-reclaimed pit(s) or adverse conditions, no closure docs       Site Visit  
 **Unknown**       No Site Visit  
 Add'l Review

Notes: LIF (1987) skim pit. FIR (#200124272 9-13-07)  
Field Inspection (6-3-2008): Found steel culvert within battery tank site fence, 100% OCVD

**PIT STATUS EVALUATION FORM**

Facility ID: 111259

Pit Name: RUNNING CREEK STATE 1,3,4

Duplicate Record(s) Pit #

*115175, 115176, 115178*



**Legend**

- Producing or Shut In Well
- ⊗ Temp Aban Well
- ⊗ Abandoned Well
- ⊗ Dry & Aban Well
- ⊗ Earthen Pit
- Culvert
- ⊗ Backfilled Pit(s)
- Vault
- Fiberglass Tank
- Steel Tank(s)
- | Separator
- Wellhead
- Earthen Pit Extent
- Area of Disturbance
- Backfilled Pit Extent
- - - Tank Fence

1:6,000

0 250 500 750 Feet

Image Source:  
USDA National Agricultural Imagery Program (NAIP), 2006

S.S. PAPADOPULOS & ASSOCIATES, INC.

**COGCC Database Information**

Status: NR Owner: SMITH ENERGY CORP  
 T: 6S R: 64W Sec: 16 QQ: CNE 6th Meridian  
 Latitude: 39.535322 Longitude: -104.553359 NAD83

County: Elbert, CO  
 County Code: 039

**Pit Status Evaluation**

Active       Form 15: Pit Permit NA      Assoc. Well Seq No(s) 06571 Well #1, 06443 #4, 06435/06491 #3

Other documentation \_\_\_\_\_ *all wells producing as of 6-2008*

Aerial photo verification \_\_\_\_\_

Closed       Form 27: Remediation Workplan \_\_\_\_\_

*Fiberglass tank installed*       Form 4: Sundry Notice \_\_\_\_\_

Rule 903a.(2)B \_\_\_\_\_

Evidence pit(s) existed, no closure docs & well not PR, AC or SI

Well API Seq #(s) \_\_\_\_\_

Other documentation \_\_\_\_\_

Abandoned       Possible un-reclaimed pit(s) or adverse conditions, no closure docs       Site Visit

Unknown       No Site Visit

Add'l Review

Notes: *Common Use w/ Pit # 115175, 115176, 115178.*

*Field Visit 6-3-2008: Running Creek #4 & #3 well pads visited & no visible signs of pit remains.*

Facility ID 111259  
Well API 05-039-06571  
Well API 05-039-06443  
Well API 05-039-06491

Running Creek State 1, 3 & 4  
Running Creek State 4  
Running Creek State 1  
Running Creek State 3

June 3, 2008



Photo 1. Running Creek State 4 wellhead near battery tank site



Photo 2. Looking south at 300 BBL production tank

**Facility ID 111259**  
Well API 05-039-06571  
Well API 05-039-06443  
Well API 05-039-06491

**Running Creek State 1, 3 & 4**  
Running Creek State 4  
Running Creek State 1  
Running Creek State 3

**June 3, 2008**



**Photo 3. Looking southwest at buried fiberglass tank and horizontal separator**




**Photo 4. Fiberglass water tank and cover**

**PIT STATUS EVALUATION FORM**

Facility ID: 111260

Pit Name: RUNNING CREEK STATE 11

Duplicate Record(s) Pit #

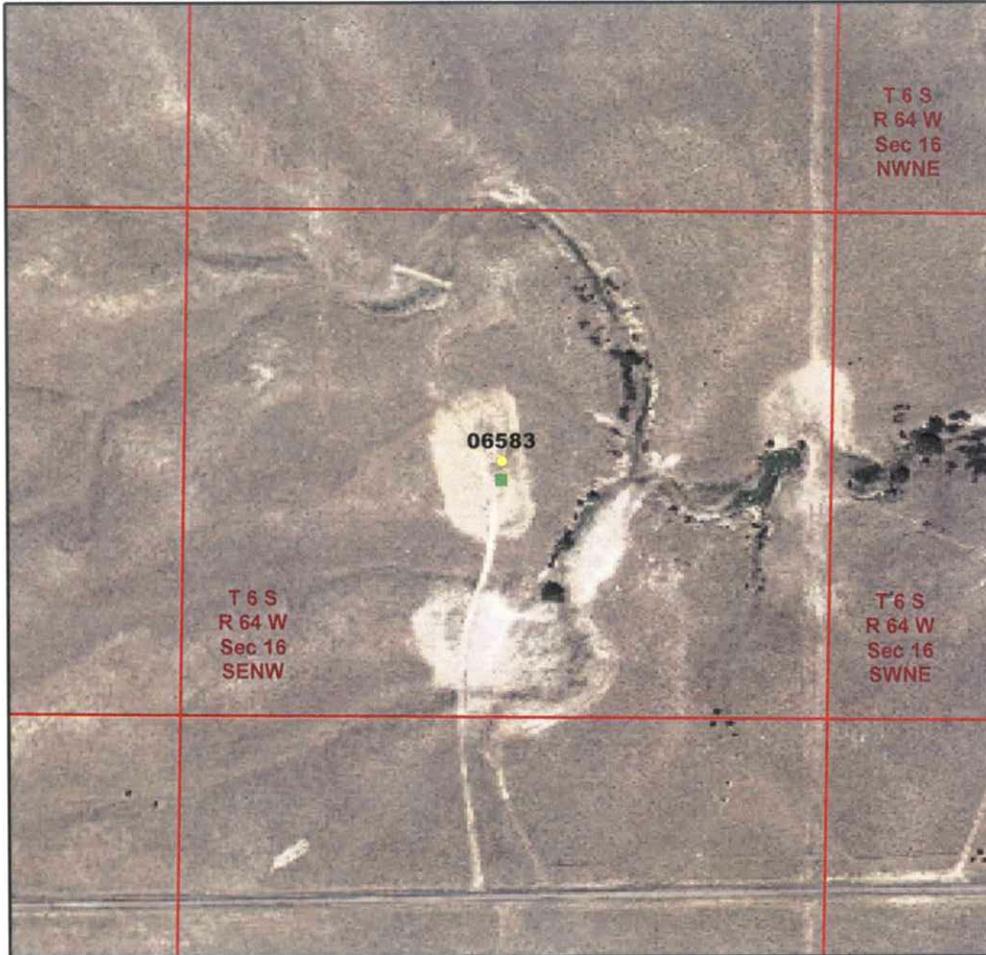

**Legend**

- Database Pit Location
- Producing Well
- Shut In Well
- Temp Aban Well
- Abandoned Well
- Dry & Aban Well
- Injection Well
- Other Well Status



Image Source:  
USDA National Agricultural Imagery  
Program (NAIP), 2006

S.S. PAPANOPULOS & ASSOCIATES, INC.

**COGCC Database Information**

Status: NR Owner: SMITH ENERGY CORP  
T: 6S R: 64W Sec: 16 QQ: SENW 6th Meridian  
Latitude: 39.529936 Longitude: -104.562488 NAD83

County: Elbert, CO  
County Code: 039

**Pit Status Evaluation**

- Active
  - Form 15: Pit Permit NA Assoc. Well Seq No(s) 06583 (11-4-03) PR
  - Other documentation FIR #200124277 (9-13-07)
  - Aerial photo verification
- Closed
  - Form 27: Remediation Workplan \_\_\_\_\_
  - Form 4: Sundry Notice \_\_\_\_\_
  - Rule 903a.(2)B
  - Evidence pit(s) existed, no closure docs & well not PR, AC or SI
  - Well API Seq #(s) \_\_\_\_\_
  - Other documentation \_\_\_\_\_
- Abandoned
  - Possible un-reclaimed pit(s) or adverse conditions, no closure docs
- Unknown
  - Site Visit
  - No Site Visit
  - Add'l Review

Notes: UF (1987) 30'x30' wire covered. FIR(2007) indicates excavation pit exists.  
FIELD VISIT 6-3-2008: NO PIT ON SITE. NO INDICATION OF PIT SITE.  
RUNNING CREEK II POSSIBLY SHARES BATTERY TANK WITH #1,3,4

**PIT STATUS EVALUATION FORM**

Facility ID: 111797

Pit Name: DUFFY 10-3

Duplicate Record(s) Pit #

111796



**Legend**

- Producing or Shut In Well
- ♁ Temp Aban Well
- ♁ Abandoned Well
- ♁ Dry & Aban Well
- ✱ Earthen Pit
- Culvert
- ✱ Backfilled Pit(s)
- Vault
- Fiberglass Tank
- Steel Tank(s)
- | Separator
- Wellhead
- Earthen Pit Extent
- Area of Disturbance
- Backfilled Pit Extent
- - - Tank Fence

1:6,000



Image Source:  
USDA National Agricultural Imagery  
Program (NAIP), 2006

S.S. PAPANOPULOS & ASSOCIATES, INC.

**COGCC Database Information**

Status: NR Owner: K P KAUFFMAN COMPANY INC  
T: 7S R: 63W Sec: 10 QQ: NENW 6th Meridian  
Latitude: 39.462085 Longitude: -104.433949 NAD83

County: Elbert, CO  
County Code: 039

**Pit Status Evaluation**

- Active**  Form 15: Pit Permit #846306 (1998) existing Assoc. Well Seq No(s) TA (2005) 06459PA(12-6-01)  
 Other documentation FORM 21 #1496117 (4-20-2005), NOVA # 119754  
 Aerial photo verification (10-22-2004)
- Closed**  Form 27: Remediation Workplan \_\_\_\_\_  
 Form 4: Sundry Notice \_\_\_\_\_  
 Rule 903a.(2)B \_\_\_\_\_  
 Evidence pit(s) existed, no closure docs & well not PR, AC or SI  
 Well API Seq #(s) \_\_\_\_\_  
 Other documentation \_\_\_\_\_
- Abandoned**  Possible un-reclaimed pit(s) or adverse conditions, no closure docs  Site Visit  
 No Site Visit  
 Add'l Review
- Unknown**

Notes: No lease inspections for Facility ID#111797. NOVA #119754 (2004) indicates well maintain TA status until 4-20-2010.  
 Field Visit 6-4-2008: Earthen Pit & Culvert found. Heavily oil saturated soils & pit cover/berm unsatisfactory.



**Photo 1. Well site - temporarily abandoned well status**



**Photo 2. Earthen pit and culvert**



Photo 3. Culvert and cover



Photo 4. Wellhead equipment

PIT STATUS EVALUATION FORM

Facility ID: 115044

Pit Name: MORRIS 13-4 & 14-8

Duplicate Record(s) Pit #



**Legend**

- Producing or Shut In Well
- ⚡ Temp Aban Well
- ⚡ Abandoned Well
- ⚡ Dry & Aban Well
- ☀ Earthen Pit
- Culvert
- ✱ Backfilled Pit(s)
- Vault
- Fiberglass Tank
- Steel Tank(s)
- | Separator
- Wellhead
- Earthen Pit Extent
- Area of Disturbance
- Backfilled Pit Extent
- - - Tank Fence

1:6,000

0 250 500 750 Feet

Image Source:  
USDA National Agricultural Imagery Program (NAIP), 2006

S.S. PAPANOPULOS & ASSOCIATES, INC.

COGCC Database Information

Status: NR Owner: RENEGADE OIL & GAS COMPANY LLC  
 T: 6S R: 63W Sec: 13 QQ: NWNW 6th Meridian  
 Latitude: 39.530509 Longitude: -104.402357 NAD83

County: Elbert, CO  
 County Code: 039

**Pit Status Evaluation**

- Active**  Form 15: Pit Permit #581179 (7-1983) Assoc. Well Seq No(s) 06296 PA (8-25-93) SI (4-16-04)  
 Other documentation #581183 (1983) production facility sketch  
 Aerial photo verification COGCC 2005 aenials show two pits East of Lease Road
- Closed**  Form 27: Remediation Workplan \_\_\_\_\_  
 Form 4: Sundry Notice \_\_\_\_\_  
 Rule 903a.(2)B  
 Evidence pit(s) existed, no closure docs & well not PR, AC or SI  
 Well API Seq #(s) \_\_\_\_\_  
 Other documentation \_\_\_\_\_
- Abandoned**  Possible un-reclaimed pit(s) or adverse conditions, no closure docs  Site Visit  
 No Site Visit  
 Add'l Review
- Unknown**

Notes: Common Use battery site for Morris 13-4 & 14-8  
 Field Visit 6-3-2008: Pit area has been turned/aerated. Battery Site Using fiberglass tank for water storage. Pit remediation recommended.

**Facility ID 115044**  
Well API 05-039-06296  
Well API 05-039-06297

**Morris 13-4 & 14-8**  
Morris 13-4  
Morris 14-8

**June 3, 2008**



**Photo 1. Battery tank lease sign**



**Photo 2. Vertical separator, fiberglass tank and battery tank**

**Facility ID 115044**  
Well API 05-039-06296  
Well API 05-039-06297

**Morris 13-4 & 14-8**  
Morris 13-4  
Morris 14-8

**June 3, 2008**



**Photo 3. Fiberglass tank and cover**



**Photo 4. Looking north towards Morris 13-4 wellhead and earthen pits in foreground**

**Facility ID 115044**  
Well API 05-039-06296  
Well API 05-039-06297

**Morris 13-4 & 14-8**  
Morris 13-4  
Morris 14-8

**June 3, 2008**




**Photo 5. Looking north along the lease road showing west portion of the skim pit**



**Photo 6. Looking east showing the skim pit to the left and the earthen pit in the center and right of photo**

PIT STATUS EVALUATION FORM  
 Facility ID: 115045  
 Pit Name: MORRIS 13-8 & 13-14

Duplicate Record(s) Pit #

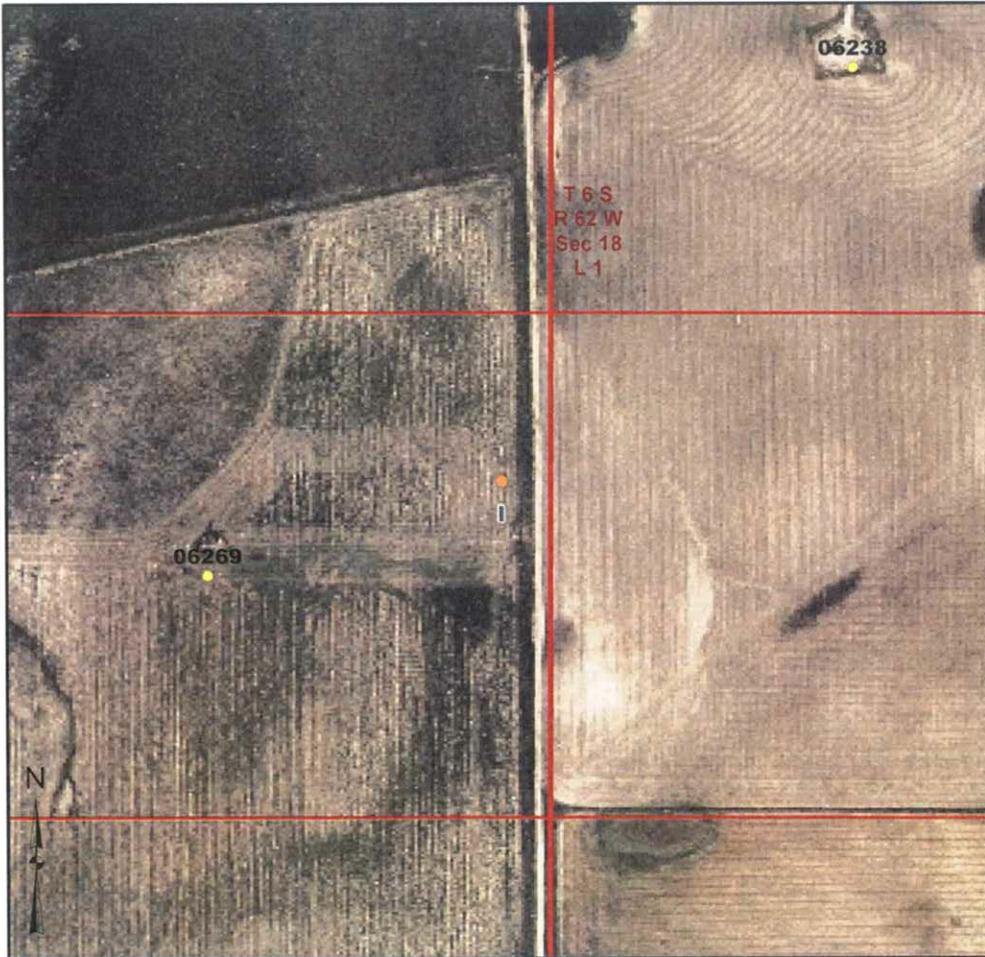

**Legend**

- Producing or Shut In Well
- ⚡ Temp Aban Well
- ⚡ Abandoned Well
- ⚡ Dry & Aban Well
- ☀ Earthen Pit
- Culvert
- ✱ Backfilled Pit(s)
- Vault
- Fiberglass Tank
- Steel Tank(s)
- | Separator
- Wellhead
- Earthen Pit Extent
- Area of Disturbance
- Backfilled Pit Extent
- - - Tank Fence

1:6,000

0 250 500 750 Feet

Image Source:  
 USDA National Agricultural Imagery Program (NAIP), 2006

S.S. PAPANOPULOS & ASSOCIATES, INC.

**COGCC Database Information**

Status: NR Owner: RENEGADE OIL & GAS COMPANY LLC  
 T: 6S R: 62W Sec: 13 QQ: SENE 6th Meridian  
 Latitude: 39.530137 Longitude: -104.385324 NAD83

County: Elbert, CO  
 County Code: 039

**Pit Status Evaluation**

- Active**       Form 15: Pit Permit (1983) existing      Assoc. Well Seq No(s) 06256 until 06268 TA (8-17-05)
- Other documentation \_\_\_\_\_
- Aerial photo verification \_\_\_\_\_
- Closed**       Form 27: Remediation Workplan \_\_\_\_\_
- Form 4: Sundry Notice #581190 (3-1985) installed unground steel tank
- Rule 903a.(2)B \_\_\_\_\_
- Evidence pit(s) existed, no closure docs & well not PR, AC or SI  
 Well API Seq #(s) \_\_\_\_\_
- Other documentation \_\_\_\_\_
- Abandoned**       Possible un-reclaimed pit(s) or adverse conditions, no closure docs       Site Visit
- Unknown**       No Site Visit
- Add'l Review

X NO PIT ON SITE

Notes: Field Reports claim: Common Use Storage tank for Morris 13-8 (06269) and Morris 13-14/06256  
Possibly serve 13-8 (06269) and 44-13 (06085) which is geographically located in SESE of Section 13.

Field Visit 6-3-2008 : No pit onsite, steel storage tanks near Morris 05-09-06269

**PIT STATUS EVALUATION FORM**

Facility ID: 115063

Pit Name: NORDMAN 10-7

Duplicate Record(s) Pit #



**Legend**

- Producing or Shut In Well
- ♂ Temp Aban Well
- ♂ Abandoned Well
- ♂ Dry & Aban Well
- ☀ Earthen Pit
- Culvert
- \* Backfilled Pit(s)
- Vault
- Fiberglass Tank
- Steel Tank(s)
- | Separator
- Wellhead
- Earthen Pit Extent
- Area of Disturbance
- Backfilled Pit Extent
- - - Tank Fence

1:6,000

Feet

0 250 500 750

Image Source:  
USDA National Agricultural Imagery Program (NAIP), 2006

S.S. PAPANOPULOS & ASSOCIATES, INC.

**COGCC Database Information**

Status: NR Owner: TIMBERLINE ENERGY INC  
 T: 6S R: 64W Sec: 10 QQ: SWNE 6th Meridian  
 Latitude: 39.544349 Longitude: -104.539101 NAD83

County: Elbert, CO  
 County Code: 039

**Pit Status Evaluation**

**Active**  Form 15: Pit Permit (1986) existing Assoc. Well Seq No(s) 06477 (8-9-84)  
 Other documentation FIR (1995) FIR (2006) # 200088223  
 Aerial photo verification

**Closed**  Form 27: Remediation Workplan \_\_\_\_\_  
 Form 4: Sundry Notice \_\_\_\_\_  
 Rule 903a.(2)B  
 Evidence pit(s) existed, no closure docs & well not PR, AC or SI  
Well API Seq #(s) \_\_\_\_\_  
 Other documentation \_\_\_\_\_

**Abandoned**  Possible un-reclaimed pit(s) or adverse conditions, no closure docs  Site Visit  
 Unknown  No Site Visit  
  Add'l Review

Notes: LIF (1987) for ID # 115139 indicates 4' diameter culvert. FIR (1995) concrete coffin.  
FIELD VISIT 6-3-2008: LOCATION AND EQUIPMENT VERIFIED BY  
FIELD INSPECTOR USING AERIAL PHOTO MAPS.


**PIT STATUS EVALUATION FORM**

Facility ID: 115072

Pit Name: SARTI 24-2, 24-6, 24-10

Duplicate Record(s) Pit #

119947

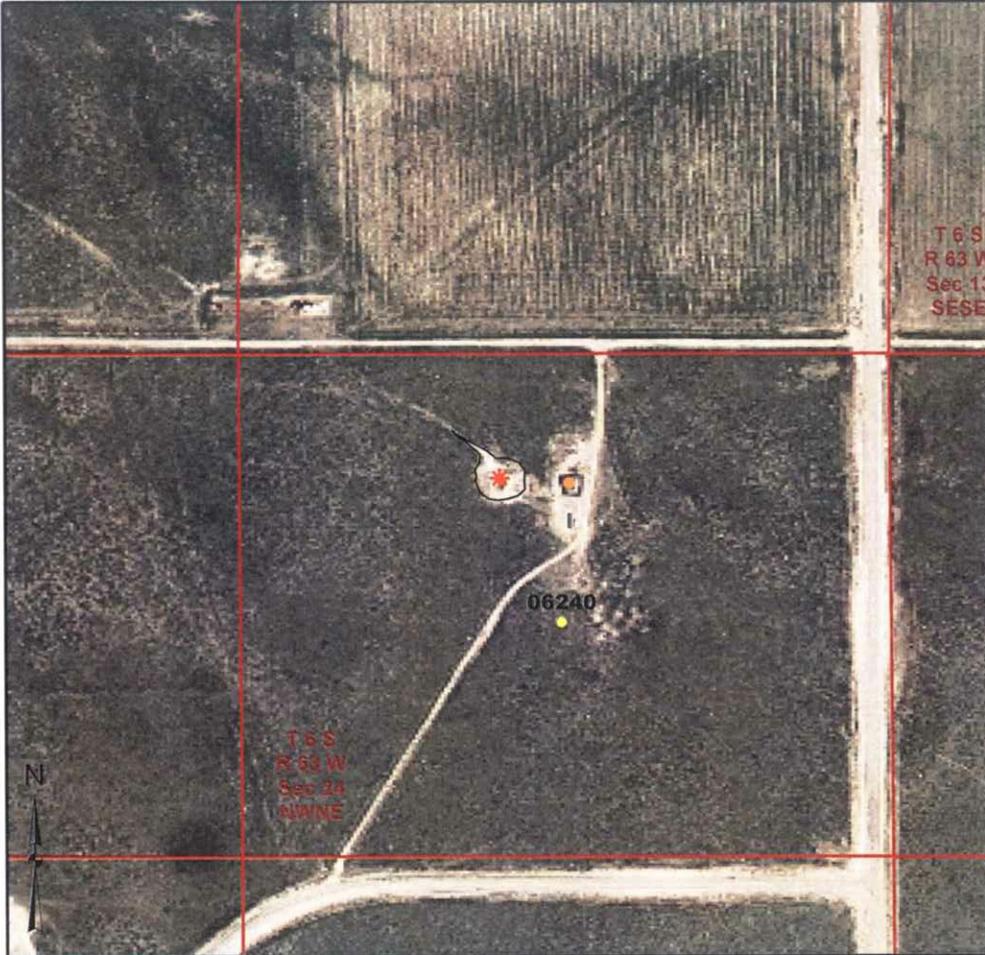

**Legend**

- Producing or Shut In Well
- ⚡ Temp Aban Well
- ⚡ Abandoned Well
- ⚡ Dry & Aban Well
- ☀ Earthen Pit
- Culvert
- ★ Backfilled Pit(s)
- Vault
- Fiberglass Tank
- Steel Tank(s)
- | Separator
- Wellhead
- Earthen Pit Extent
- Area of Disturbance
- Backfilled Pit Extent
- - - Tank Fence

1:6,000

Feet

0    250    500    750

Image Source:  
USDA National Agricultural Imagery Program (NAIP), 2006

S.S. PAPADOPULOS & ASSOCIATES, INC.

**COGCC Database Information**

Status: NR    Owner: RENEGADE OIL & GAS COMPANY LLC  
 T: 6S    R: 63W    Sec: 24    QQ: NWNE    6th Meridian  
 Latitude: 39.519586    Longitude: -104.392525    NAD83

**County:** Elbert, CO  
**County Code:** 039

**Pit Status Evaluation**

- Active**
  - Form 15: Pit Permit 1983 existing    Assoc. Well Seq No(s) 06240 RC(5-31-77)
  - Other documentation WSIF #445117 (11-6-1997)
  - Aerial photo verification COGCC aeriels verify pit site area
- Closed**
  - Form 27: Remediation Workplan \_\_\_\_\_
  - Form 4: Sundry Notice \_\_\_\_\_
  - Rule 903a.(2)B \_\_\_\_\_
  - Evidence pit(s) existed, no closure docs & well not PR, AC or SI  
Well API Seq #(s) \_\_\_\_\_
  - Other documentation \_\_\_\_\_
- Abandoned**     Possible un-reclaimed pit(s) or adverse conditions, no closure docs
- Unknown**    Common Use w/ Sarti 24-2, 24-6, 24-10

- Site Visit
- No Site Visit
- Add'l Review

Notes: WSIF (1997) "screened earthen pit, fencing falling down" FIR (9-12-07)  
"Remove oil sat. soil; pits still open"  
Field Visit 6-3-2008: PIT IS BACKFILLED; RESEEDING RECOMMENDED.

Facility ID 115072  
Well API 05-039-06240  
Well API 05-039-06261  
Well API 05-039-06262

Sarti 24-2, 24-6 & 24-10  
Sarti 24-2  
Sarti 24-6  
Sarti 24-10

June 3, 2008



Photo 1. Tank battery lease sign



Photo 2. Two 300 BBL production tanks

**Facility ID 115072**  
Well API 05-039-06240  
Well API 05-039-06261  
Well API 05-039-06262

**Sarti 24-2, 24-6 & 24-10**  
Sarti 24-2  
Sarti 24-6  
Sarti 24-10

**June 3, 2008**



**Photo 3. Looking Southeast towards backfilled pit site**



**Photo 4. Looking west at former pit site**

**PIT STATUS EVALUATION FORM**

Facility ID: 115079

Pit Name: WHITEHEAD 12-16

Duplicate Record(s) Pit #



**Legend**

- Producing or Shut In Well
- ⚡ Temp Aban Well
- ⚡ Abandoned Well
- ⚡ Dry & Aban Well
- ☀ Earthen Pit
- Culvert
- ★ Backfilled Pit(s)
- Vault
- Fiberglass Tank
- Steel Tank(s)
- | Separator
- Wellhead
- Earthen Pit Extent
- Area of Disturbance
- Backfilled Pit Extent
- - - - Tank Fence

1:6,000

0 250 500 750 Feet

Image Source:  
USDA National Agricultural Imagery Program (NAIP), 2006

S.S. PAPANOPULOS & ASSOCIATES, INC.

**COGCC Database Information**

Status: CL Owner: RENEGADE OIL & GAS COMPANY LLC  
 T: 6S R: 63W Sec: 12 QQ: SESE 6th Meridian  
 Latitude: 39.536356 Longitude: -104.38773 NAD83

County: Elbert, CO  
 County Code: 039

**Pit Status Evaluation**

**Active**

Form 15: Pit Permit (1983) existing Assoc. Well Seq No(s) \_\_\_\_\_

Other documentation photos #854785 & #854786 (12-2001)

Aerial photo verification \_\_\_\_\_

**Closed**

Form 27: Remediation Workplan \_\_\_\_\_

Form 4: Sundry Notice \_\_\_\_\_

Rule 903a.(2)B \_\_\_\_\_

Evidence pit(s) existed, no closure docs & well not PR, AC or SI  
 Well API Seq #(s) 06293 PR(5-7-01)

Other documentation FIR (2004) "pit closed"

**Abandoned**  Possible un-reclaimed pit(s) or adverse conditions, no closure docs  Site Visit

**Unknown**  No Site Visit  Add'l Review

Notes: LIF (1987) 20' x 20' pit. FIR (2004) pit closed.  
FIELD VISIT 6-4-2008: PIT BACKFILLED & SITE CLEAN.  
Using covered steel tank



**Photo 1. Whitehead 12-16 wellhead and lease sign**



**Photo 2. Former earthen pit location shown in foreground and covered steel tank and battery tank in background**

**PIT STATUS EVALUATION FORM**

Facility ID: 115081

Pit Name: WHITEHEAD 12-1

Duplicate Record(s) Pit #



**Legend**

- Producing or Shut In Well
- ⊕ Temp Aban Well
- ⊖ Abandoned Well
- ⊗ Dry & Aban Well
- ⊛ Earthen Pit
- Culvert
- \* Backfilled Pit(s)
- Vault
- Fiberglass Tank
- Steel Tank(s)
- | Separator
- Wellhead
- Earthen Pit Extent
- Area of Disturbance
- Backfilled Pit Extent
- - - Tank Fence

1:6,000

0 250 500 750 Feet

Image Source:  
USDA National Agricultural Imagery Program (NAIP), 2006

S.S. PAPADOPULOS & ASSOCIATES, INC.

**COGCC Database Information**

Status: NR Owner: RENEGADE OIL & GAS COMPANY LLC  
 T: 6S R: 63W Sec: 12 QQ: NENE 6th Meridian  
 Latitude: 39.547984 Longitude: -104.389145 NAD83

County: Elbert, CO  
 County Code: 039

**Pit Status Evaluation**

**Active**       Form 15: Pit Permit (1980) new      Assoc. Well Seq No(s) 06332 PR(5-2003)  
 Other documentation \_\_\_\_\_      06357 PR(5-2003)  
 Aerial photo verification COGCC aenals show pit site area

**Closed**       Form 27: Remediation Workplan \_\_\_\_\_  
 Form 4: Sundry Notice \_\_\_\_\_  
 Rule 903a.(2)B \_\_\_\_\_  
 Evidence pit(s) existed, no closure docs & well not PR, AC or SI  
     Well API Seq #(s) \_\_\_\_\_  
 Other documentation \_\_\_\_\_

**Abandoned**       Possible un-reclaimed pit(s) or adverse conditions, no closure docs       Site Visit  
 **Unknown**       No Site Visit  
 Add'l Review

Notes: common use for Whitehead 12-1 and 12-7  
WF (1987) 30' x 30' pit, FIR (1995) pit and concrete coffin exist.  
FIELD VISIT 6-4-2008: PIT BACKFILLED & REMEDIATED

*2,300 BBL steel tanks near Whitehead 12-1*

**Facility ID 115081**  
Well API 05-039-06332  
Well API 05-039-06357

**Whitehead 12-1 & 12-7**  
Whitehead 12-1  
Whitehead 12-1

**June 4, 2008**



**Photo 1. Whitehead 12-1 wellhead and lease sign near battery tanks**



**Photo 2. Two 300 BBL tanks used for water and production**

**Facility ID 115081**  
Well API 05-039-06332  
Well API 05-039-06357

**Whitehead 12-1 & 12-7**  
Whitehead 12-1  
Whitehead 12-1

**June 4, 2008**



**Photo 3. Looking northwest at separator and Champlin Amoco 548 "A" 2 wellhead**



**Photo 4. Looking north at former earthen pit site**

**Facility ID 115081**  
Well API 05-039-06332  
Well API 05-039-06357

**Whitehead 12-1 & 12-7**  
Whitehead 12-1  
Whitehead 12-1

**June 4, 2008**



**Photo 5. Looking southwest at backfilled pit site in foreground**



**Photo 6. Additional pit not used for produced water found north of former pit site**

**PIT STATUS EVALUATION FORM**

Facility ID: 115084  
 Pit Name: MILLER 6-11

Duplicate Record(s) Pit #



**Legend**

- Producing or Shut In Well
- ⚡ Temp Aban Well
- ⚡ Abandoned Well
- ⊙ Dry & Aban Well
- ☀ Earthen Pit
- Culvert
- \* Backfilled Pit(s)
- Vault
- Fiberglass Tank
- Steel Tank(s)
- | Separator
- Wellhead
- Earthen Pit Extent
- Area of Disturbance
- Backfilled Pit Extent
- - - Tank Fence

1:6,000

0 250 500 750 Feet

Image Source:  
 USDA National Agricultural Imagery Program (NAIP), 2006

S.S. PAPADOPULOS & ASSOCIATES, INC.

**COGCC Database Information**

Status: NR Owner: RENEGADE OIL & GAS COMPANY LLC  
 T: 6S R: 62W Sec: 6 QQ: NESW 6th Meridian  
 Latitude: 39.555191 Longitude: -104.377905 NAD83

County: Elbert, CO  
 County Code: 039

**Pit Status Evaluation**

**Active**  Form 15: Pit Permit (1982) new Assoc. Well Seq No(s) 06375  
 Other documentation \_\_\_\_\_  
 Aerial photo verification \_\_\_\_\_

**Closed**  Form 27: Remediation Workplan \_\_\_\_\_  
 Form 4: Sundry Notice \_\_\_\_\_  
 Rule 903a.(2)B \_\_\_\_\_  
 Evidence pit(s) existed, no closure docs & well not PR, AC or SI  
 Well API Seq #(s) FIR#200129733 (4-2-08)  
 Other documentation \_\_\_\_\_

**Abandoned**  Possible un-reclaimed pit(s) or adverse conditions, no closure docs  Site Visit  
 **Unknown**  No Site Visit  Add'l Review

*Covered steel tank*

*Common Use for Miller 6-11, 6-7, 6-13, 6-15*

Notes: *FIR(2008) indicates no closure documents for pit and excessive area disturbed, corrective action due 5-19-08.*

*FIELD VISIT 6-4-2008 : PIT BACKFILLED, SITE NOT CLEAN. Debris Found.*

*Recommend Remediation*

**Facility ID 115084**

Well API 05-039-06375

Well API 05-039-06293

Well API 05-039-06349

Well API 05-039-06376

**Miller 6-11, 6-7, 6-13 & 6-15**

Miller 6-11

Miller 6-7

Miller 6-13

Miller 6-15

**June 4, 2008**



**Photo 1. Battery tank lease sign**



**Photo 2. Covered steel water tank**

**Facility ID 115084**

Well API 05-039-06375

Well API 05-039-06293

Well API 05-039-06349

Well API 05-039-06376

**Miller 6-11, 6-7, 6-13 & 6-15**

Miller 6-11

Miller 6-7

Miller 6-13

Miller 6-15

**June 4, 2008**



**Photo 3. Looking north at pit site**



**Photo 4. Looking southeast at Miller 6-11 wellhead from pit site**