

Location Drawing


Steil Surveying Services, LLC

1102 West 19th Street P.O. BOX 2073

Cheyenne, Wyoming 82009

VISIBLE IMPROVEMENTS
THIS MAP DOES NOT REPRESENT A BOUNDARY SURVEY

SECTION 9
TOWNSHIP 4 NORTH
RANGE 64 WEST

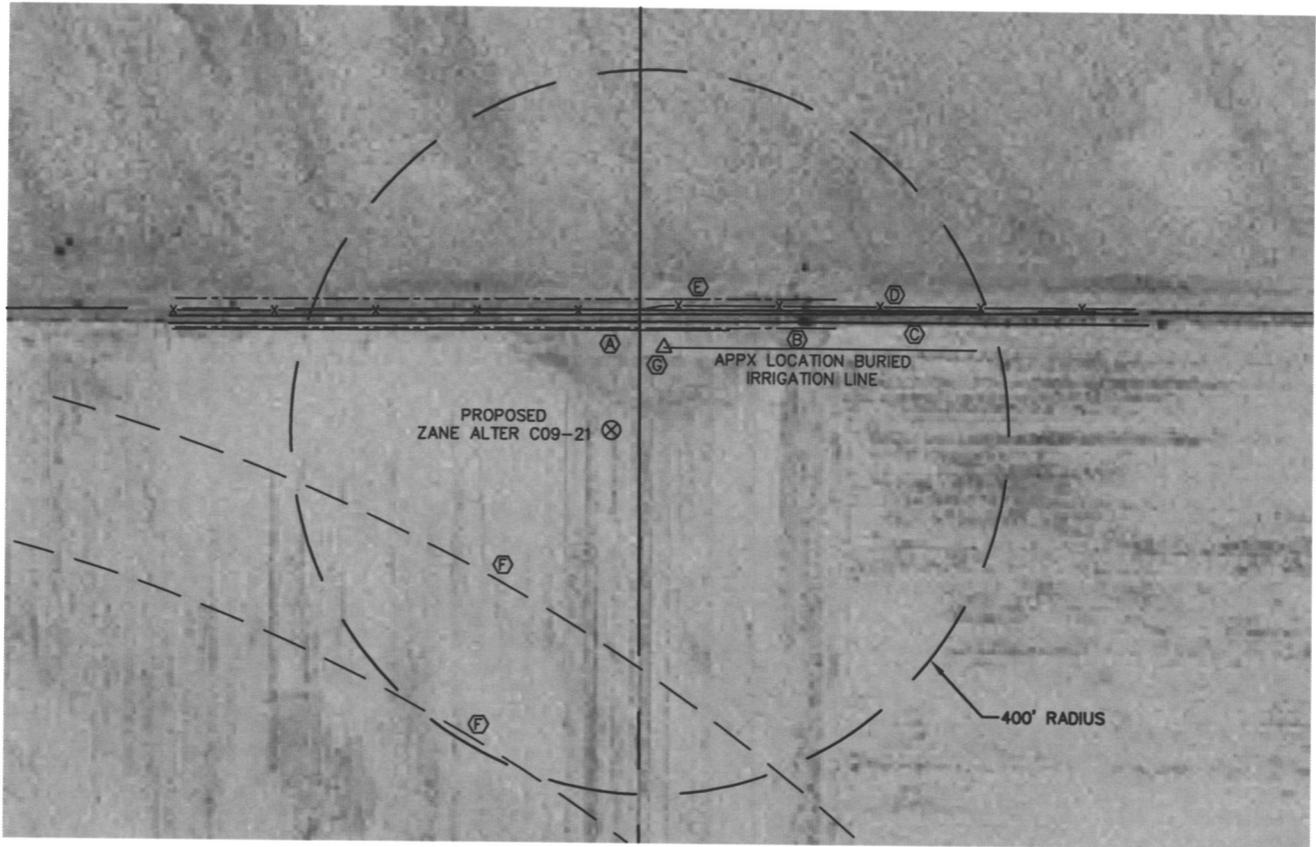

IMPROVEMENTS:

- (A) CONCRETE DITCH - 111' NORTH
- (B) DIRT DITCH - 113' NORTH
- (C) DIRT ROAD - 120' NORTH
- (D) FENCE LINE - 133' NORTH
- (E) DIRT DITCH - 145' NORTH
- (F) IRRIGATION WHEEL TRACKS - 204' & 371' SOUTHWEST
- (G) IRRIGATION SEEP WATER WELL - 108' NORTHEAST

NEAREST OVERHEAD POWERLINE IS 2600'+/- TO THE WEST

NOTICE: According to Colorado law you MUST commence any legal action based upon any defect in this W.L.C. within three years after you first discover such defect. In no event may any action based upon any defect in this W.L.C. be commenced more than ten years from this sold date of the certification shown hereon.

