




Multi well Plan

Directional Layout

SECTION 31
TOWNSHIP 5 NORTH
RANGE 64 WEST

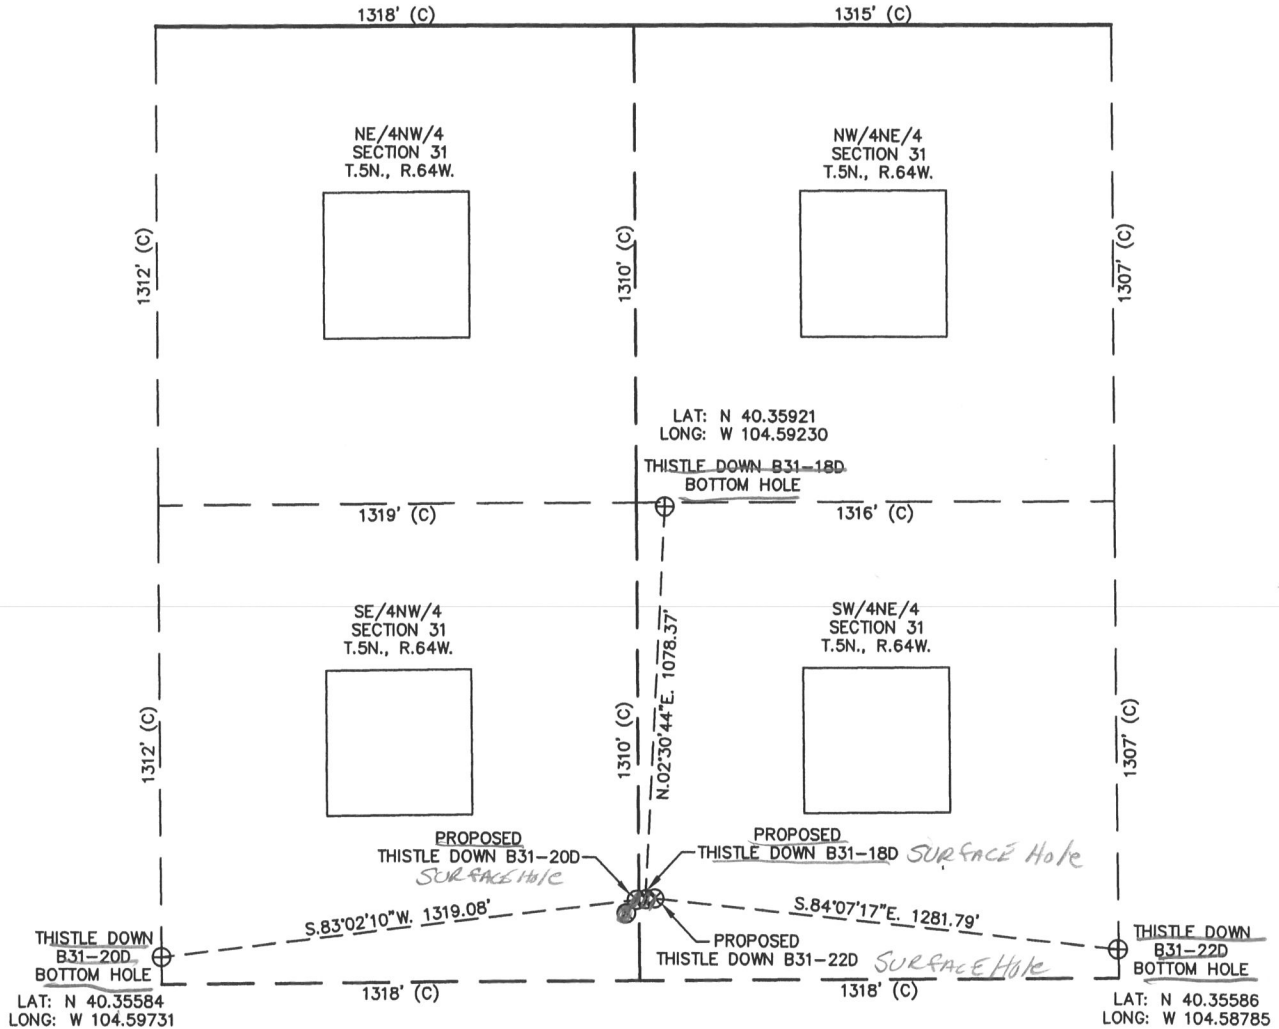

WELL PAD DETAIL

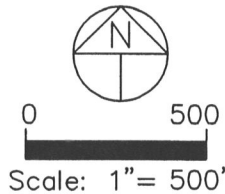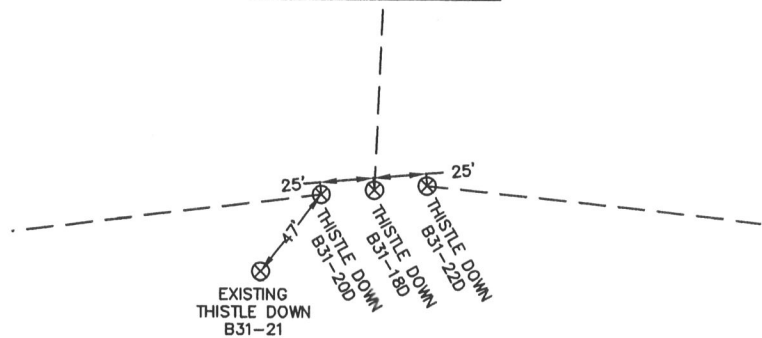

NOTES:

- 1) THIS SKETCH DOES NOT REPRESENT A BOUNDARY SURVEY.
- 2) THE DATUM FOR THE LATITUDES AND LONGITUDES ON THIS SKETCH IS NAD83.