

LOCATION DRAWING


DALEY LAND SURVEYING, INC.

PARKER, CO. 80134

303 953 9841

VISIBLE IMPROVEMENTS SKETCH
CANNON X04-28D

SECTION 33, TOWNSHIP 3 NORTH, RANGE 65 WEST OF THE 6TH PRINCIPLE MERIDIAN

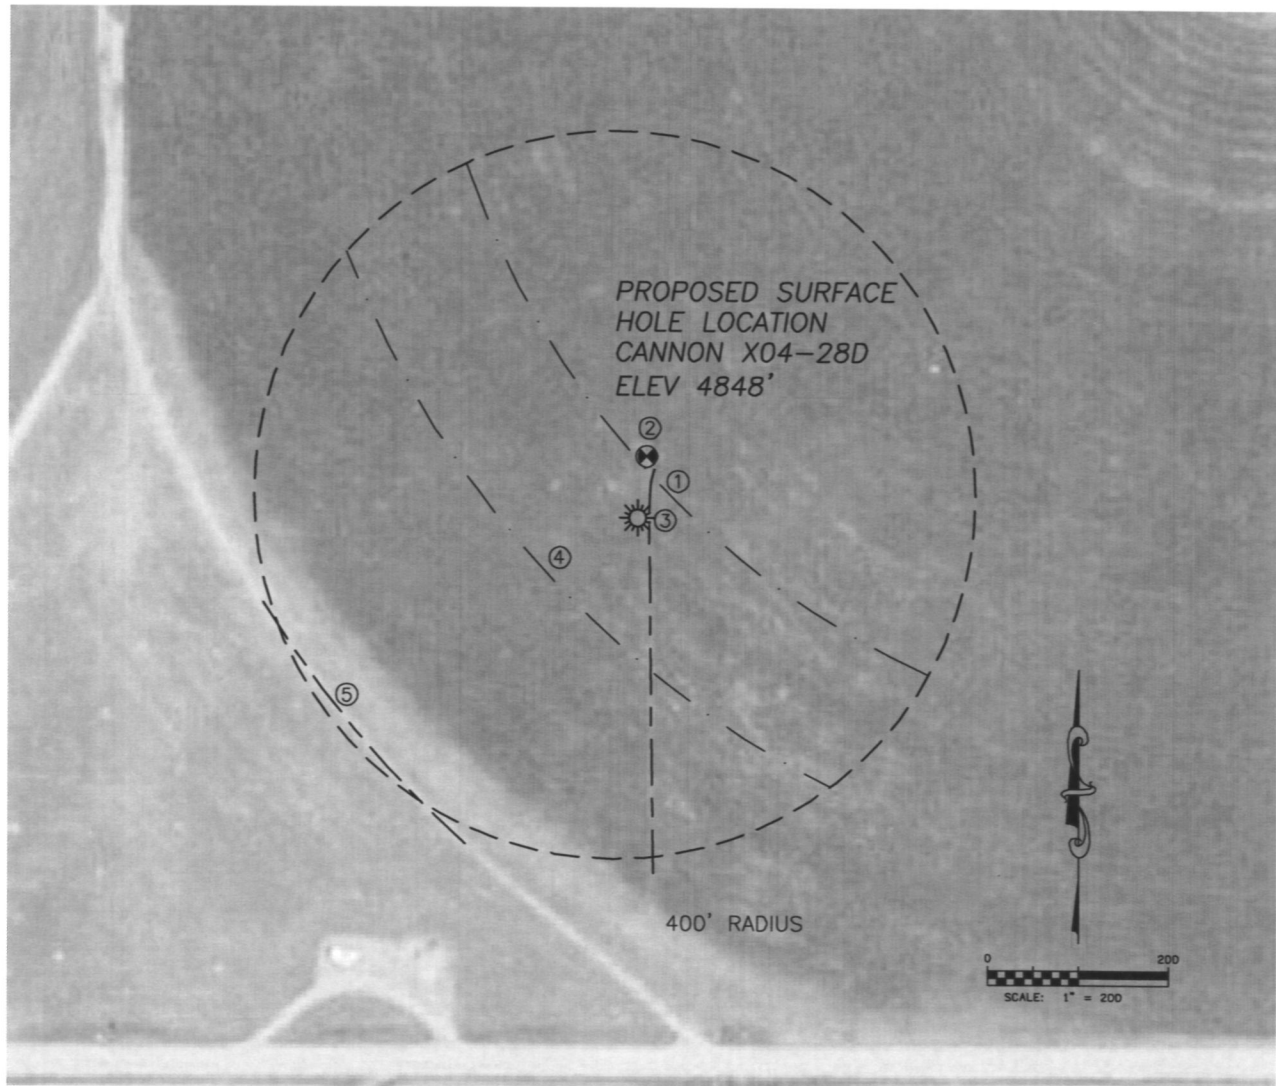

①
PIVOT TRACK
43' NE

②
UPRC 33-15J5
68' NE

③
CENTERLINE
FIELD ROAD
13' EAST

④
PIVOT TRACK
115' SW

⑤
CENTERLINE
FIELD ROAD
389' SW