


WELL LOCATION CERTIFICATE LINHART #5

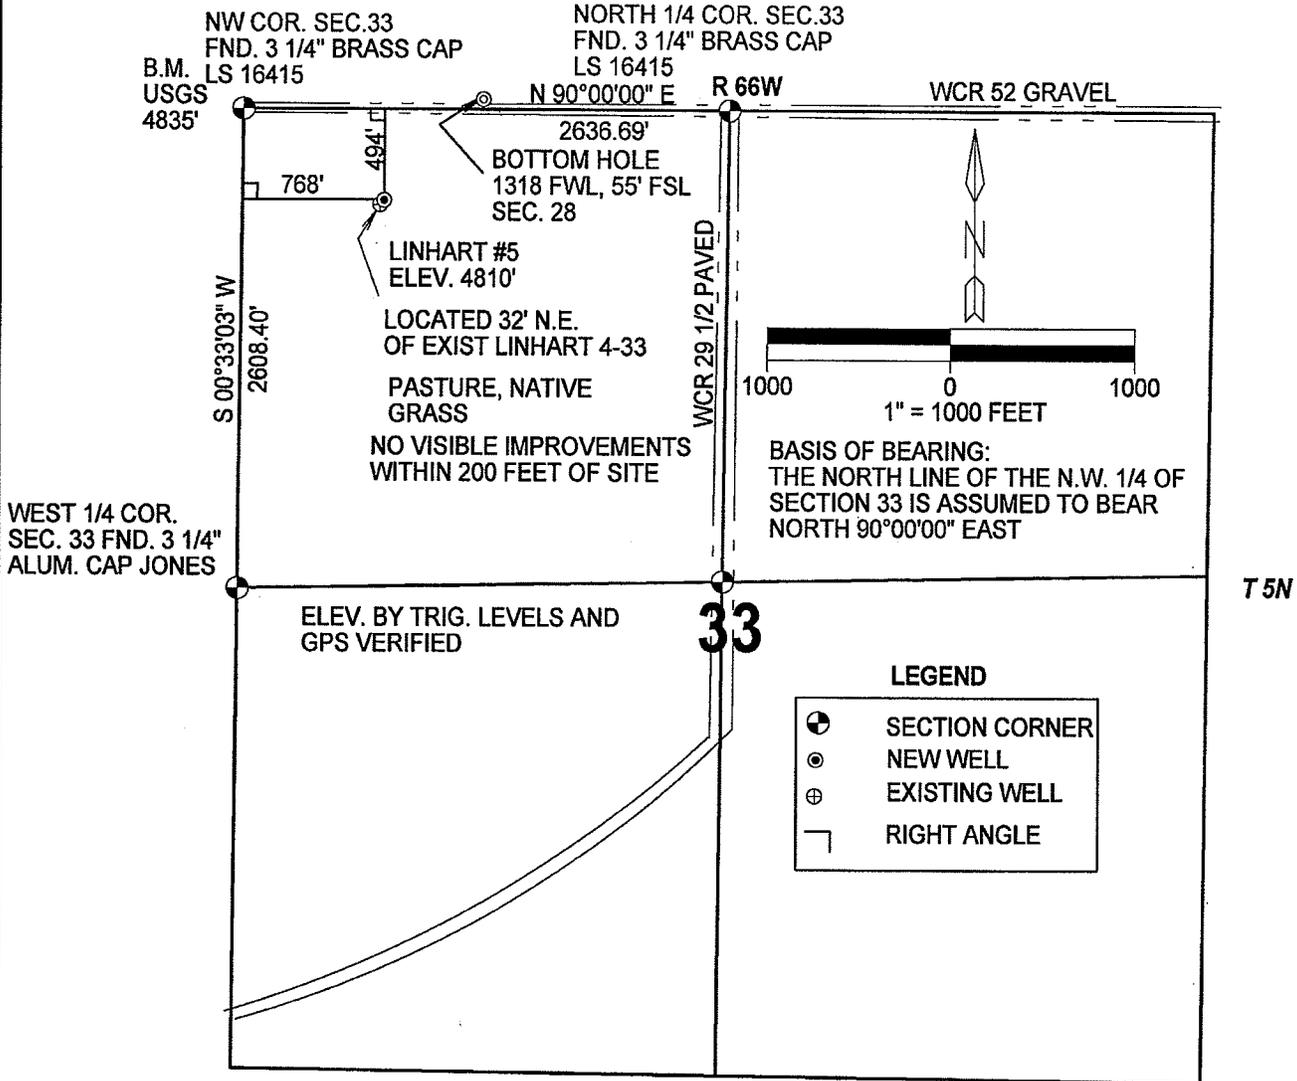


IN ACCORDANCE WITH A REQUEST FROM MERIT ENERGY COMPANY, THE UNDERSIGNED HAS DETERMINED THE LOCATION OF THE LINHART NUMBER 5 WELL TO BE 768' FWL AND 494' FNL, SECTION 33, TOWNSHIP 5 NORTH, RANGE 66 WEST OF THE 6TH PRINCIPAL MERIDIAN, WELD COUNTY, COLORADO. FIELD SURVEY DATE: MARCH 15, 2007

GPS LOCATION	
NORTH	40.36189° NAD 1983
WEST	104.79136°
PDOP	3.8

SURVEYOR STATEMENT

I, ROBERT D. THOMAS DO HEREBY STATE THAT THIS OIL AND, OR GAS WELL LOCATION CERTIFICATE WAS PREPARED FOR MERIT ENERGY COMPANY. IT IS NOT A SURVEY PLAT OR IMPROVEMENT SURVEY PLAT AND IS NOT TO BE RELIED UPON FOR THE ESTABLISHMENT OF FENCES, BUILDINGS OR OTHER FUTURE IMPROVEMENT LINES.

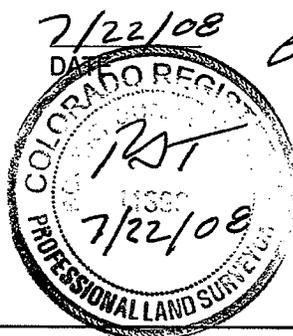

Robert D. Thomas
 ROBERT D. THOMAS
 COLORADO REGISTERED LAND SURVEYOR
 NUMBER 11399

THOMAS SURVEY SERVICES, LLC
 2619 WEST 11TH STREET ROAD, SUITE 24
 GREELEY, COLORADO 80634
 TELEPHONE: (970) 304-0984

PROJECT: 0703.019
 DRAWING: MERIT LINHART #5