


# LOCATION DRAWING

DALEY LAND SURVEYING, INC. 10727 FLAGLER DR. PARKER, CO. 80134

## VISIBLE IMPROVEMENTS SKETCH LUDWIG H06-21D

SECTION 6, TOWNSHIP 3 NORTH, RANGE 65 WEST OF THE 6TH PRINCIPLE MERIDIAN

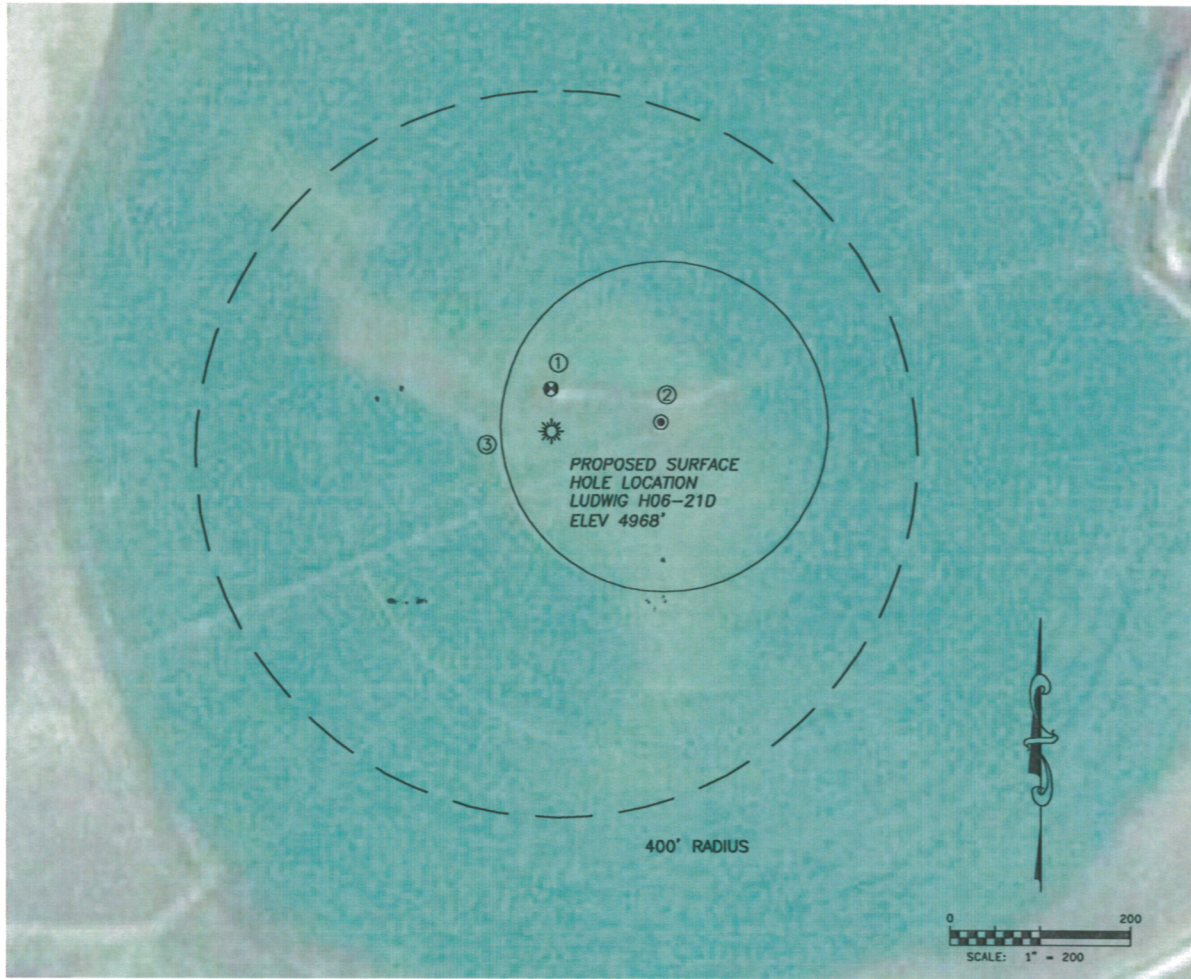

①  
EXISTING WELL  
LUDWIG 2-6  
47' NORTH

②  
PIVOT  
125' EASTERLY

③  
PIVOT TRACK  
54' WESTERLY