


WELL LOCATION CERTIFICATE

SAUER G04-28D

SECTION 33, TOWNSHIP 5 NORTH, RANGE 65 WEST OF THE 6TH PRINCIPLE MERIDIAN

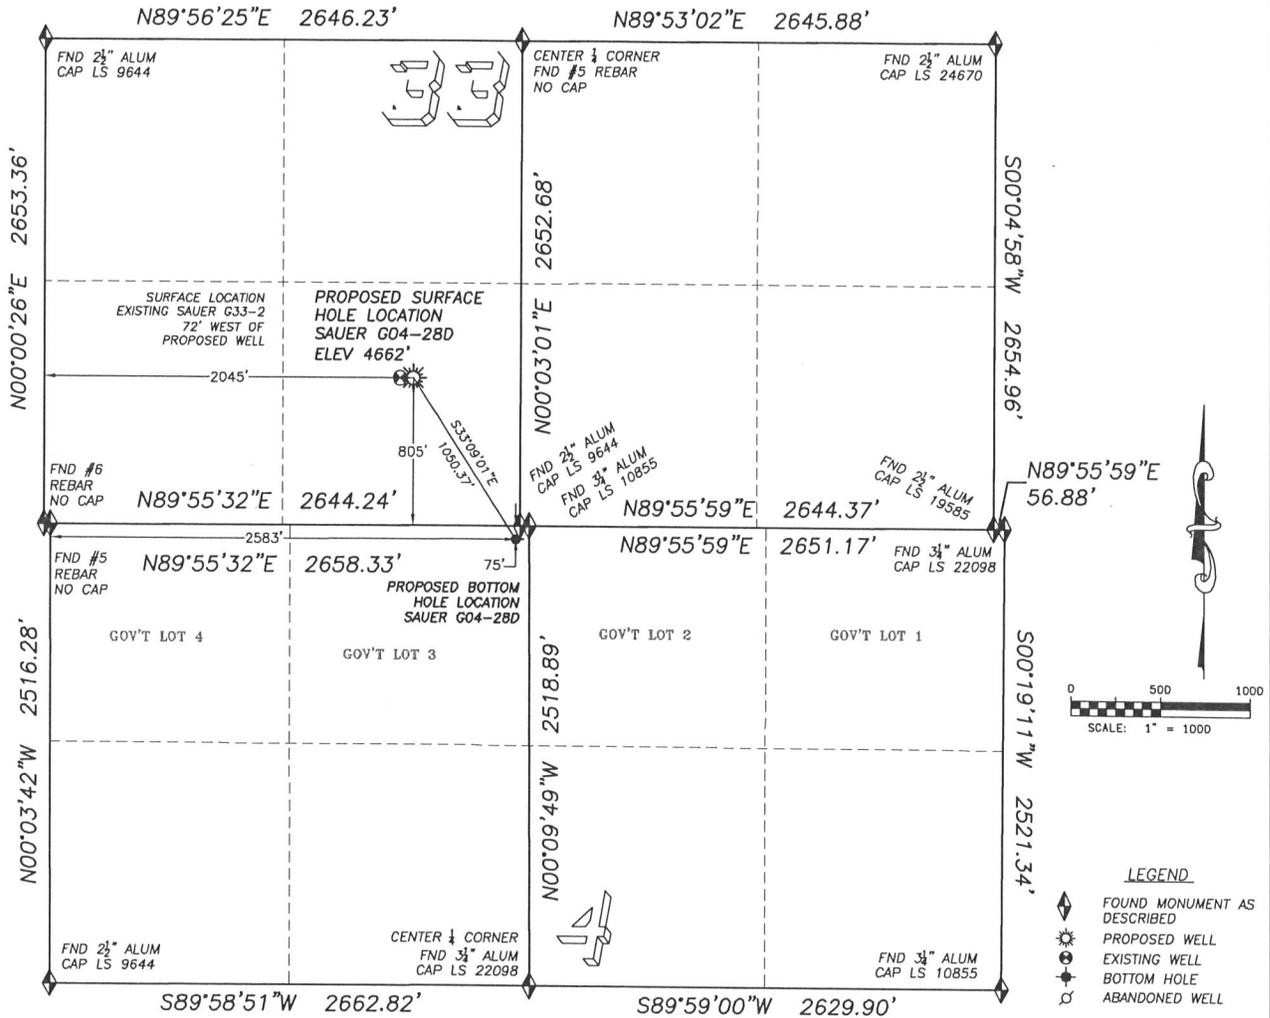

NAD 83 LATITUDE AND LONGITUDE

SAUER G04-28D SURFACE HOLE:
 LATITUDE: N40.35069°
 LONGITUDE: W104.67052°
 ELEVATION: 4662'
 PDOP 1.4
 805' FSL, 2045' FWL

BOTTOM HOLE:
 LATITUDE: N40.34828°
 LONGITUDE: W104.66846°
 75' FNL, 2583' FWL

NEAREST EXISTING WELL:
 SAUER 33-2 SURFACE HOLE
 LATITUDE: N40.35069°
 LONGITUDE: W104.67078°
 ELEVATION: 4661'
 72' WEST


QUARTER/QUARTER: SE/SW
NEAREST APPARENT PROPERTY LINE:
 600' ± EAST

IN ACCORDANCE WITH A REQUEST FROM BILL BETSON OF NOBLE ENERGY INC., DALEY LAND SURVEYING, INC. HAS DETERMINED THE SURFACE LOCATION OF THE SAUER G04-28D WELL TO BE 805' FSL, 2045' FWL, AS MEASURED AT NINETY (90) DEGREES FROM THE SECTION LINES OF SECTION 33, TOWNSHIP 5 NORTH, RANGE 65 WEST OF THE 6TH PRINCIPLE MERIDIAN, WELD COUNTY COLORADO. THE BOTTOM HOLE LOCATION PROVIDED BY THE CLIENT IS TO BE 75' FNL, AND 2583' FWL OF SECTION 4, TOWNSHIP 4 NORTH RANGE 65 WEST.

I HEREBY CERTIFY THAT THIS WELL LOCATION CERTIFICATE WAS PREPARED BY ME OR UNDER MY DIRECT SUPERVISION, THAT THE WORK WAS COMPLETED ON 06/19/2009 FOR AND ON BEHALF OF NOBLE ENERGY, INC., AND THAT THIS MAP DOES NOT REPRESENT A BOUNDARY SURVEY. IT IS NOT A LAND SURVEY PLAT OR AN IMPROVEMENT SURVEY PLAT AND IT IS NOT TO BE RELIED UPON FOR THE ESTABLISHMENT OF FENCE, BUILDING OR OTHER FUTURE IMPROVEMENT LINES.

- NOTES:
- 1) BASIS OF BEARINGS FOR THIS MAP ARE BASED UPON GPS OBSERVATIONS MADE BETWEEN MONUMENTS LOCATED AT THE SOUTHWEST AND SOUTH QUARTER CORNER OF SECTION 33, AND ALL BEARINGS SHOWN HERON ARE RELATIVE THERETO.
 - 2) HORIZONTAL DATUM IS NAD83.
 - 3) VERTICAL DATUM IS NAVD88. ELEVATIONS ARE DERIVED FROM GPS-RTK OBSERVATIONS PROCESSED THROUGH OPUS, UTILIZING THE GEOIDD3 MODEL.
 - 4) SEE VISIBLE IMPROVEMENTS EXHIBIT FOR ALL VISIBLE IMPROVEMENTS WITHIN 400' OF PROPOSED SURFACE HOLE LOCATION
 - 5) SURFACE USE: PASTURE



NOTICE: According to Colorado law you MUST commence any legal action based upon any defect in this W.L.C. within three years after you first discover such defect. In no event may any action based upon any such defect in this W.L.C. be commenced more than ten years from the date of the certification shown heron.

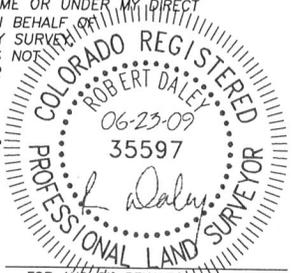

FOR AND ON BEHALF OF
 DALEY LAND SURVEYING INC.,
 Robert Daley, PLS 35597

SITE SKETCH SAUER G04-28D

SECTION 33, TOWNSHIP 5 NORTH, RANGE 65 WEST OF THE 6TH PRINCIPLE MERIDIAN

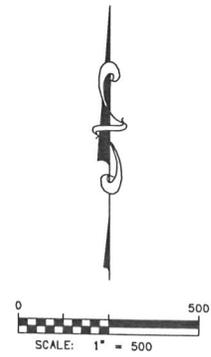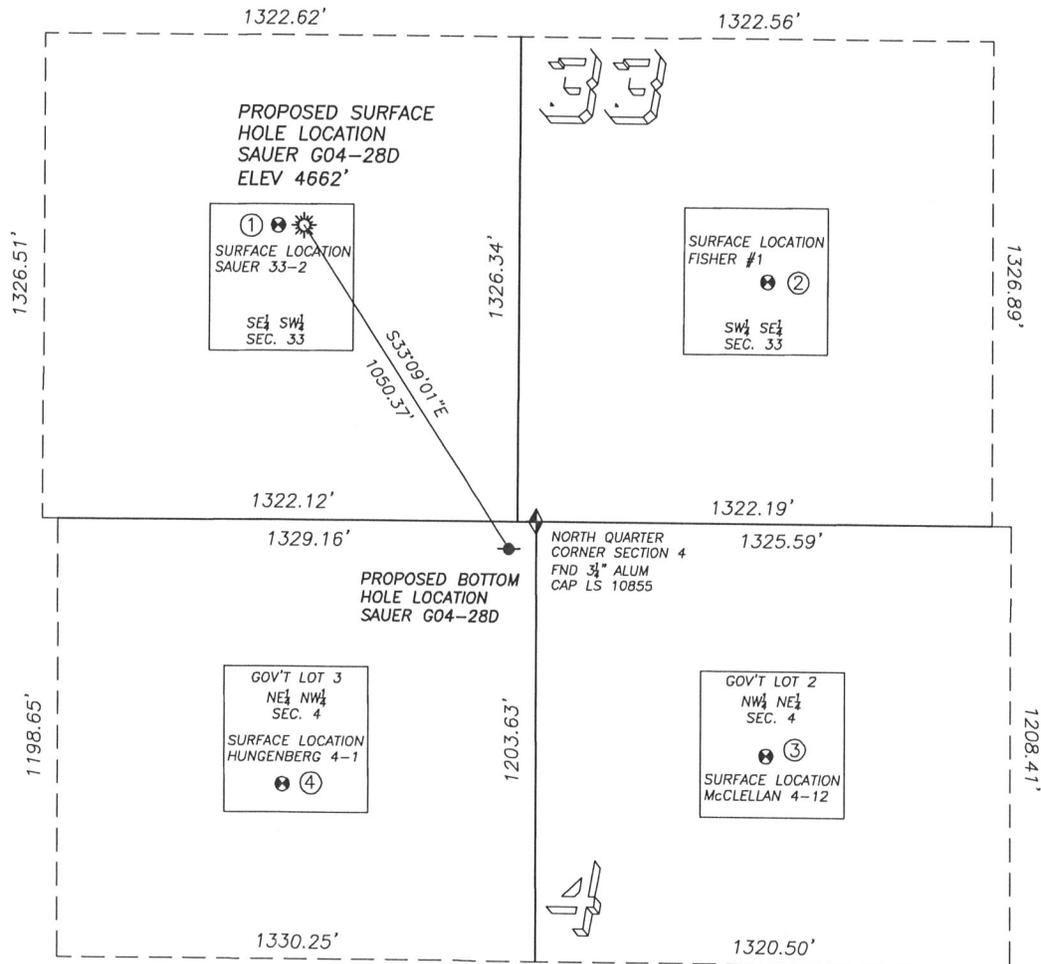

- | | | | |
|---|--|--|---|
| <p>①
SAUER 33-2
SE/SW SEC. 33
805' FSL, 1973' FWL
1091' NW OF PROPOSED
BOTTOM HOLE LOCATION
LAT. N40.35069°
LONG. W104.67078°
EL: 4661'
PDOP 3.6</p> | <p>②
FISHER #1
SW/SE SEC. 33
661' FSL, 1952' FEL
1029' NE OF PROPOSED
BOTTOM HOLE LOCATION
LAT. N40.35030°
LONG. W104.66588°
EL: 4666'
PDOP 2.3</p> | <p>③
McCLELLAN 4-12
GOV'T LOT 2
(NW/NE) SEC. 4
636 FNL, 2004' FEL
910' SE OF PROPOSED
BOTTOM HOLE LOCATION
LAT. N40.34674°
LONG. W104.66588°
EL: 4669'
PDOP 1.8</p> | <p>④
HUNGENBERG 4-1
GOV'T LOT 3
(NE/NW) SEC. 4
723' FNL, 1957' FWL
901' SW OF PROPOSED
BOTTOM HOLE LOCATION
LAT. N40.34650°
LONG. W104.67070°
EL: 4673'
PDOP 2.2</p> |
|---|--|--|---|

- LEGEND**
- FOUND MONUMENT AS DESCRIBED
 - PROPOSED WELL
 - EXISTING WELL
 - PROPOSED BOTTOM HOLE LOCATION

NOTES:

- 1) THIS DOES NOT REPRESENT A BOUNDARY SURVEY
- 2) THE LATITUDES AND LONGITUDES SHOWN ARE REFERENCED TO NAD83
- 3) DATUM FOR ELEVATION IS NAVD88. ELEVATIONS ARE DERIVED FROM GPS-RTK OBSERVATIONS PROCESSED THROUGH OPUS, UTILIZING THE GEOID03 MODEL.