

WELL LOCATION CERTIFICATE

SECTION 9, TOWNSHIP 6 NORTH, RANGE 65 WEST, 6TH P.M.

NW SEC 9
2.5°AC LS 23501

NE SEC 9
3.25°AC LS 22098


N1/4 SEC 9
3.25°AC LS 4392

E1/4 SEC 9
2.5°AC LS 12374

S1/4 SEC 9
2.5°AC LS 25619

SE SEC 9
3.25°AC LS 7242

SW SEC 9
2.5°AC LS 20685

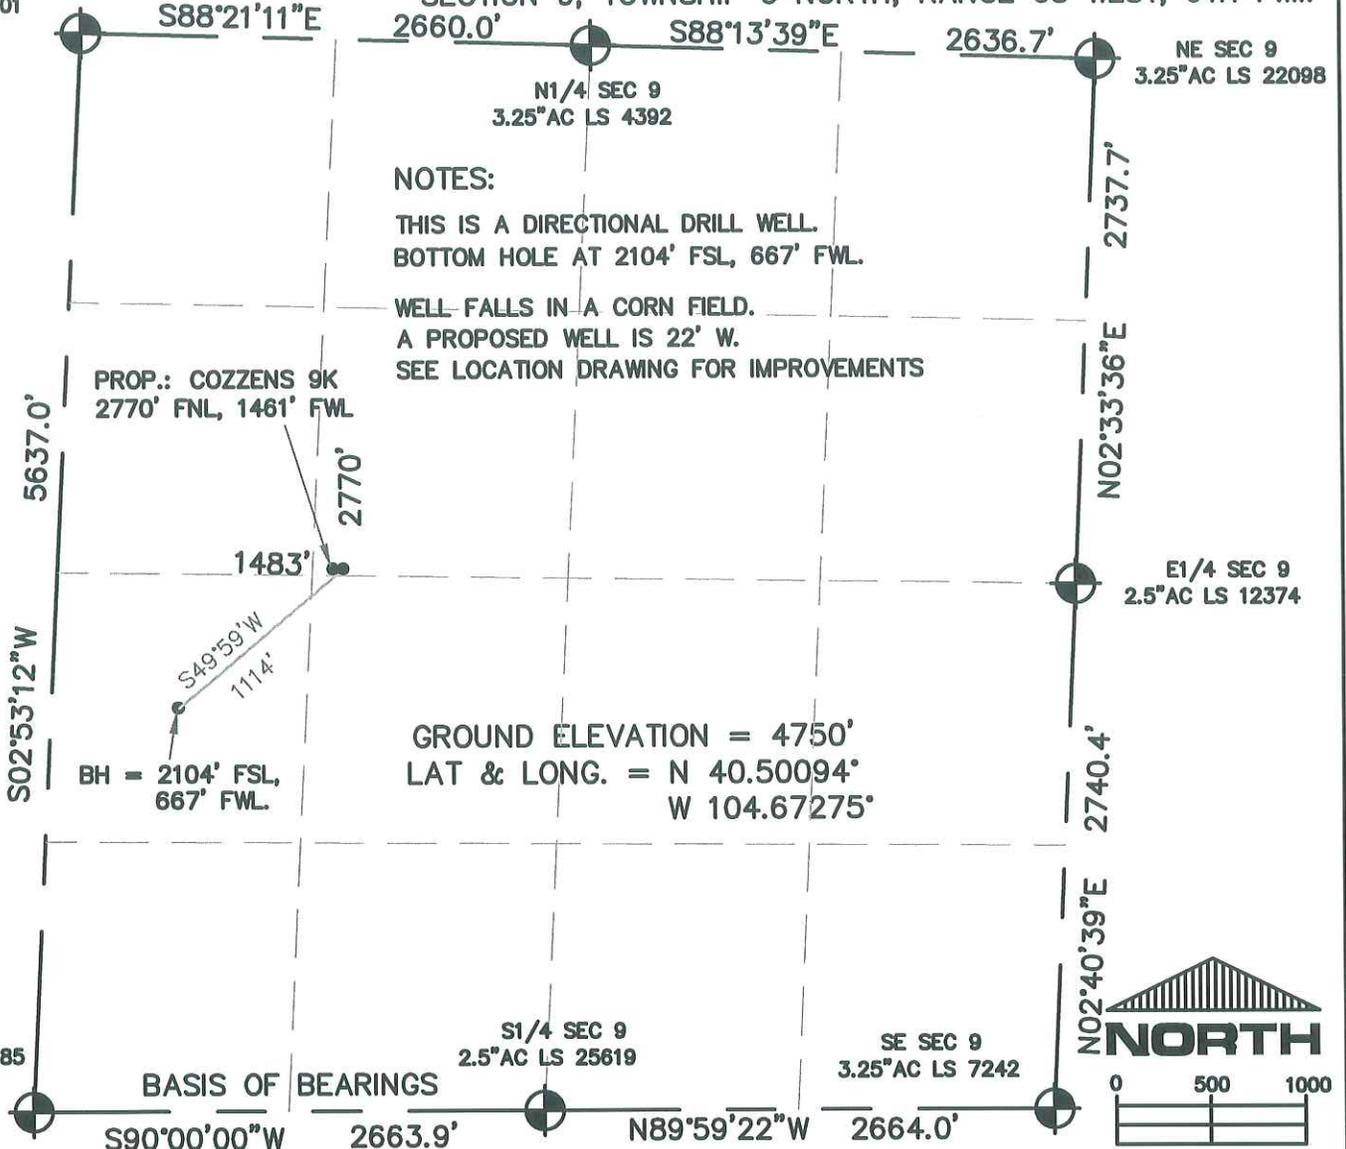

NOTES:

THIS IS A DIRECTIONAL DRILL WELL.
BOTTOM HOLE AT 2104' FSL, 667' FWL.

WELL FALLS IN A CORN FIELD.
A PROPOSED WELL IS 22' W.
SEE LOCATION DRAWING FOR IMPROVEMENTS

GROUND ELEVATION = 4750'
LAT & LONG. = N 40.50094°
W 104.67275°



I HEREBY STATE TO PETROLEUM DEVELOPMENT CORP. THAT THIS WELL LOCATION CERTIFICATE FOR THE WELL COZZENS 13-9D IS LOCATED 2770' FNL & 1483' FWL, SEC. 9, T6N, R65W, 6PM.

SCALE:
1" = 1000'
LEGEND:


- = FOUND MONUMENT
- = PROPOSED WELL
- = IMPROVEMENTS (AS LABELED)

ELEVATION SOURCE = USGS 7.5' QUAD.MAP CONTOURS NGVD 1929 DATUM.

LAT. & LONG. ARE DIFFERENTIALLY CORRECTED (NAD'83) USING (DGPS) WITH (PDOP) VALUES LESS THAN SIX (6).

SHOWN DISTANCES ARE FIELD MEASURED - EXTERIOR SECTION LINES ARE DRAWN TO SCALE (BEST APPROX. OR FOUND MONUMENT).

DISTANCES TO WELL SHOWN PERPENDICULAR TO SECTION LINES.

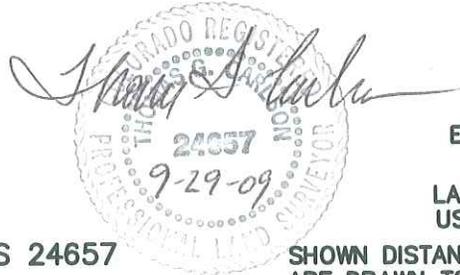

THOMAS G. CARLSON, PLS 24657
HORSESHOE SURVEYING, LLC

THIS IS NOT A MONUMENTED BOUNDARY SURVEY, IT IS ONLY A DRAWING INTENDED TO DEPICT THE WELL LOCATION TO SECTION LINES.

PREPARED BY: HORSESHOE SURVEYING, LLC PO BOX 150458 LAKEWOOD, CO 80215 (720)872-0196		WELL NAME: COZZENS 13-9D	
DRAWING DATE: 9-29-08		LOCATION: WELD COUNTY, CO W1/2, SEC. 9, T6N, R65W, 6TH P.M.	
FIELD DATE: 10-1-08	BY: TGC	CHKD:	JOB NO. SHEET NO. 1 OF 1