


Location Drawing Guajardo 24-18 TR

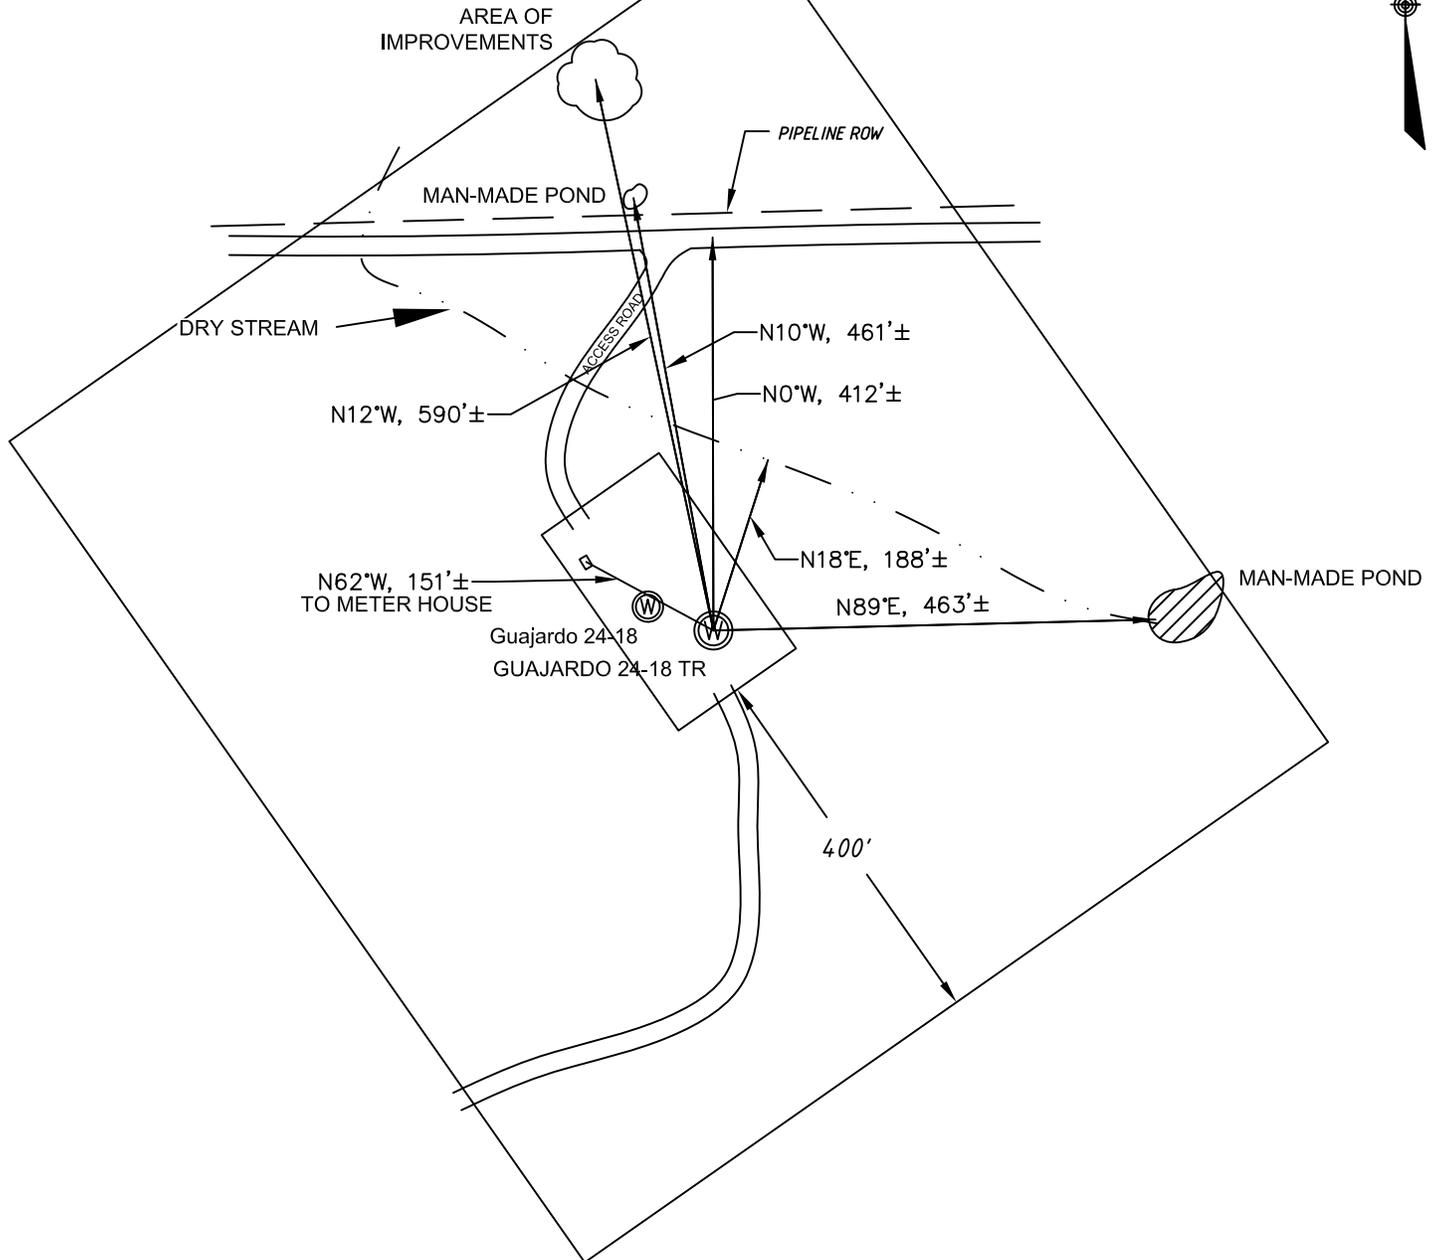

FROM PROPOSED WELL TO EXISTING WELL: $N70^{\circ}W, 73' \pm$


FROM EXISTING WELL TO GAS DRIVE SYSTEM: $N80^{\circ}W, 70' \pm$



SURFACE USE: **RANGELAND**

NOTE:
FOOTAGES GIVEN ARE ONLY ESTIMATES BASED ON SUBDIVISION PLATS AND TIED TO EXISTING CONTROL. A FULL BOUNDARY SURVEY IS REQUIRED TO DETERMINE TRUE SUBDIVISION LOT AND ROAD LOCATIONS, DISTANCES AND AREA OR FOOTAGE CALCULATIONS.

DATE: October 5, 2009

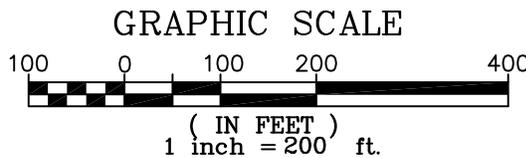

SHIELDS SURVEY L^{td.} C^{o.}
Raton, New Mexico 87740
(575)445-1232