



# SITE SKETCH – SATER CC18-14

SECTION 18  
TOWNSHIP 4 NORTH  
RANGE 63 WEST

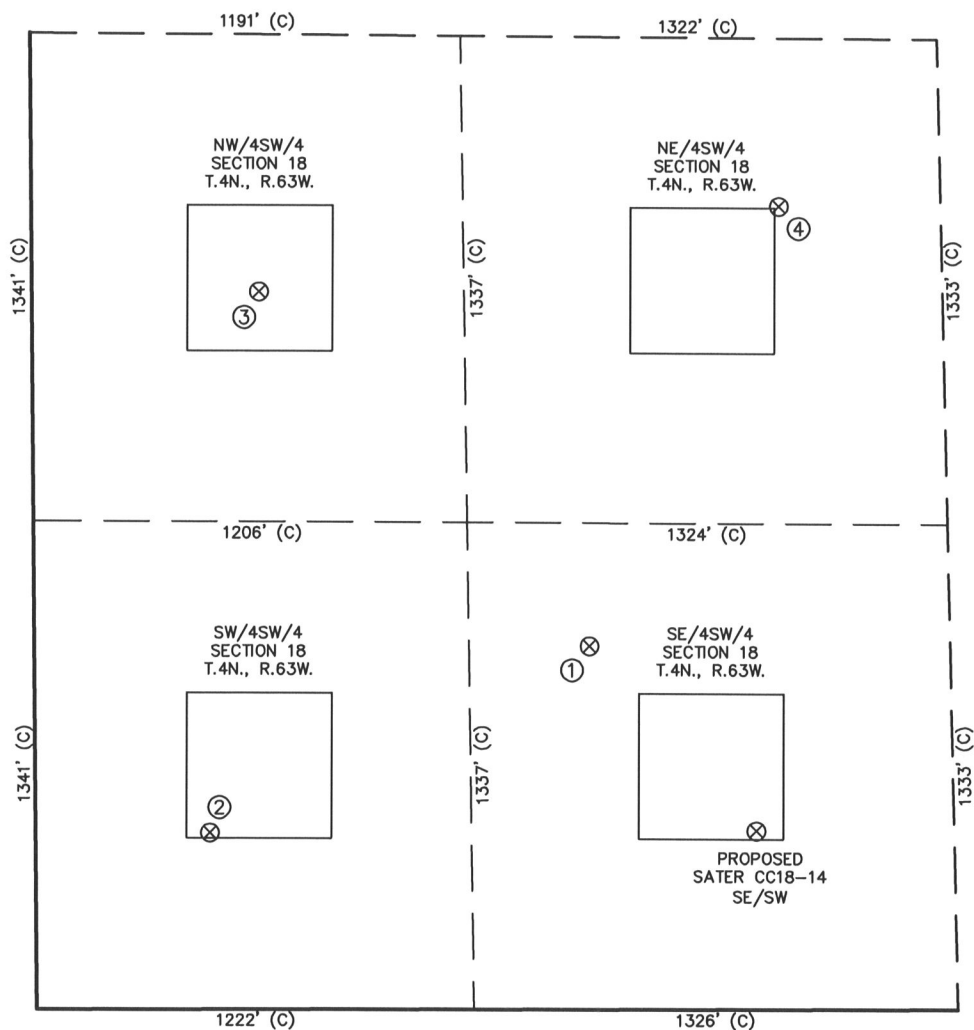

| ①   | ②   | ③   | ④   |
|---|---|---|---|
| WATKINS 18-2<br>SE/SW SEC. 18<br>997' FSL<br>1536' FWL<br>EL 4645'<br>N 40.30761<br>W 104.48417<br>PDOP 2.5 | WATKINS 18-13<br>SW/SW SEC. 18<br>484' FSL<br>482' FWL<br>EL 4645'<br>N 40.30623<br>W 104.48795<br>PDOP 2.4 | WATKINS 18-1<br>NW/SW SEC. 18<br>1970' FSL<br>628' FWL<br>EL 4643'<br>N 40.31030<br>W 104.48742<br>PDOP 2.5 | WATKINS 18-11<br>NE/SW SEC. 18<br>2206' FSL<br>2072' FWL<br>EL 4644'<br>N 40.31092<br>W 104.48225<br>PDOP 2.3 |

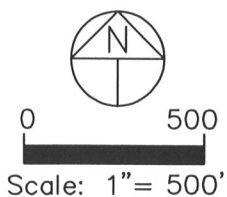

## NOTES:

- 1) THIS SKETCH DOES NOT REPRESENT A BOUNDARY SURVEY.
- 2) THE DATUM FOR THE LATITUDES AND LONGITUDES ON THIS SKETCH IS NAD83.