


# Location Drawing Gus 13-18 TR

FROM PROPOSED WELL TO EXISTING WELL:  $S30^{\circ}W, 42' \pm$

FROM EXISTING WELL TO GAS DRIVE SYSTEM:  $S71^{\circ}E, 19' \pm$

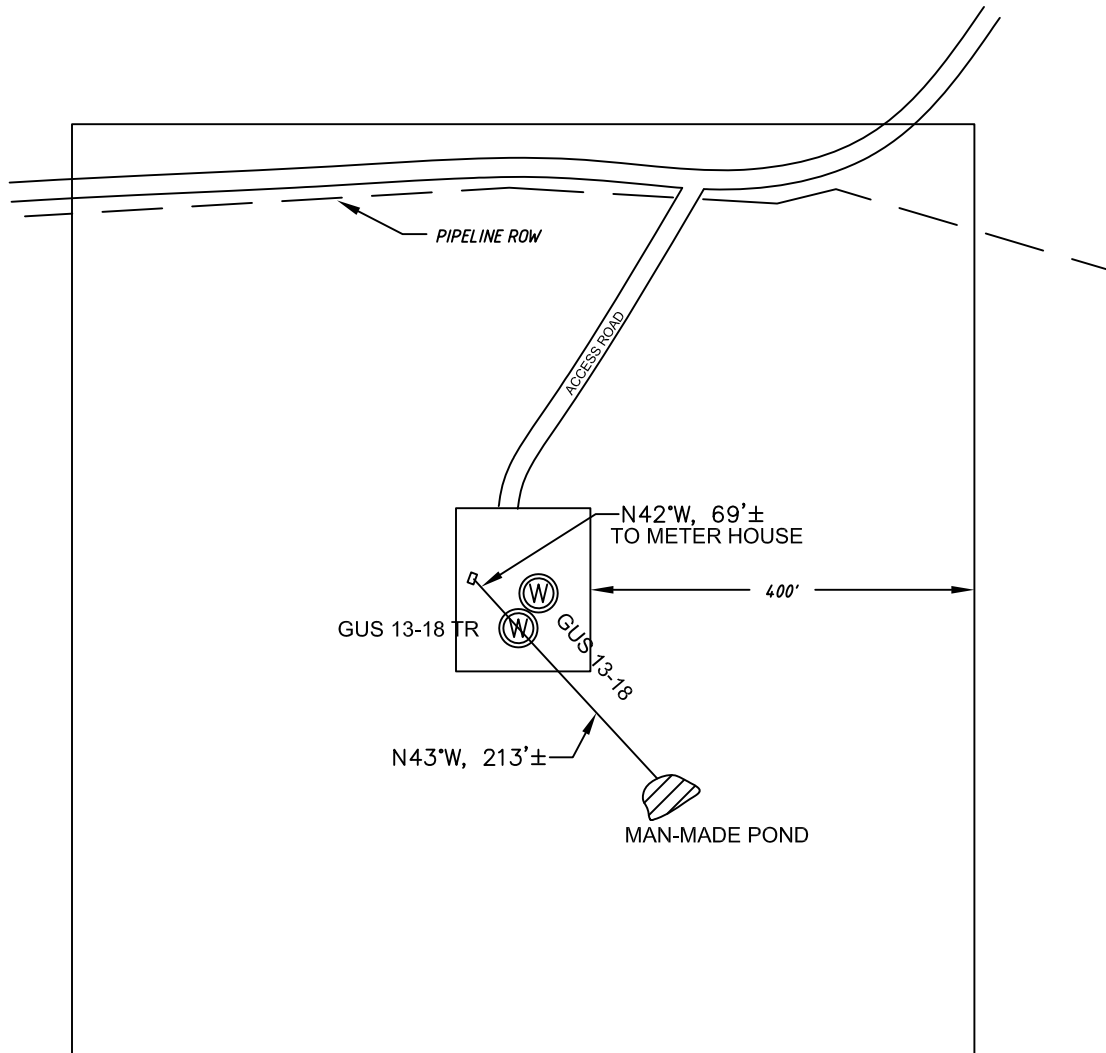


SURFACE USE: **RANGELAND**

## NOTE:

FOOTAGES GIVEN ARE ONLY ESTIMATES BASED ON SUBDIVISION PLATS AND TIED TO EXISTING CONTROL. A FULL BOUNDARY SURVEY IS REQUIRED TO DETERMINE TRUE SUBDIVISION LOT AND ROAD LOCATIONS, DISTANCES AND AREA OR FOOTAGE CALCULATIONS.

DATE: Sept 30, 2009

## GRAPHIC SCALE

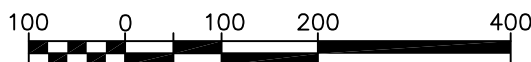

( IN FEET )  
1 inch = 200 ft.

**SHIELDS SURVEY L<sup>td.</sup> C<sup>o.</sup>**  
Raton, New Mexico 87740  
(575)445-1232