


VISIBLE IMPROVEMENTS SKETCH WRIGHT-GOIN C07-29D

SECTION 7, TOWNSHIP 4 NORTH, RANGE 64 WEST OF THE 6TH PRINCIPLE MERIDIAN

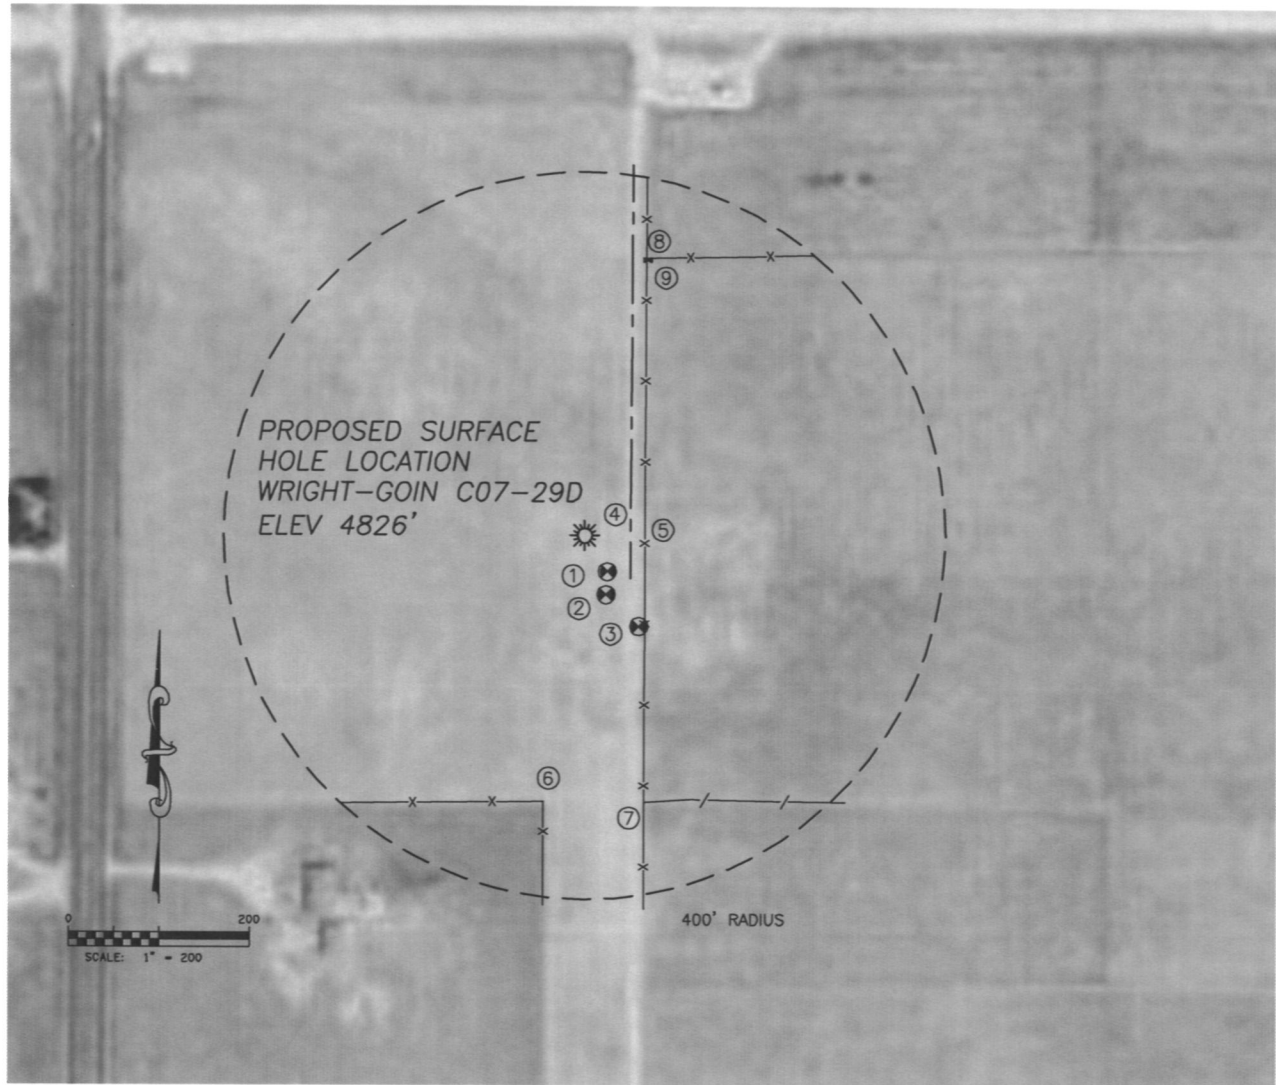

①

WRIGHT-GOIN
07-28D
47' SE

②

WRIGHT-GOIN
07-31D
69' SE

③

GEMINI C7-4
116' SE

④

CENTERLINE
ACCESS ROAD
50' EAST

⑤

WIRE FENCE
67' EAST

⑥

FENCE CORNER
295' SOUTH

⑦

FENCE CORNER
296' SE

⑧

WATER SPIGOT
308' NORTH

⑨

FENCE CORNER
312' NORTH