


LOCATION DRAWING

Sec 24  
T 5 N  
R 67 W

Baseline Engineering Corp. 710 11th Avenue Suite 105 Greeley, Colorado 80631

VISIBLE IMPROVEMENTS

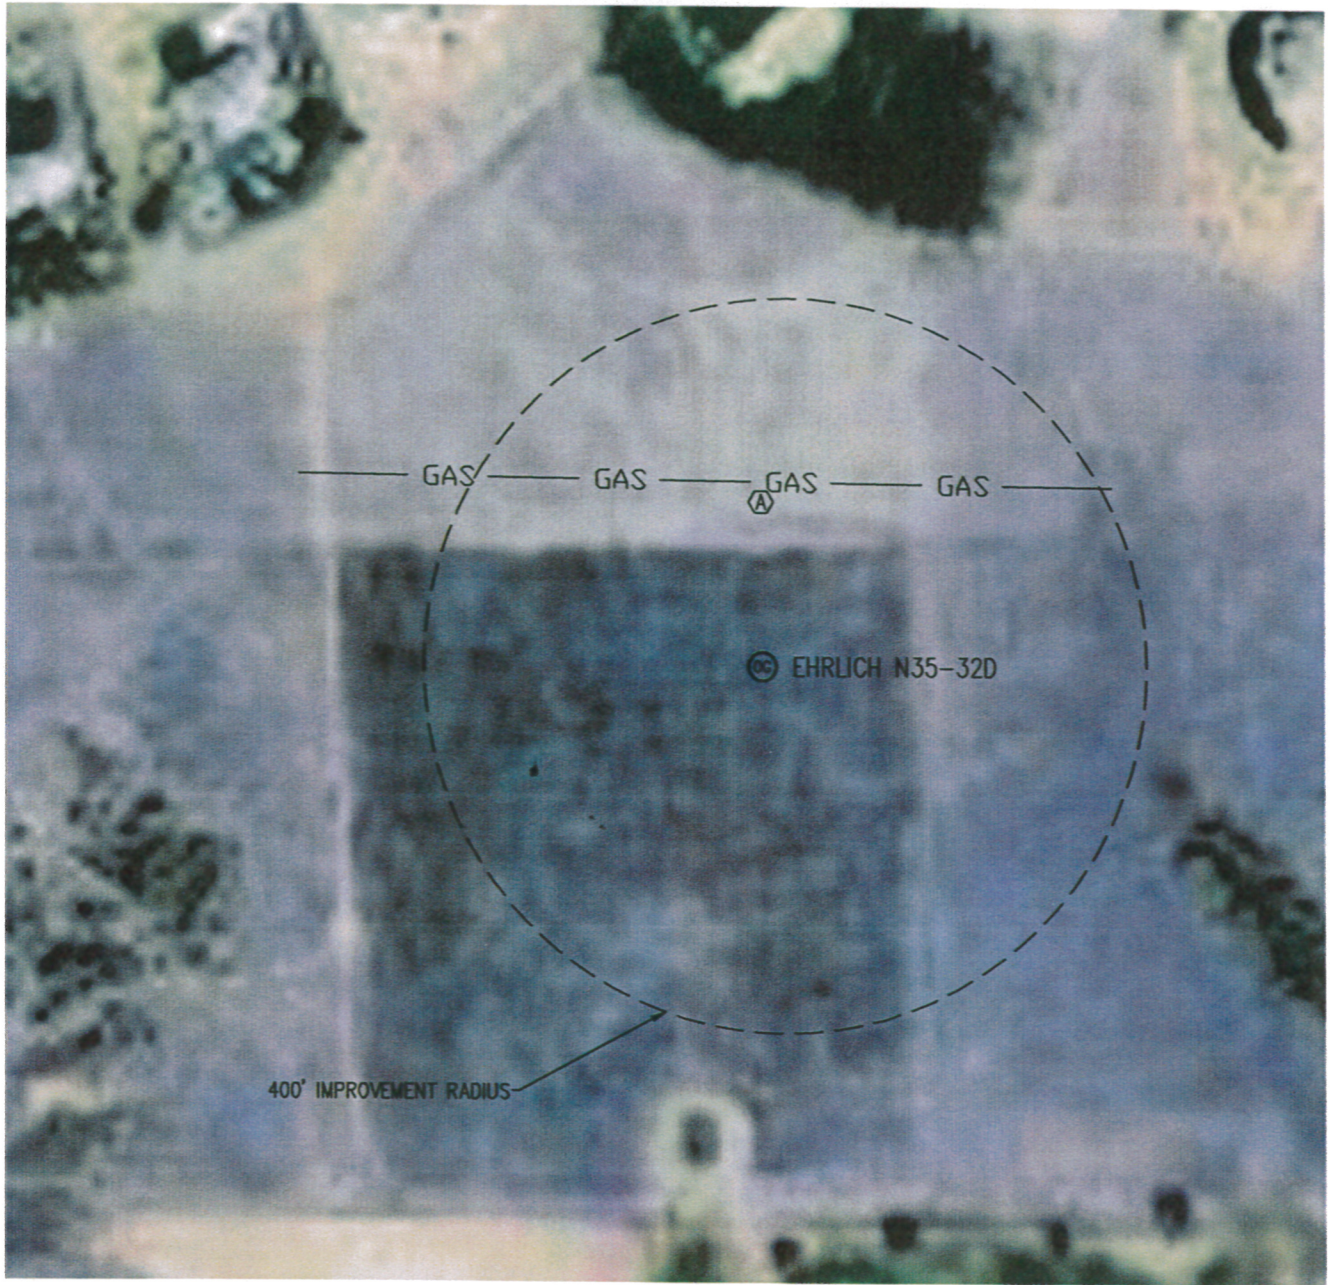

IMPROVEMENTS:

- Ⓐ GAS LINE 200' NORTH  
(AS PER SURFACE MARKERS)

NOTE

The size, type and location of underground utilities shown hereon are approximate, and are based on markings made by utility locate companies. It is not guaranteed that all utilities have been located. It shall be the responsibility of the contractor to verify the existence of all underground utilities in the area of the work before commencing new construction.

