


Location Drawing Rattler 33-23 TR

FROM PROPOSED WELL TO EXISTING WELL: **S46°W, 105'±**

FROM EXISTING WELL TO GAS DRIVE SYSTEM: **S46°E, 20'±**

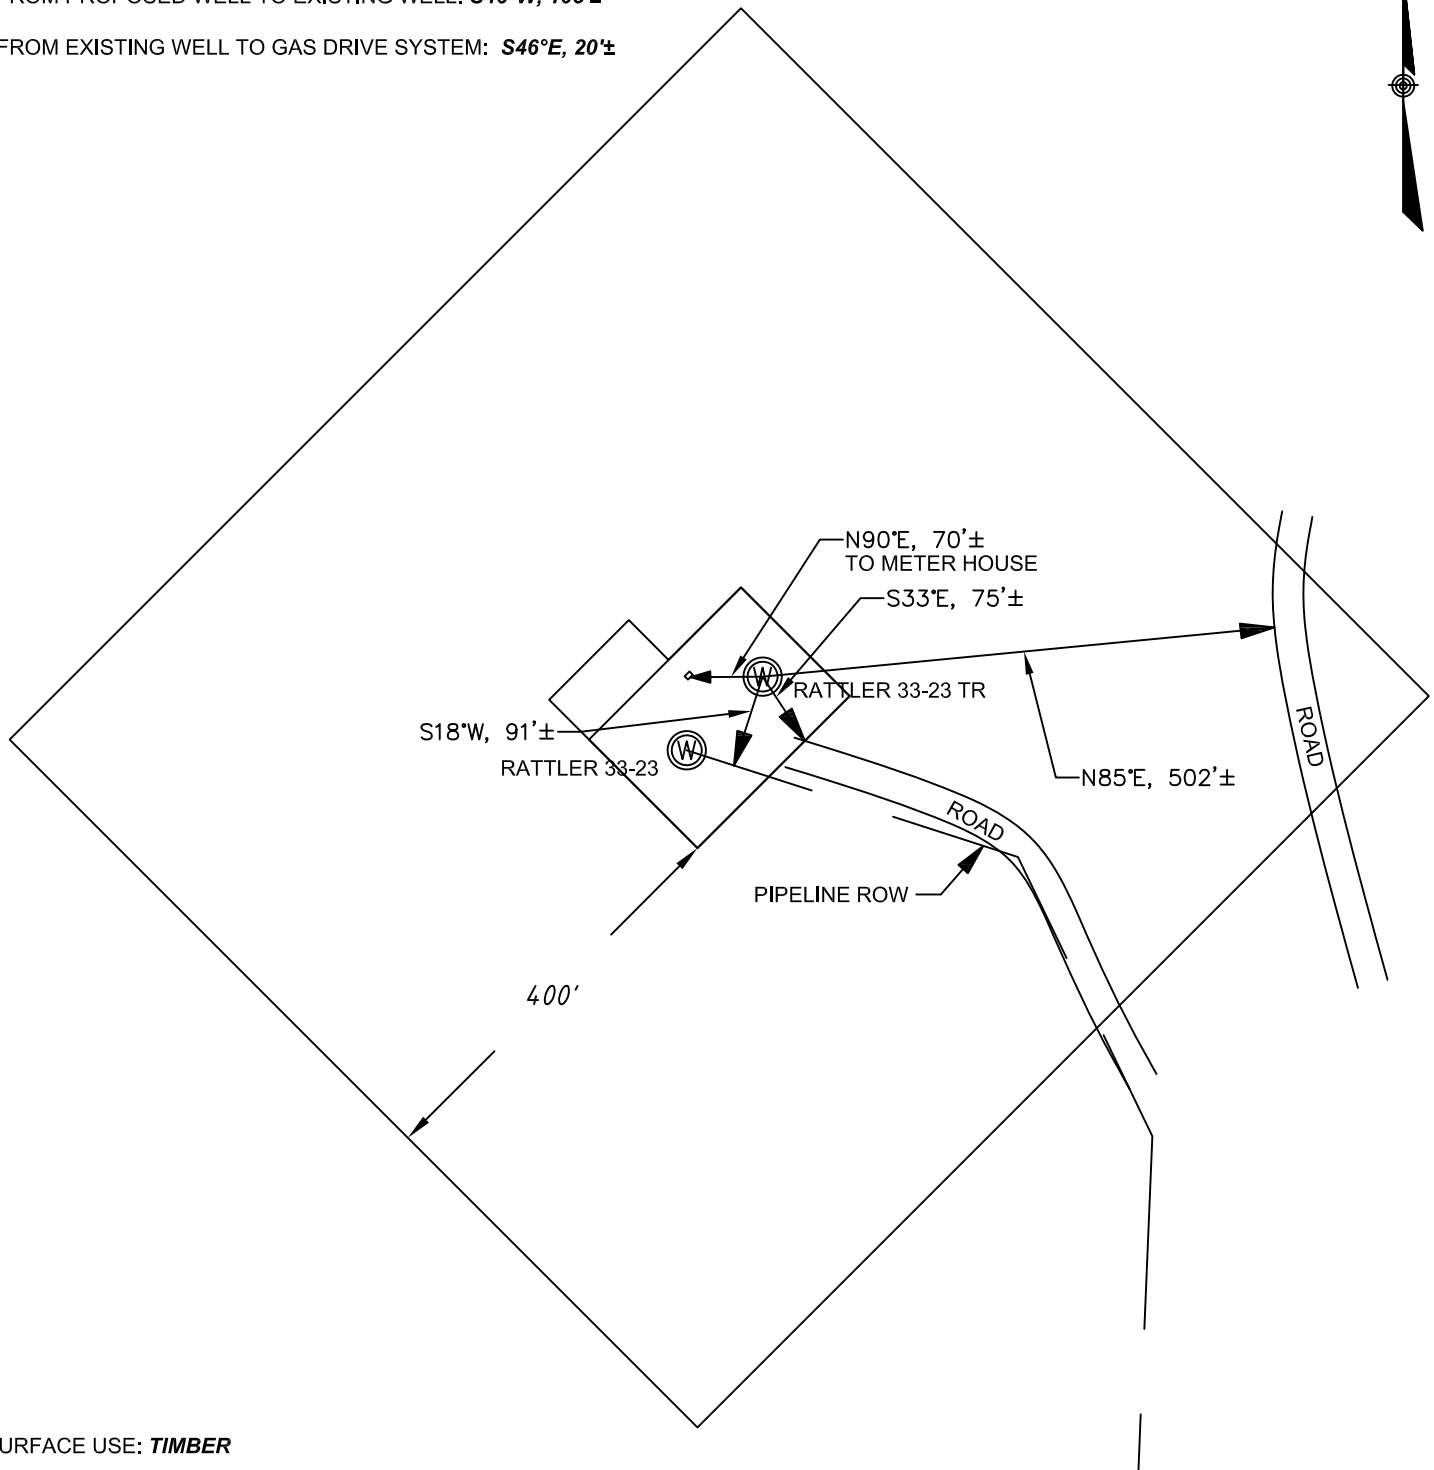


SURFACE USE: **TIMBER**

NOTE:

FOOTAGES GIVEN ARE ONLY ESTIMATES BASED ON SUBDIVISION PLATS AND TIED TO EXISTING CONTROL. A FULL BOUNDARY SURVEY IS REQUIRED TO DETERMINE TRUE SUBDIVISION LOT AND ROAD LOCATIONS, DISTANCES AND AREA OR FOOTAGE CALCULATIONS.

DATE: October 12, 2009

GRAPHIC SCALE

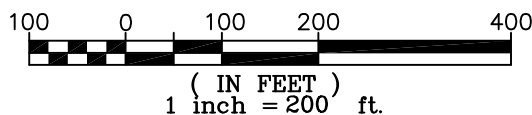

SHIELDS SURVEY Ltd. Co.
Raton, New Mexico 87740
(575)445-1232