


# Multi Well Plan

## SITE SKETCH - STROHAUER F33-32D

SECTION 32  
TOWNSHIP 5 NORTH  
RANGE 65 WEST

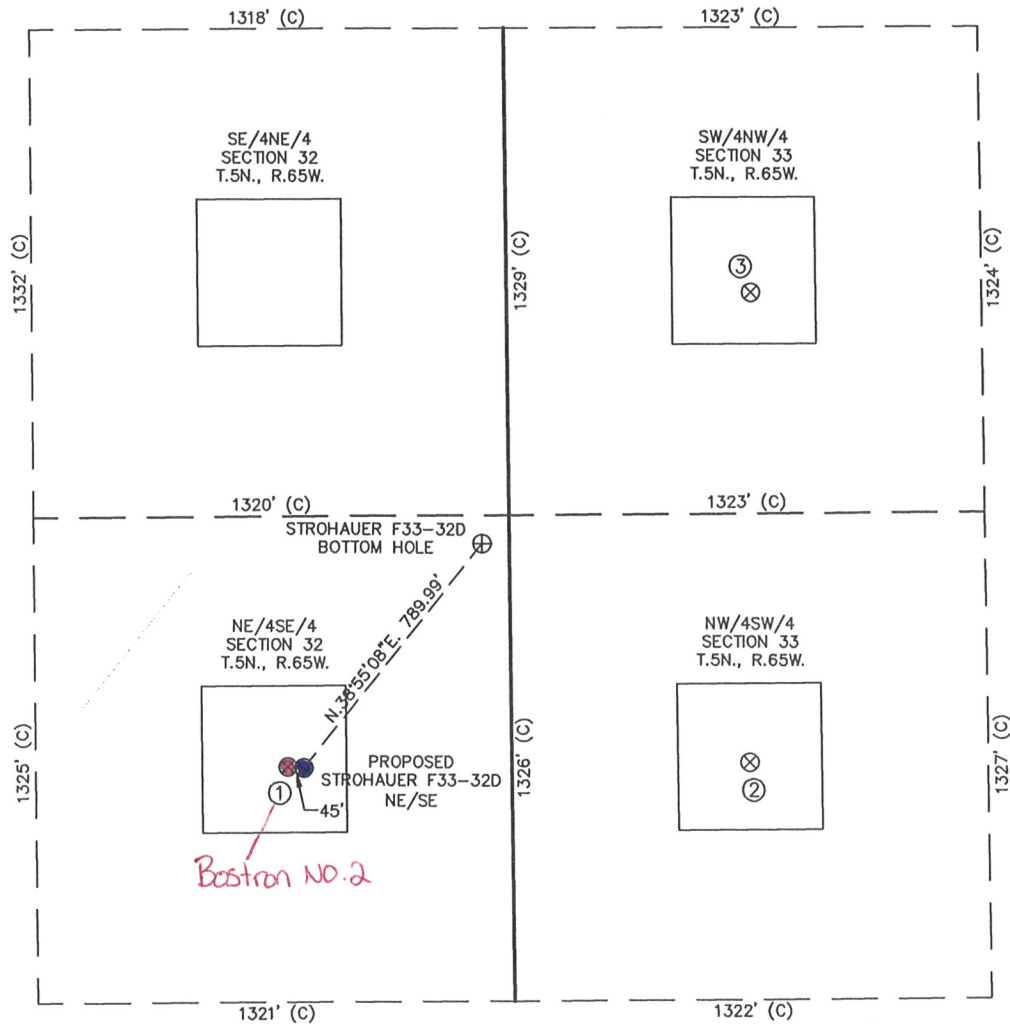

①	②	③	④
BOSTROM NO. 2	KEISER NO. 2	ALLES 33-4	
NE/SE SEC. 32	NW/SW SEC. 33	SW/NW SEC. 33	
1967' FSL	1974' FSL	2054' FNL	
622' FEL	661' FWL	681' FWL	
EL 4667'	EL 4663'	EL 4665'	
N 40.35388	N 40.35389	N 40.35741	
W 104.68009	W 104.67548	W 104.67541	
PDOP 2.3	PDOP 2.8	PDOP 1.8	

### NOTES:

- THIS SKETCH DOES NOT REPRESENT A BOUNDARY SURVEY.
- THE DATUM FOR THE LATITUDES AND LONGITUDES ON THIS SKETCH IS NAD83.

