


DALEY LAND SURVEYING, INC. PARKER, CO. 80134 303 953 9841

## HYDROLOGY MAP

SCHOTT B33-25, *Schott B33-21D, Schott B33-20D*

SECTION 33, TOWNSHIP 5 NORTH, RANGE 64 WEST OF THE 6TH PRINCIPLE MERIDIAN

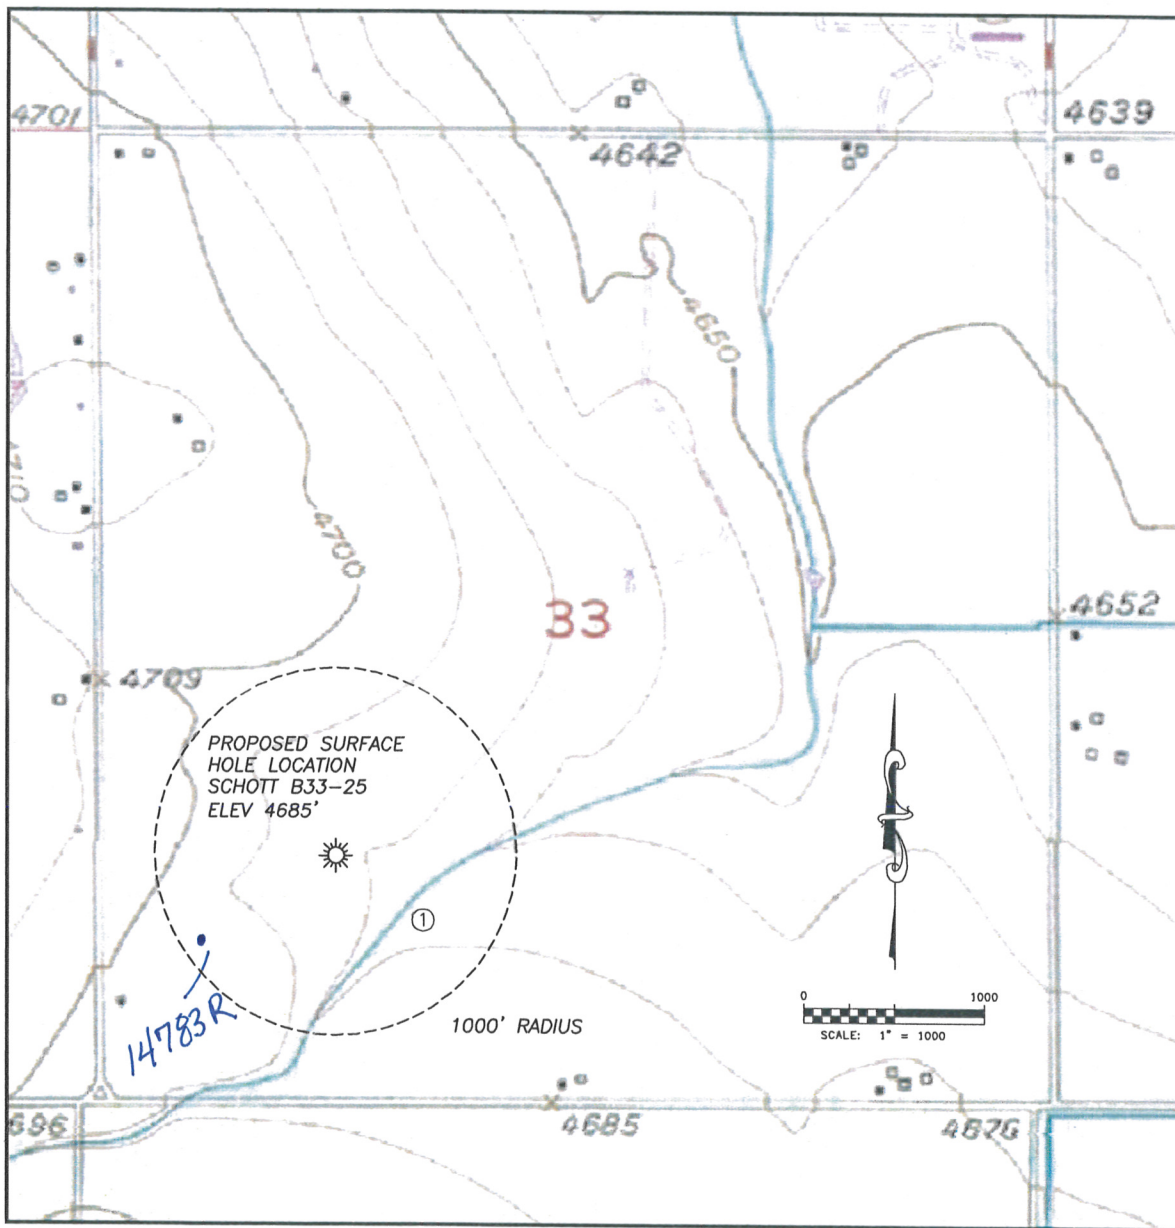

①  
APPROXIMATE  
CENTERLINE CREEK  
S58°20'E 480'±