


Location Drawing

DALEY LAND SURVEYING, INC. PARKER, CO. 80134 303 953 9841

VISIBLE IMPROVEMENTS SKETCH

SCHOTT B33-25, Schott B 33-21D, Schott B 33-20D

SECTION 33, TOWNSHIP 5 NORTH, RANGE 64 WEST OF THE 6TH PRINCIPLE MERIDIAN

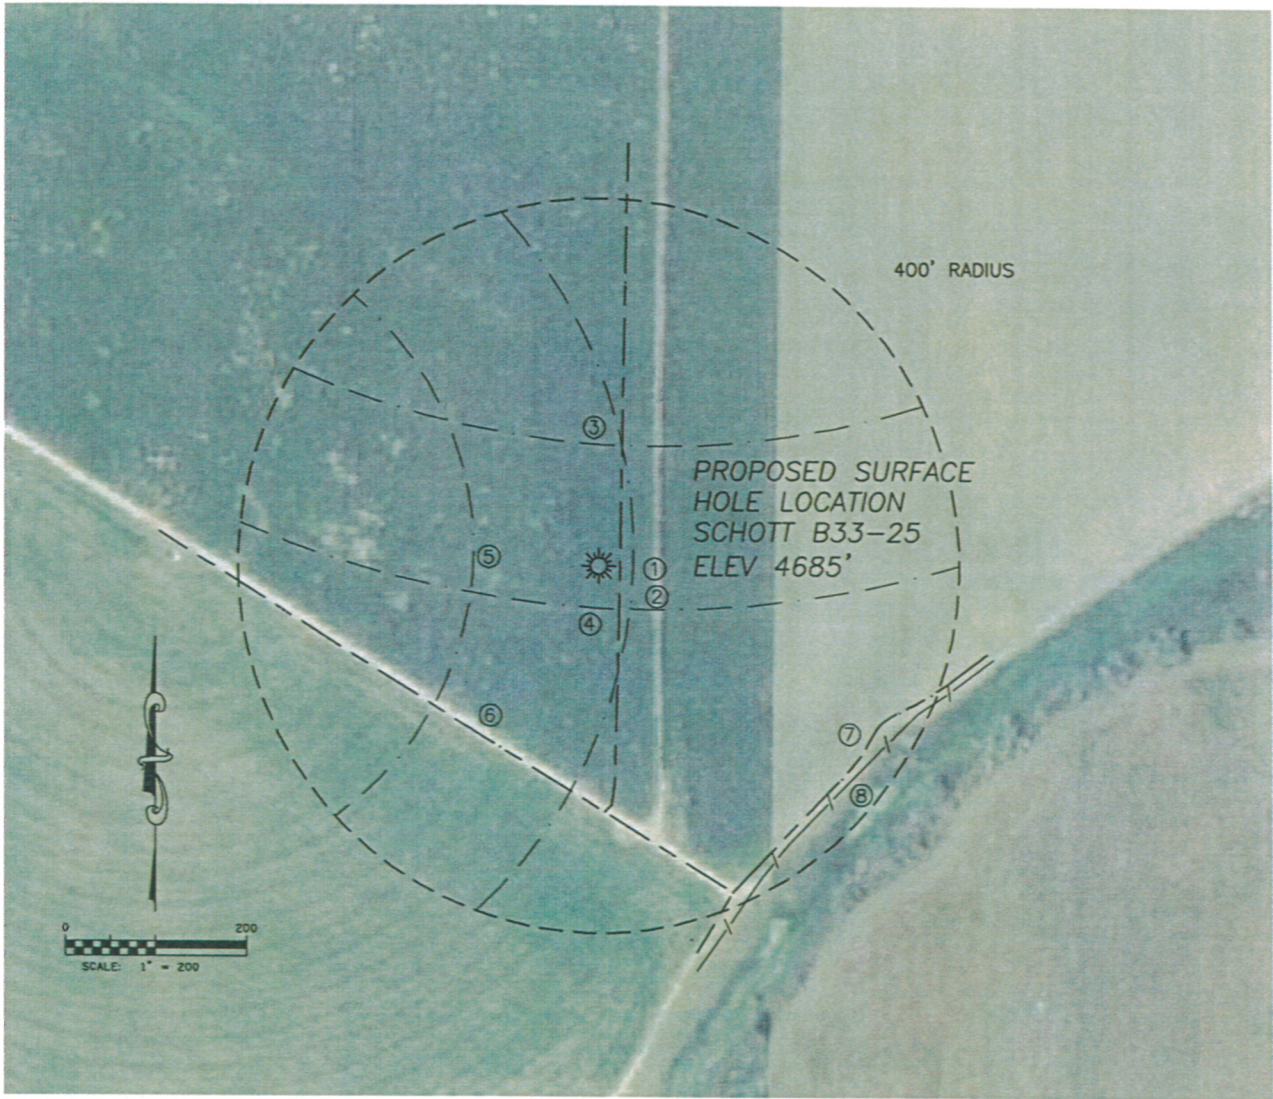

①
CENTERLINE
FIELD ROAD
23' EAST

②
PIVOT WHEEL
TRACK
39' EAST

③
PIVOT WHEEL
TRACK
132' NORTH

④
PIVOT WHEEL
TRACK
46' SOUTH

⑤
PIVOT WHEEL
TRACK
139' WEST

⑥
CENTERLINE
FIELD ROAD
226' SW

⑦
CENTERLINE
FIELD ROAD
356' SE

⑧
WIRE FENCE
364' SE