



LOCATION DRAWING

NE1/4 OF SECTION 28, TOWNSHIP 6 NORTH, RANGE 63 WEST, 6TH P.M.

N1/4 SEC 28

NE SEC 28

NWNE WELL FALLS IN A PASTURE.
 AN OLD FIELD ROAD IS 120' SE.
 AN OLD ENCLOSURE FOR PIPE RISER IS 250' NE.
 AN OLD CONCRETE VAULT FOR AN OLD WELL IS 335' ENE.
 NO OTHER VISIBLE IMPROVEMENTS WITHIN 400'.

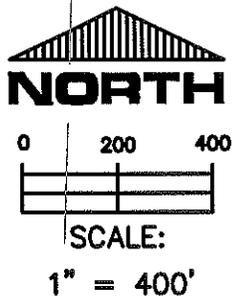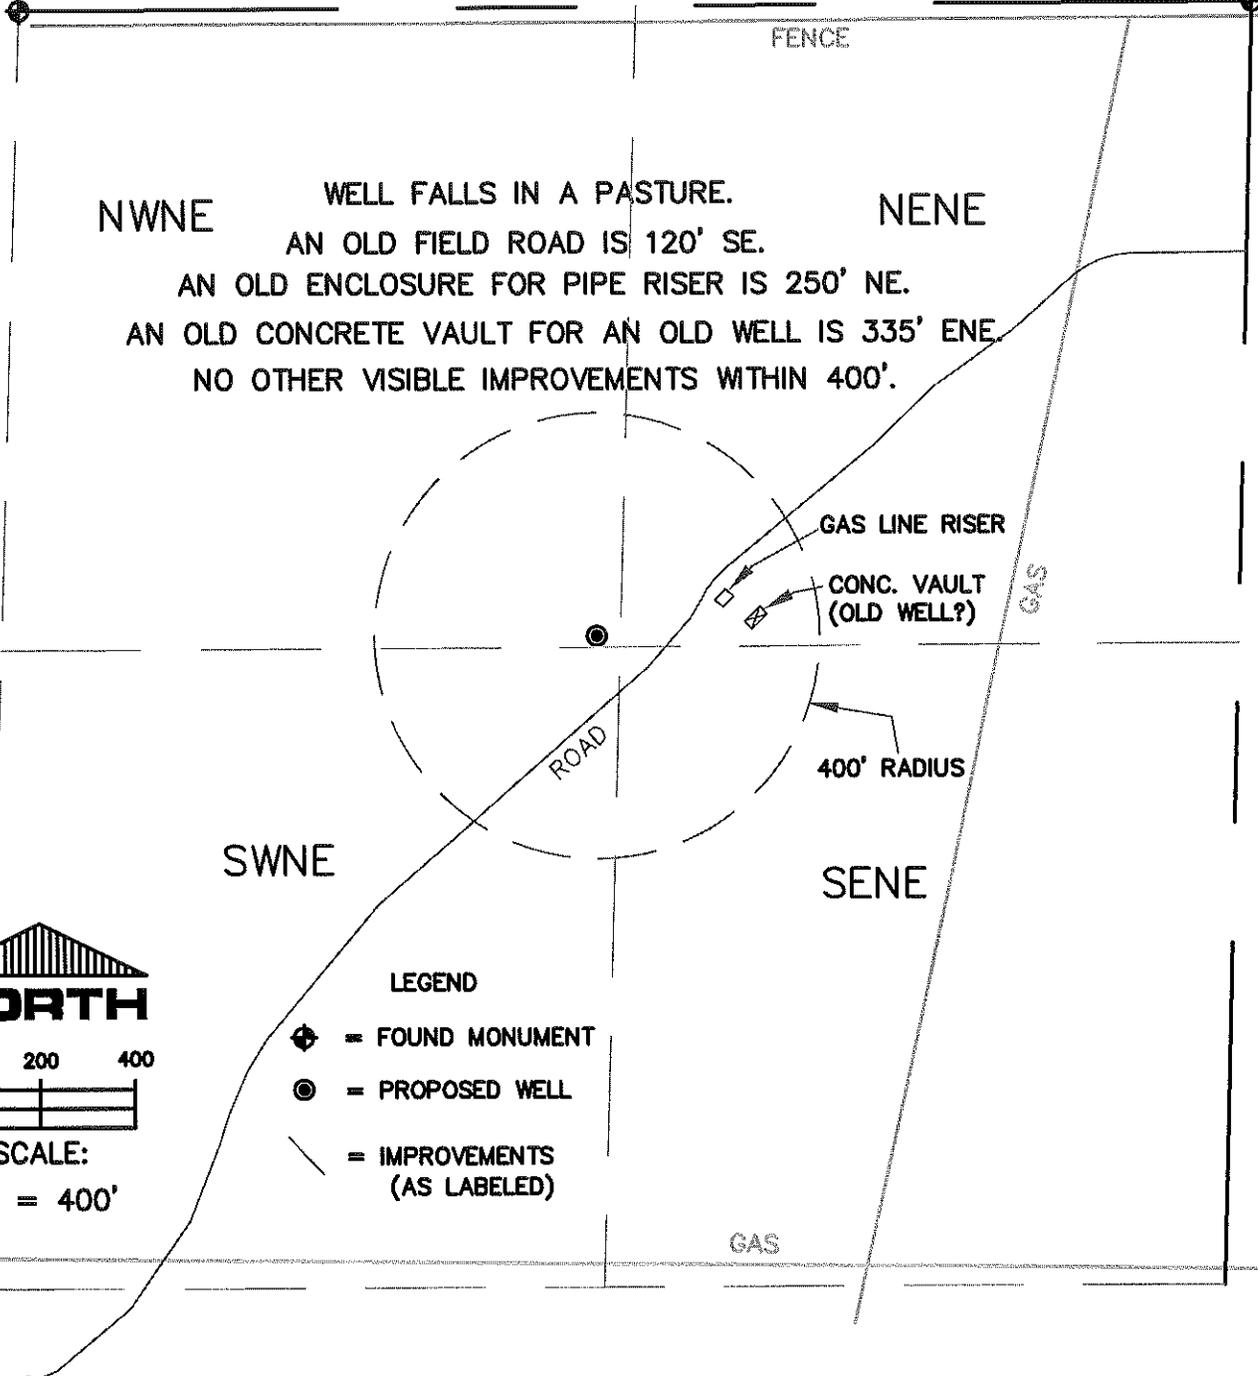

LEGEND

- = FOUND MONUMENT
- = PROPOSED WELL
- = IMPROVEMENTS (AS LABELED)

THIS IS NOT A MONUMENTED BOUNDARY SURVEY, IT IS ONLY A DRAWING INTENDED TO DEPICT VISIBLE IMPROVEMENTS AROUND WELL SITE(S).

PREPARED BY:	HORSESHOE SURVEYING, LLC PO BOX 150458 LAKEWOOD, CO 80215 (720)872-0196	WELL NAME: WELLS RANCH STATE 28C
DRAWING DATE: 10-17-09		LOCATION: WELD COUNTY, CO NE1/4, SEC. 28, T6N, R63W, 6TH P.M.
FIELD DATE: 10-15-09		