


WELL LOCATION CERTIFICATE

NW CRN SEC. 28
3.25°AC LS 28258

SECTION 28, TOWNSHIP 6 NORTH, RANGE 63 WEST, 6TH P.M.

NE CRN SEC 28
3.25°AC LS 37068

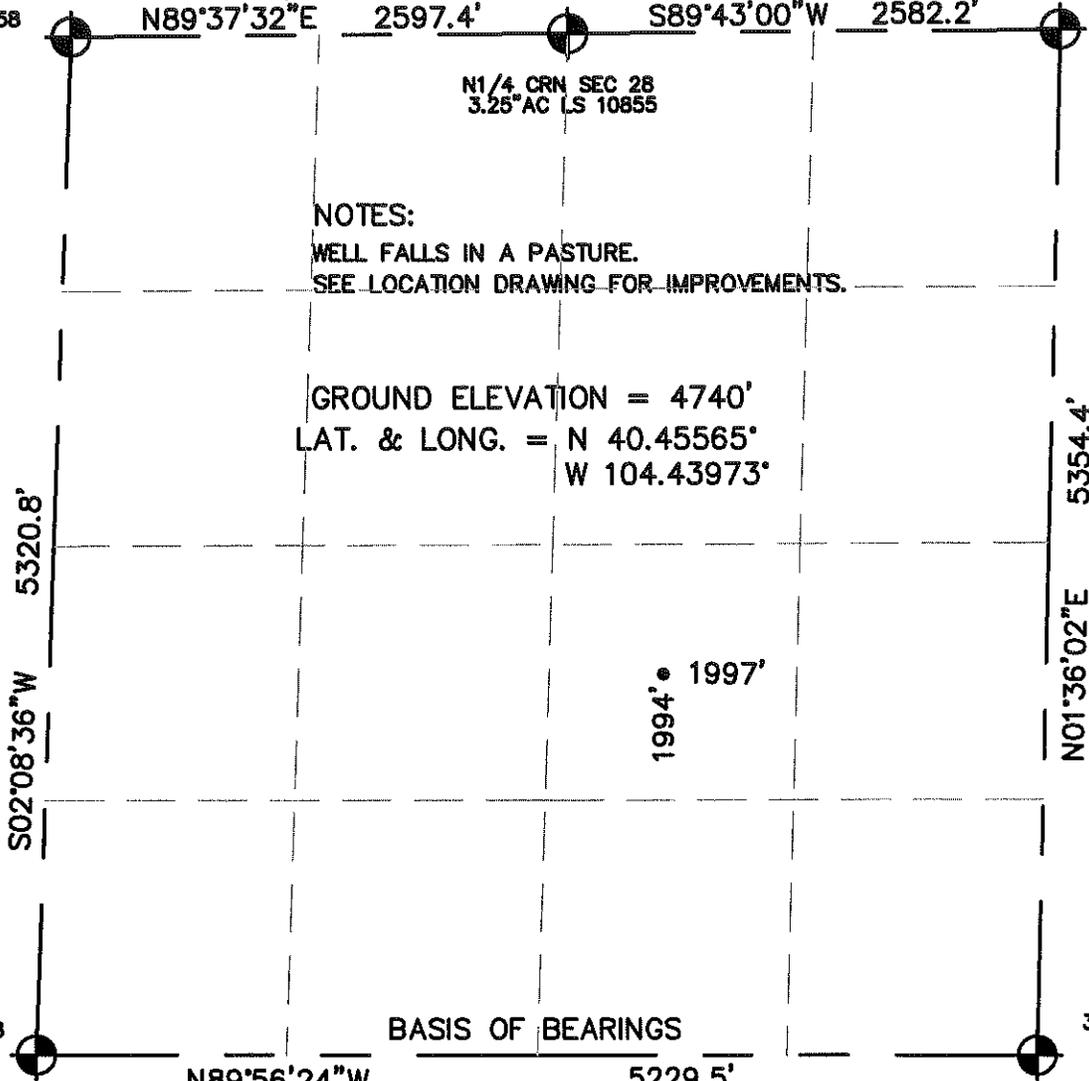

NOTES:
WELL FALLS IN A PASTURE.
SEE LOCATION DRAWING FOR IMPROVEMENTS.

GROUND ELEVATION = 4740'
LAT. & LONG. = N 40.45565°
W 104.43973°

1994' • 1997'


BASIS OF BEARINGS

I HEREBY STATE TO PETROLEUM DEV. CORP. THAT THIS WELL LOCATION CERTIFICATE FOR THE WELL WELLS RANCH STATE 33-28 IS LOCATED 1994' FSL & 1997' FEL, SEC. 28, T6N, R63W, 6PM.



LEGEND

-  = FOUND MONUMENT
-  = PROPOSED WELL
-  = IMPROVEMENTS (AS LABELED)

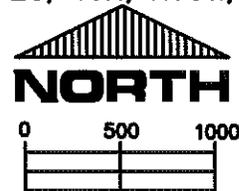

SCALE 1" = 1000'

ELEVATION SOURCE = USGS 7.5' QUAD.MAP CONTOURS NGVD 1929 DATUM.

LAT. & LONG. ARE DIFFERENTIALLY CORRECTED (NAD'83) USING (DGPS) WITH (PDOP) VALUES LESS THAN SIX (6).

SHOWN DISTANCES ARE FIELD MEASURED - EXTERIOR SECTION LINES ARE DRAWN TO SCALE (BEST APPROX. OR FOUND MONUMENT).

THOMAS G. CARLSON, PLS 24657
HORSESHOE SURVEYING, LLC

THIS IS NOT A MONUMENTED BOUNDARY SURVEY, IT IS ONLY A DRAWING INTENDED TO DEPICT THE WELL LOCATION TO SECTION LINES.

DISTANCES TO WELL SHOWN PERPENDICULAR TO SECTION LINES.

PREPARED BY: HORSESHOE SURVEYING, LLC PO BOX 150458 LAKEWOOD, CO 80215 (720)872-0196		WELL NAME: WELLS RANCH STATE 33-28	
DRAWING DATE: 10-16-09		LOCATION: WELD COUNTY, CO NWSE, SEC. 28, T6N, R63W, 6TH P.M.	
FIELD DATE: 10-14-09	BY: TGC	CHKD:	JOB NO. SHEET NO. 1 OF 1