


Location Drawing Lynn 32-4 TR

FROM PROPOSED WELL TO EXISTING WELL: $N66^{\circ}E, 89' \pm$

FROM EXISTING WELL TO GAS DRIVE SYSTEM: $S65^{\circ}W, 80' \pm$

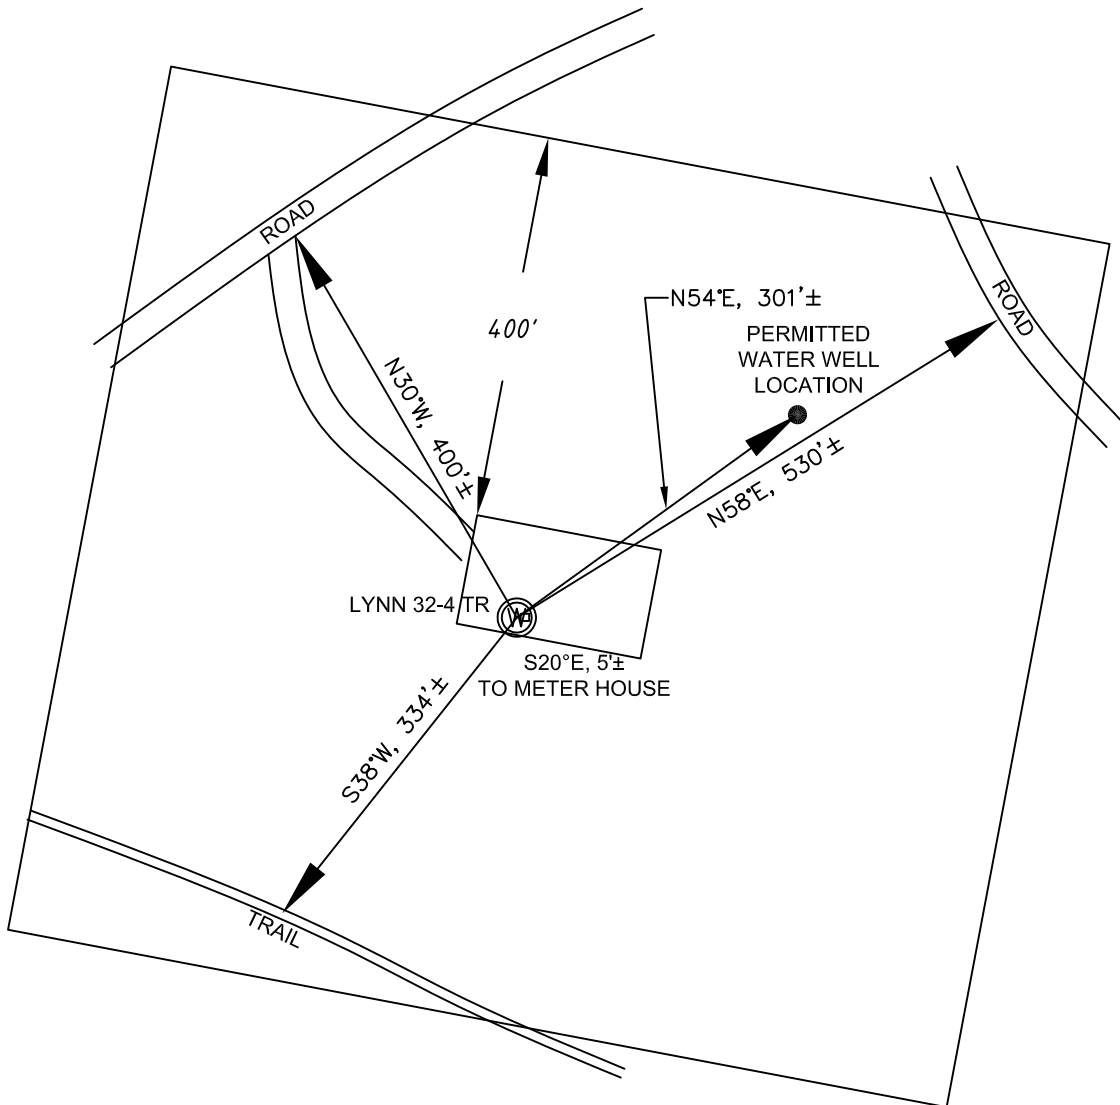


SURFACE USE: **TIMBER**

NOTE:

FOOTAGES GIVEN ARE ONLY ESTIMATES BASED ON SUBDIVISION PLATS AND TIED TO EXISTING CONTROL. A FULL BOUNDARY SURVEY IS REQUIRED TO DETERMINE TRUE SUBDIVISION LOT AND ROAD LOCATIONS, DISTANCES AND AREA OR FOOTAGE CALCULATIONS.

DATE: October 13, 2009

GRAPHIC SCALE

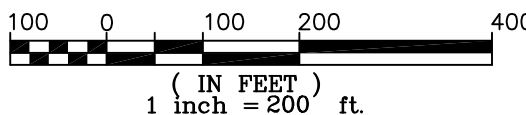

SHIELDS SURVEY Ltd. Co.
Raton, New Mexico 87740
(575)445-1232