


Location Drawing Foothills 12-36 TR

FROM PROPOSED WELL TO EXISTING WELL: $N 40^{\circ} E, 65' \pm$

FROM EXISTING WELL TO GAS DRIVE SYSTEM: $S 28^{\circ} W, 104' \pm$

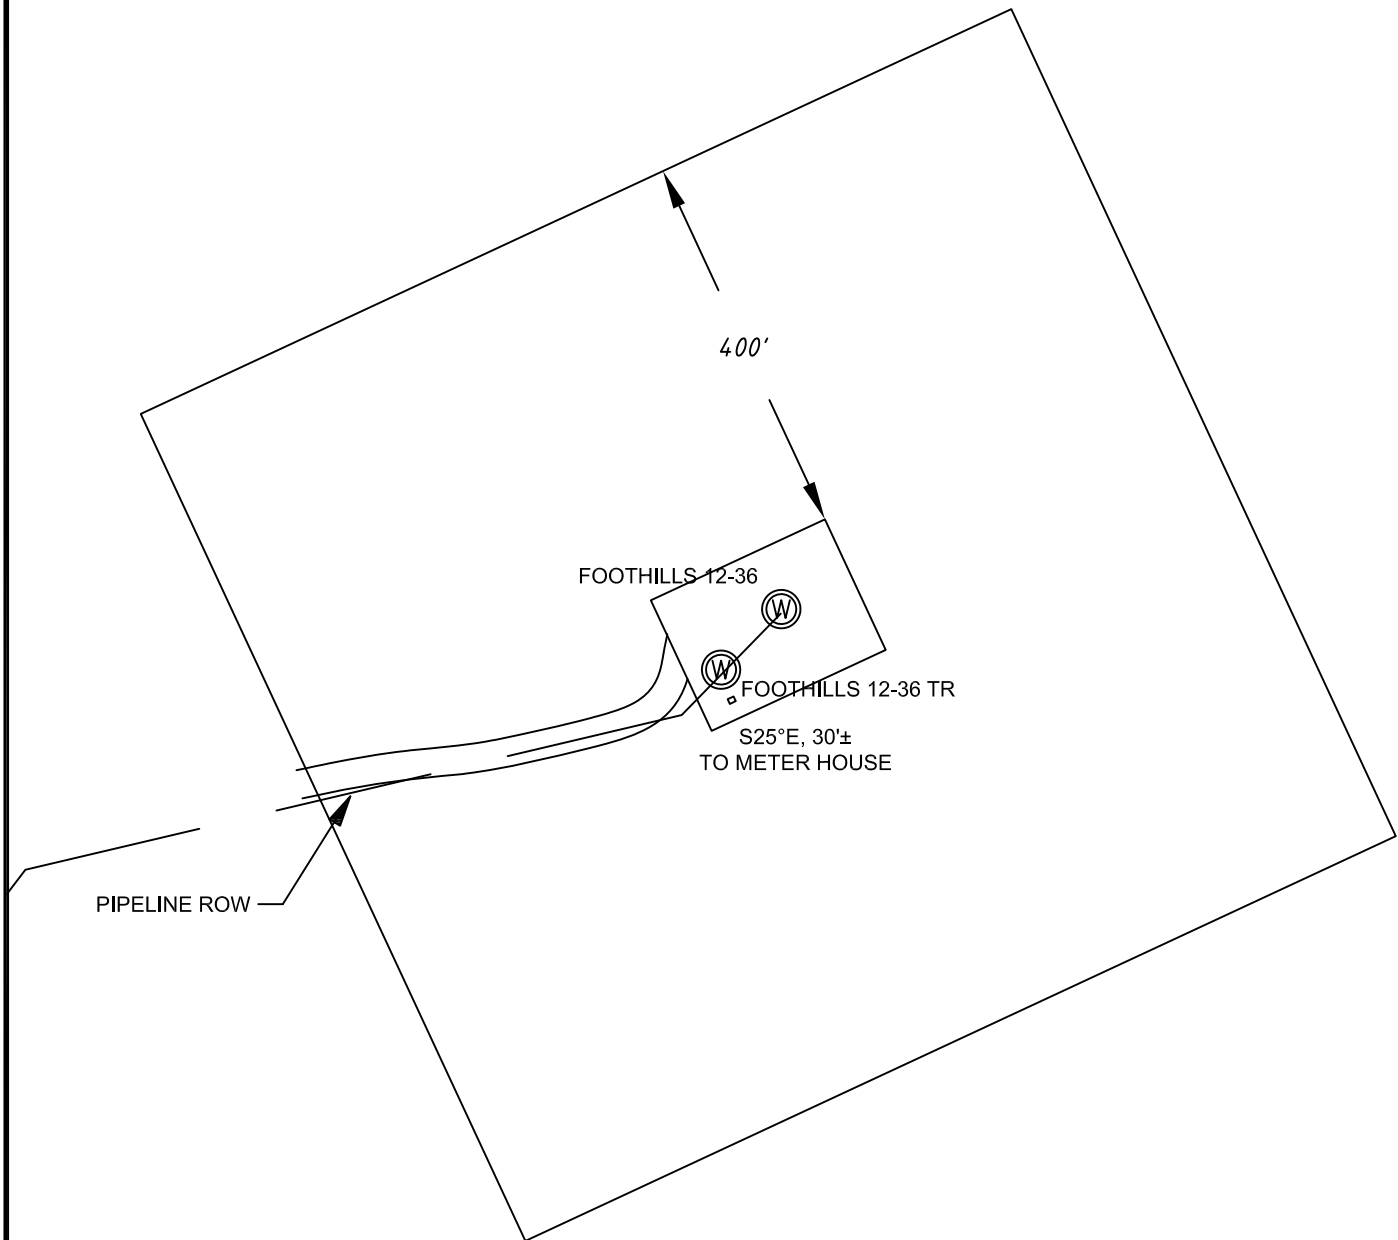


SURFACE USE: **TIMBER**

NOTE:

FOOTAGES GIVEN ARE ONLY ESTIMATES BASED ON SUBDIVISION PLATS AND TIED TO EXISTING CONTROL. A FULL BOUNDARY SURVEY IS REQUIRED TO DETERMINE TRUE SUBDIVISION LOT AND ROAD LOCATIONS, DISTANCES AND AREA OR FOOTAGE CALCULATIONS.

DATE: October 13, 2009

GRAPHIC SCALE

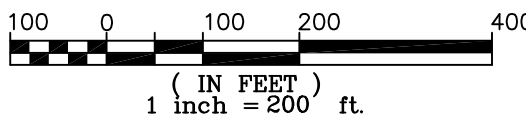

SHIELDS SURVEY Ltd. Co.
Raton, New Mexico 87740
(575)445-1232