


Location Drawing Nataly Federal 21-18

FROM EXISTING WELL TO GAS DRIVE SYSTEM: $N 70^{\circ} E, 90' \pm$

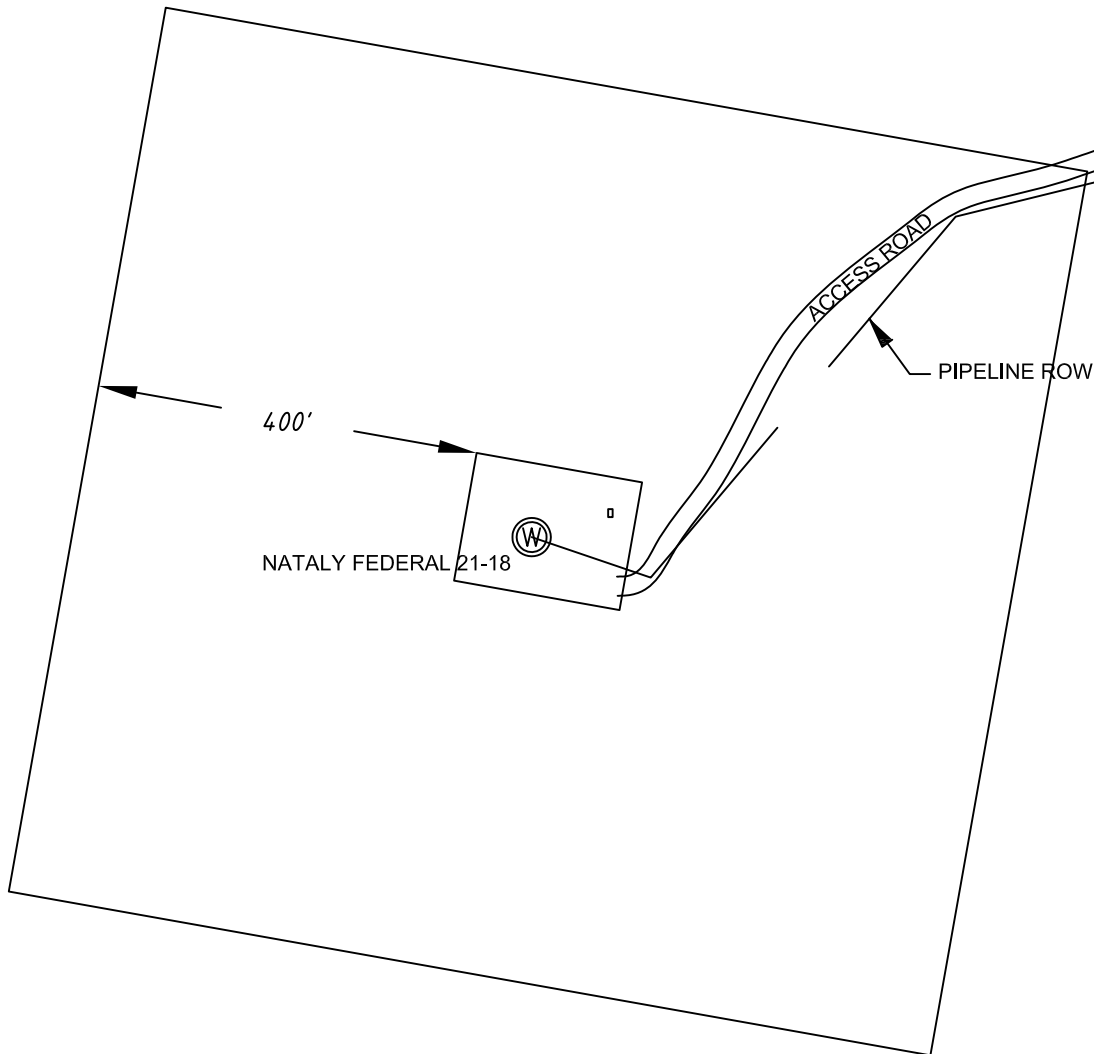


SURFACE USE:TIMBER

NOTE:

FOOTAGES GIVEN ARE ONLY ESTIMATES BASED ON SUBDIVISION PLATS AND TIED TO EXISTING CONTROL. A FULL BOUNDARY SURVEY IS REQUIRED TO DETERMINE TRUE SUBDIVISION LOT AND ROAD LOCATIONS, DISTANCES AND AREA OR FOOTAGE CALCULATIONS.

DATE: October 22, 2009

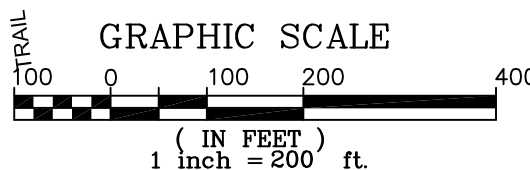

SHIELDS SURVEY Ltd. Co.
Raton, New Mexico 87740
(575)445-1232