


# Location Drawing

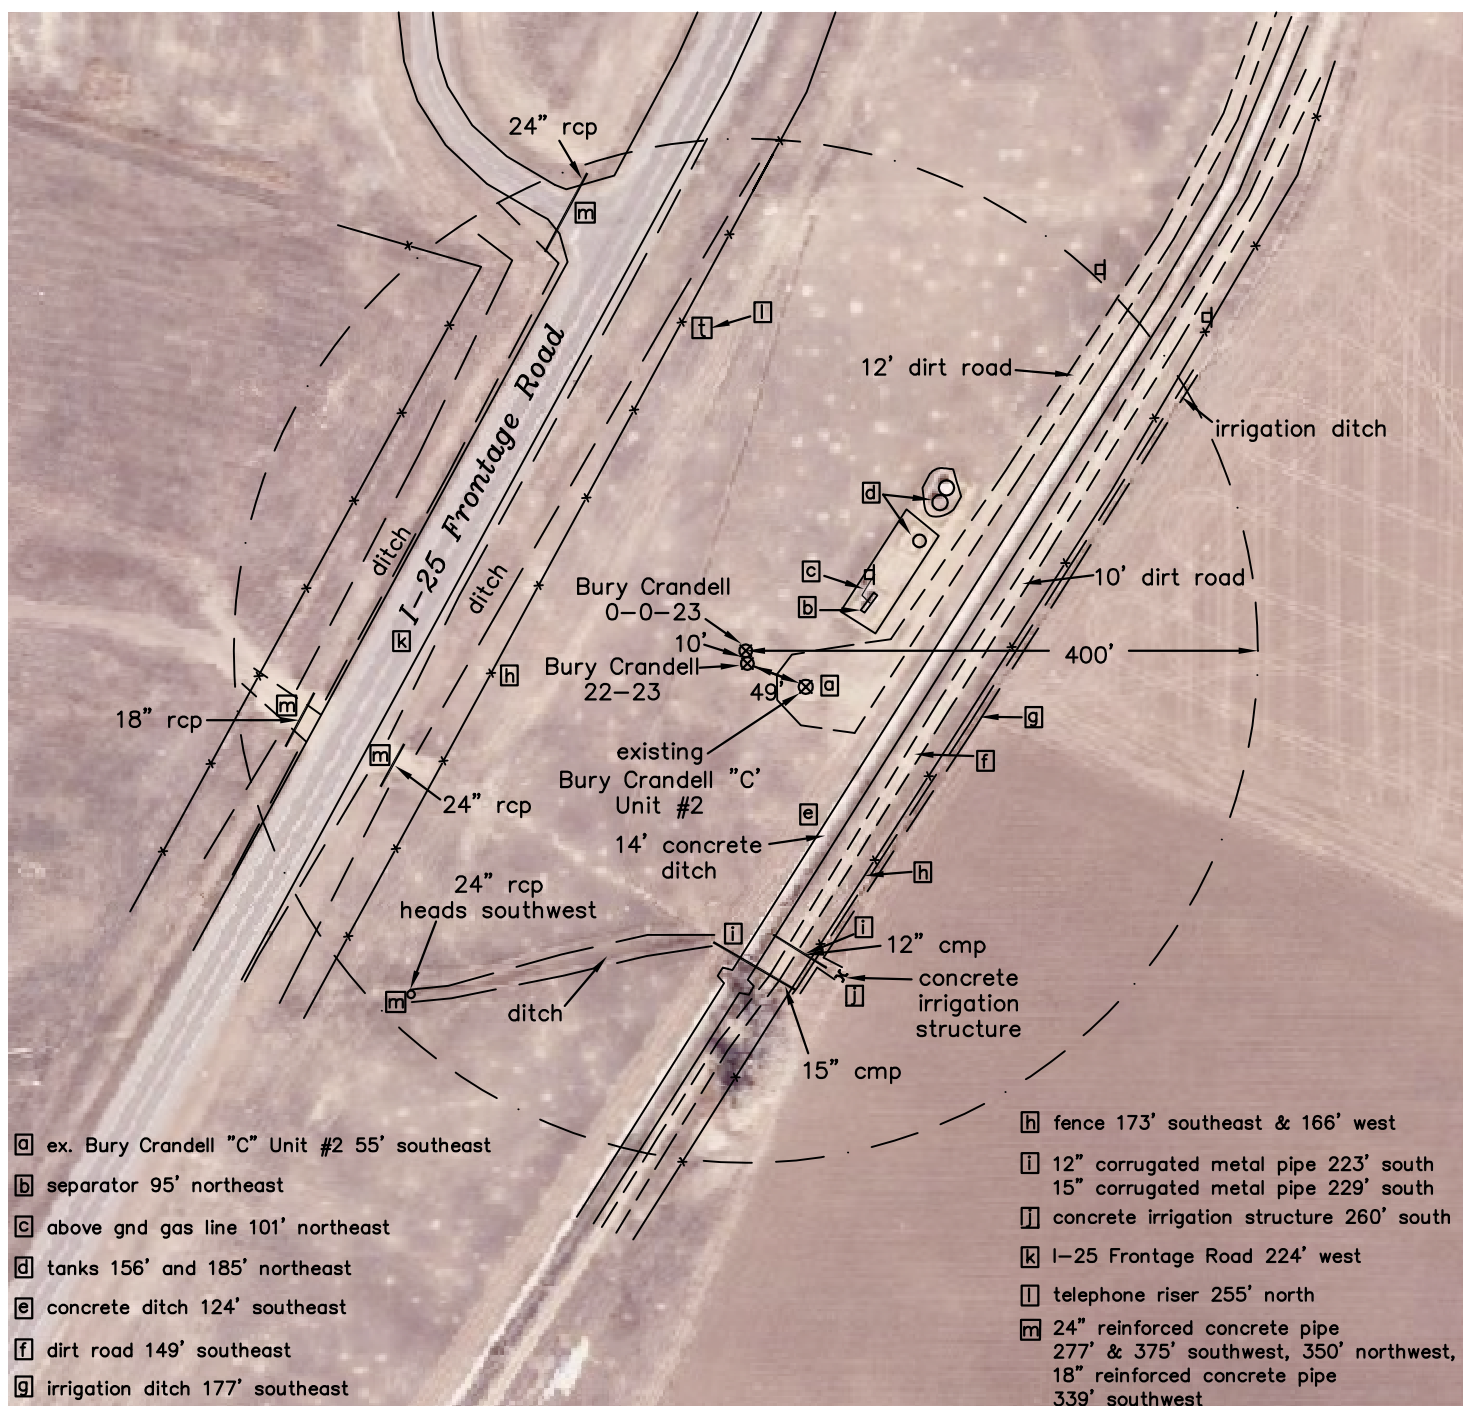

## Legend:

- - denotes gas sign
- ⊞ - denotes telephone riser

Frederick Land Surveying, Inc.  
6760 North Franklin Avenue  
Loveland, Colorado 80538  
(970) 669-2100 - Fax (970) 669-3725



## Well Site Bury Crandell 22-23 & 0-0-23

### IMPROVEMENTS WITHIN 400 FEET

Township 1 North, Range 68 West,  
Section 23: NW<sup>1</sup>NW<sup>1</sup>  
City and County of Broomfield, Colorado

Scale: 1"=150'

October 12, 2009