


# MULTI WELL PLAN

## SITE SKETCH - MILLAGE C12-31D

SECTION 11  
TOWNSHIP 4 NORTH  
RANGE 64 WEST

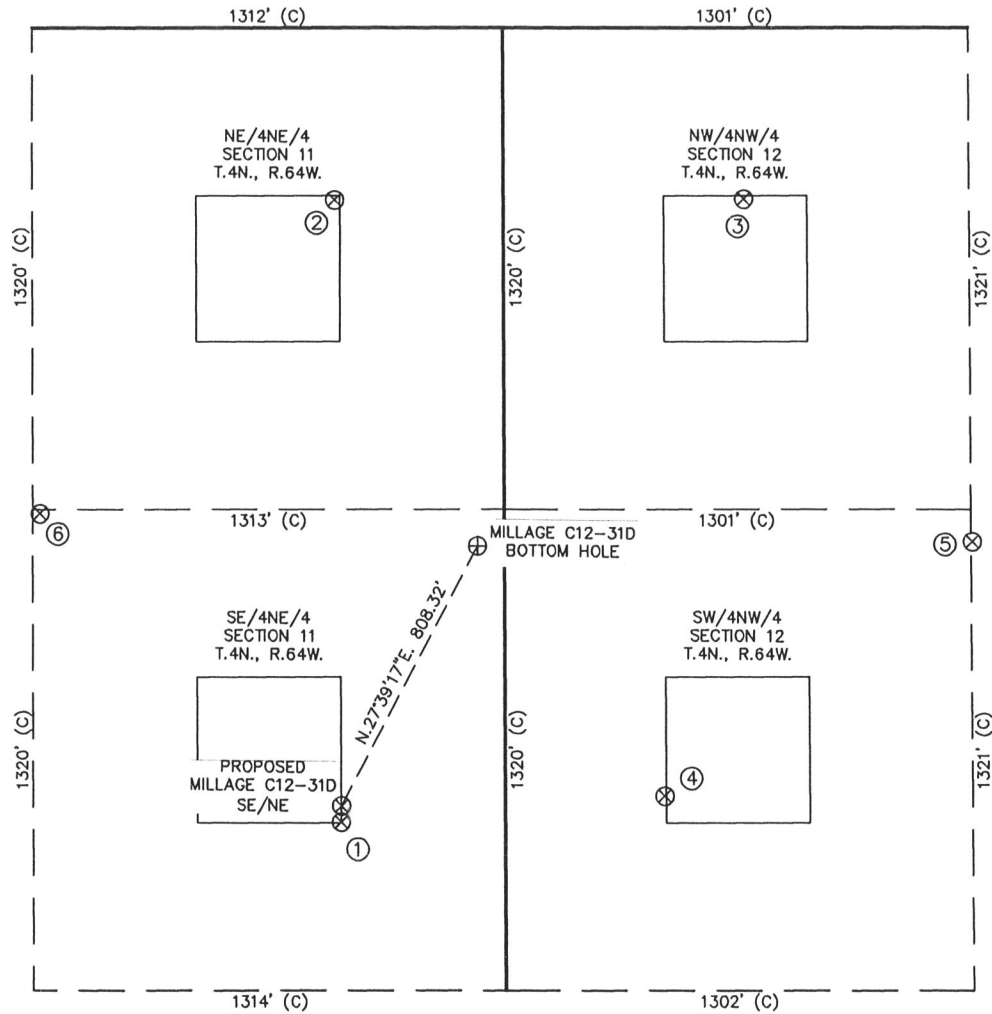

| ①  | ②   | ③   | ④  | ⑤   | ⑥  |
|--|---|---|--|---|--|
| MILLAGE C11-8<br>SE/NE SEC. 11<br>2178' FNL<br>456' FEL<br>EL 4622'<br>N 40.32820<br>W 104.50992<br>PDOP 2.1 | MILLAGE C11-1<br>NE/NE SEC. 11<br>472' FNL<br>470' FEL<br>EL 4618'<br>N 40.33288<br>W 104.50995<br>PDOP 2.1 | MILLAGE C12-4<br>NW/NW SEC. 12<br>470' FNL<br>675' FWL<br>EL 4619'<br>N 40.33288<br>W 104.50584<br>PDOP 2.1 | MILLAGE C12-5<br>SW/NW SEC. 12<br>2107' FNL<br>447' FWL<br>EL 4626'<br>N 40.32839<br>W 104.50668<br>PDOP 2.1 | MILLAGE 22-19<br>SE/NW SEC. 12<br>1408' FNL<br>1305' FWL<br>EL 4621'<br>N 40.33031<br>W 104.50360<br>PDOP 2.1 | MILLAGE C11-17<br>SE/NE SEC. 11<br>1331' FNL<br>1292' FEL<br>EL 4622'<br>N 40.33052<br>W 104.51291<br>PDOP 2.5 |

### NOTES:

- THIS SKETCH DOES NOT REPRESENT A BOUNDARY SURVEY.
- THE DATUM FOR THE LATITUDES AND LONGITUDES ON THIS SKETCH IS NAD83.



0 500

Scale: 1" = 500'