

Kubeczko, Dave

From: Kubeczko, Dave
Sent: Monday, November 30, 2009 12:35 PM
To: Kubeczko, Dave
Subject: FW: K P Kauffman Company State 3-14, NENW Sec 14 T4S R62W, Arapahoe County, Form 2A #1692867 Review

Scan No. 2032664 CORRESPONDENCE Form 2A#1692867

From: Sean T. Glass [mailto:STGlass@kpk.com]
Sent: Monday, November 23, 2009 3:42 PM
To: Kubeczko, Dave
Subject: FW: K P Kauffman Company State 3-14, NENW Sec 14 T4S R62W, Arapahoe County, Form 2A #1692867 Review

From: Sherry Glass
Sent: Mon 11/23/2009 2:54 PM
To: Sean T. Glass
Subject: FW: K P Kauffman Company State 3-14, NENW Sec 14 T4S R62W, Arapahoe County, Form 2A #1692867 Review

Please forward this to him also. Thanks. Having problems with getting email to COGCC.

From: Sherry Glass
Sent: Monday, November 23, 2009 2:54 PM
To: 'Kubeczko, Dave'
Subject: RE: K P Kauffman Company State 3-14, NENW Sec 14 T4S R62W, Arapahoe County, Form 2A #1692867 Review

The nearest building distance is actually 4792' (to northwest, just NW of water well) and nearest road is 4656' to northwest (power lines along road). Thanks.

From: Kubeczko, Dave [mailto:Dave.Kubeczko@state.co.us]
Sent: Monday, November 23, 2009 2:22 PM
To: Sherry Glass
Subject: K P Kauffman Company State 3-14, NENW Sec 14 T4S R62W, Arapahoe County, Form 2A #1692867 Review

Sherry,

I have been reviewing the K P Kauffman State 3-14 **Form 2A** (#1692867). COGCC requests the following clarifications regarding the data K P Kauffman has submitted on or attached to the Form 2A prior to passing the Oil and Gas Location Assessment.

1. **Cultural (Section 9):** The Form 2A indicates distances to nearest building of 5280 feet and the nearest above ground utility of 5280 feet. During COGCC's review of the 2005 aerial photograph, the distance to the nearest building was 3578 feet, but I couldn't verify the distance to the nearest above ground utility. Could you let me know where and how the nearest above ground utility was located. I can make the changes if you send an email with this request.

These are minor changes and I would like to pass this Form 2A. If you have any questions, please do not hesitate to call me at (970) 625-2497 x5 (office) or (970) 309-2514 (cell), or email. Thanks.


Dave

David A. Kubeczko, PG
Oil and Gas Location Assessment Specialist


Colorado Oil & Gas Conservation Commission
Northwest Area Office
707 Wapiti Court, Suite 204
Rifle, CO 81650
Phone: (970) 625-2497x5
FAX: (970) 625-5682
Cell: (970) 309-2514
dave.kubeczko@state.co.us



 *Please consider the environment before printing this e-mail*

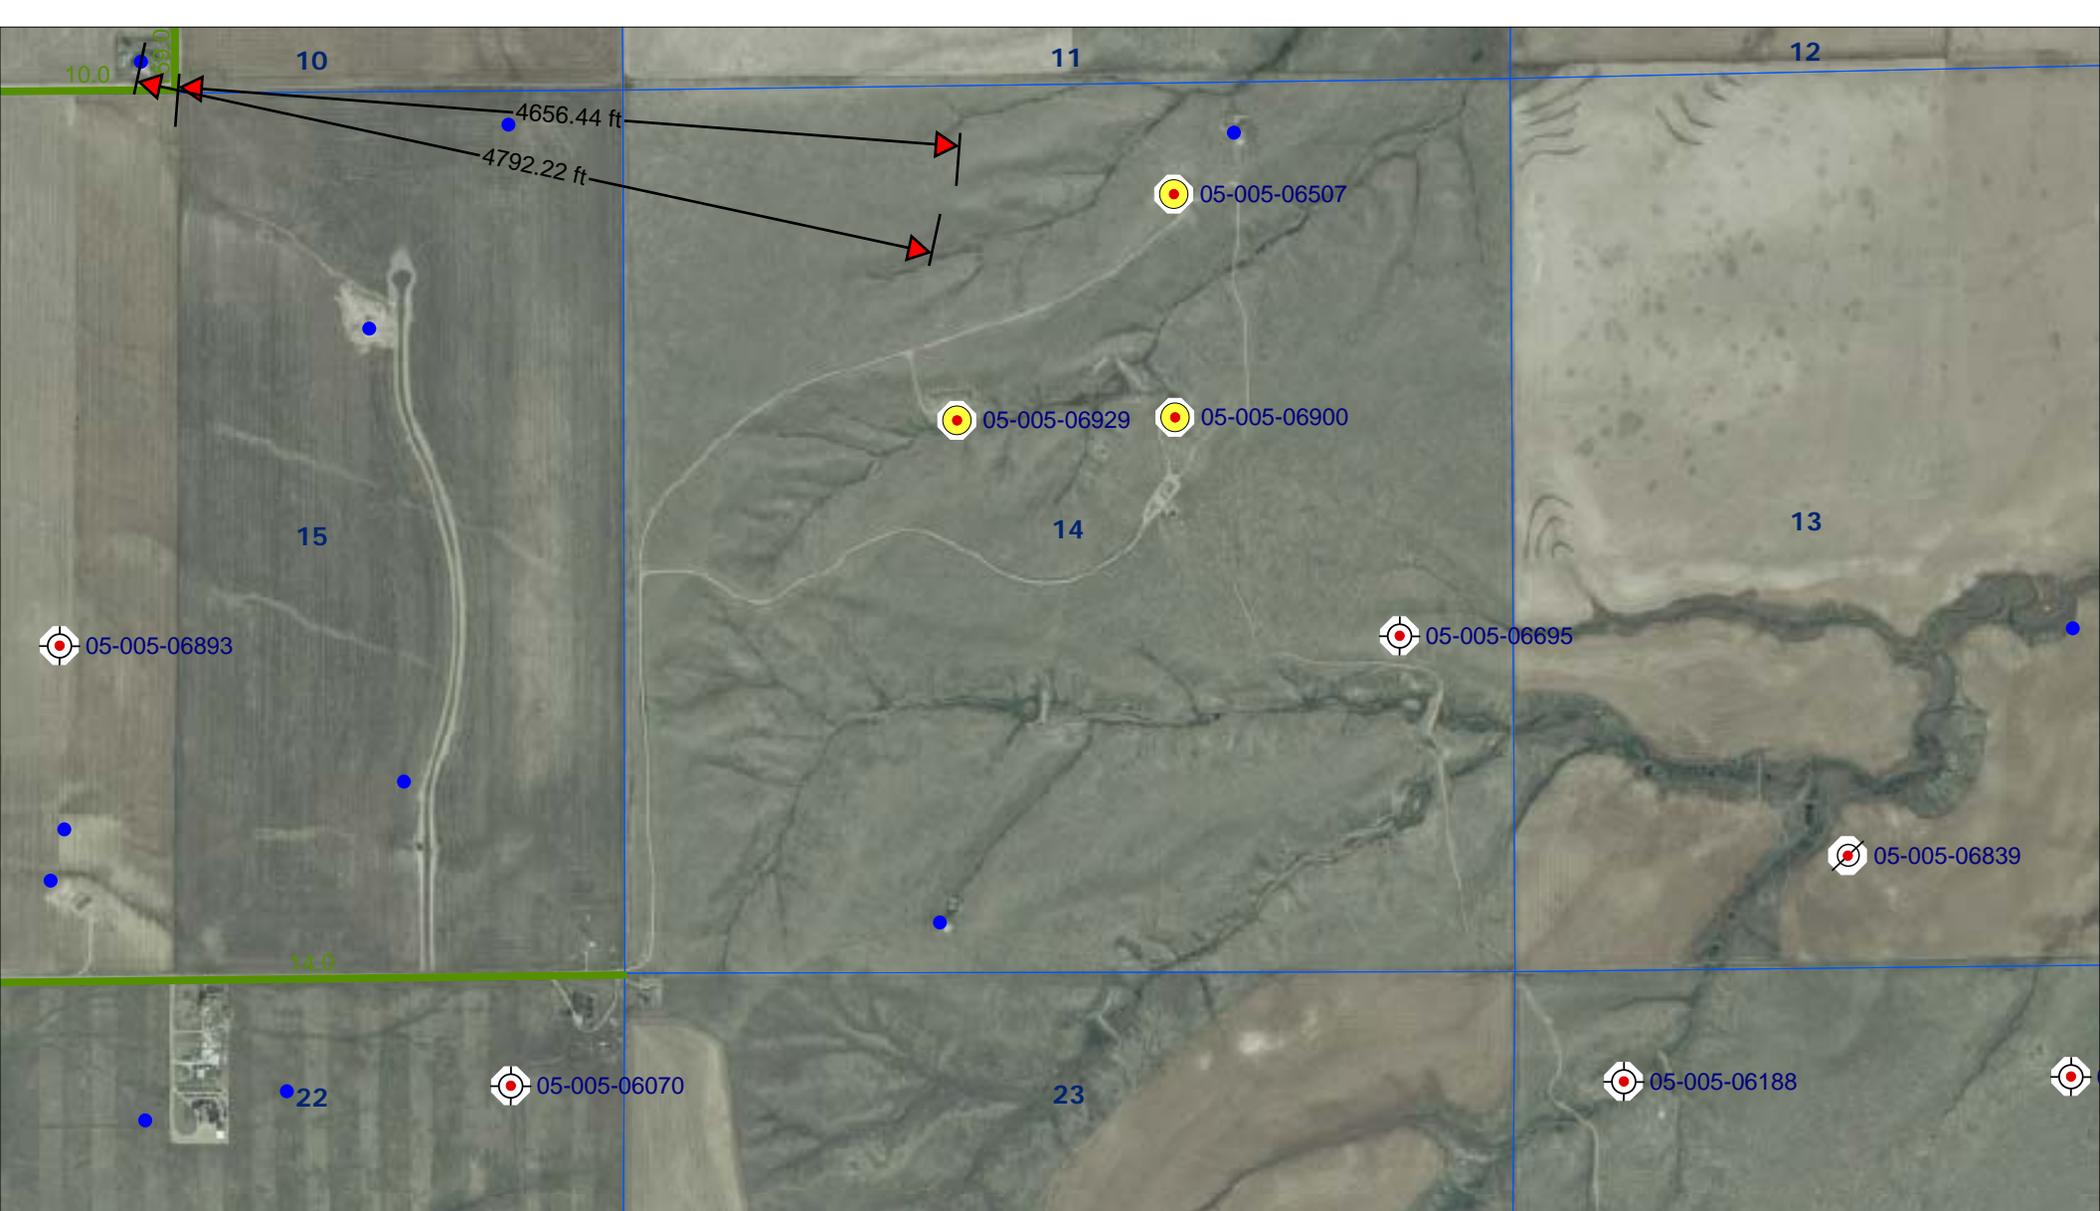

SCALE 1 : 27,064

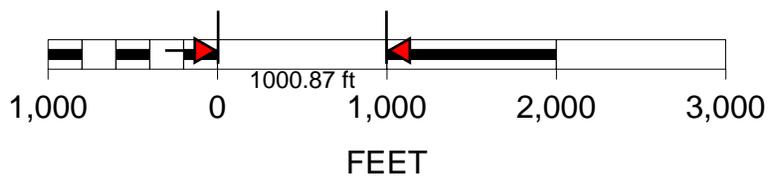

State #3-14 well location

Township 4 South, Range 62 West

Arapahoe County, Colorado

