

RECEIVED  
AUG 12 1959  
GROUND WATER SECT.  
COLORADO  
STATE ENGINEER

STATE OF COLORADO  
DIVISION OF WATER RESOURCES  
OFFICE OF THE STATE ENGINEER, GROUND WATER SECTION

REGISTRATION NO. [REDACTED] OF WELL #2  
#2

Registrant W. F. Egan SUPR Date 6-25 1959

P.O. Address Derby Route 1 Box 82, Colo.

WELL DATA

Depth 61 ft. Diameter 46 in.

Casing : 31 ft. Plain; 30 ft. Perfor.

Static Water Level \_\_\_\_\_ ft. from top

Yield 400 (gpm)(~~cfs~~) from 54 ft.

Used for irrigation on/at

SW 1/2 36, 26, 65W 6RN  
(legal description of land or site)

Water conveyed by \_\_\_\_\_, size \_\_\_\_\_

PUMP DATA

Type Turbine Size 6"

Driven by electricity 10 HP at \_\_\_\_\_ RPM

Well was first used 8-25, 1951

for irrigation using 400 cfs gpm

Well enlarged \_\_\_\_\_, 19\_\_ to deepened \_\_\_\_\_

(gpm)(cfs)(ft)


LOG SHOULD BE GIVEN ON REVERSE SIDE IF AVAILABLE

WELL LOCATION

County Adams 01

SW 1/4, NW 1/4 Section 36

Twp. 3S, Rge. 65W, 6 PM

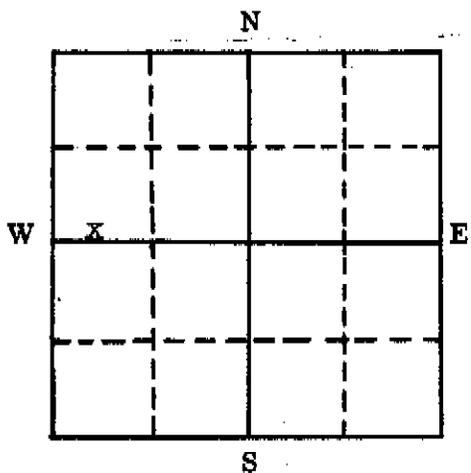

WELL TO BE LOCATED AS ACCURATELY AS POSSIBLE WITHIN A SMALL SQUARE WHICH REPRESENTS 40 ACRES; OR IF IN A TOWN OR SUBDIVISION FILL IN THE FOLLOWING:

\_\_\_\_\_ Town or Subdivision

\_\_\_\_\_ Street address or Lot and Block

The above well (has) (has not) been registered in the Office of the State Engineer prior to May 1, 1957. If Registered give Filing No. \_\_\_\_\_

If NOT Registered prior to May 1, 1957, a \$5.00 filing fee accompanies this form.

The above statements are true and correct to the best of my knowledge and belief. Subscribed and Sworn before me

this 1st day of August, 1959.

My commission expires October 25, 1959

W. F. Egan  
Registrant

(SEAL) \_\_\_\_\_  
Notary Public

900088

FOR STATE ENGINEER'S USE

Located in 1-1 district, Adams County for Irrigation

Registration No. 979 in 1-1, on August 12, 1959