


MULTI-WELL PLAN

Baseline Engineering Corp. 710 11th Avenue Suite 105 Greeley, Colorado 80631

SITE SKETCH


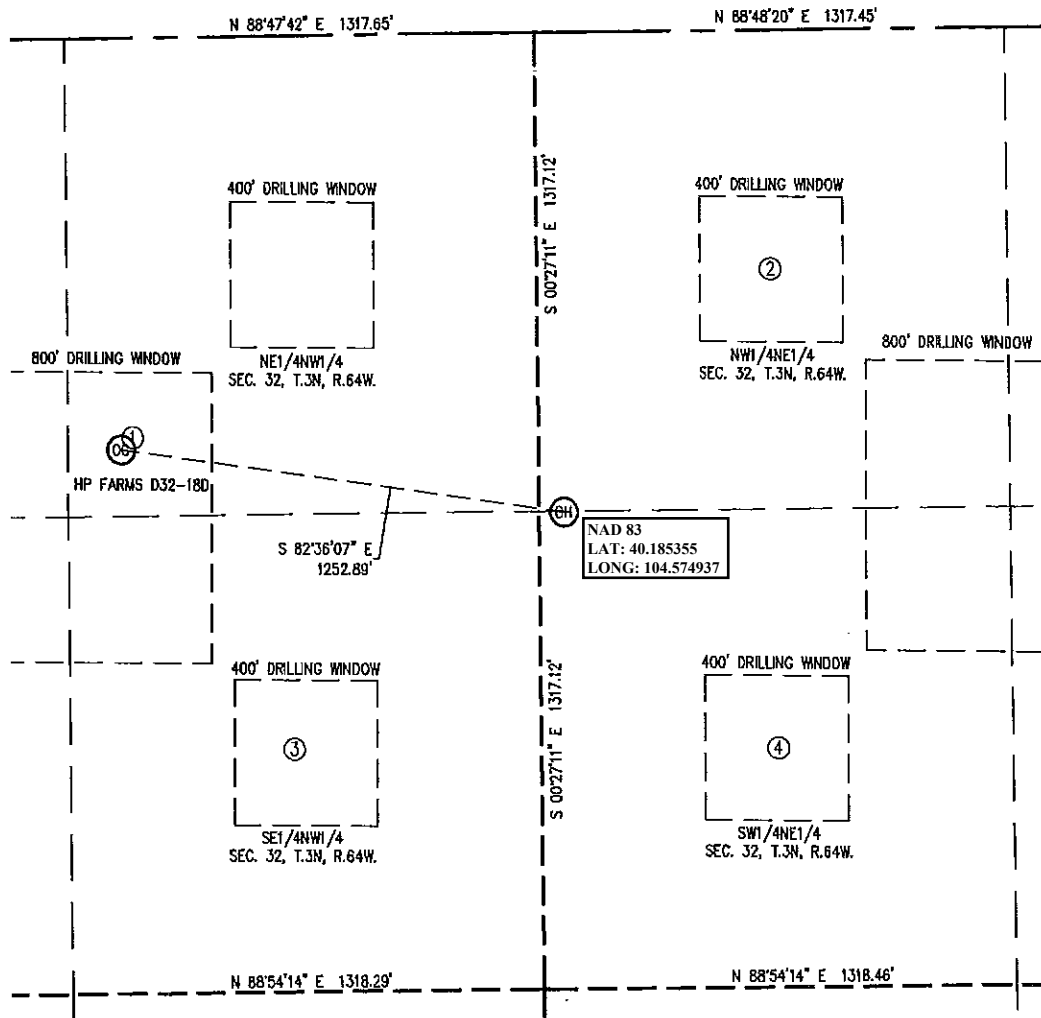

①	②	③	④
NORRIS D 32-2J	NORRIS D 32-2	NORRIS D 32-6	NORRIS D 32-7
NE/NW	NW/NE	SE/NW	SW/NE
1499' FWL	1979' FEL	1946' FWL	1973' FEL
1100' FNL	657' FNL	1965' FNL	1976' FNL
EL 4827'	EL 4838'	EL 4834'	EL 4851'
N 40.185923°	N 40.187190°	N 40.183562°	N 40.183571°
W 104.579257°	W 104.572837°	W 104.577664°	W 104.572822°
PDOP: 2.2	PDOP: 1.9	PDOP: 1.9	PDOP: 1.6

NOTES:

- THIS SKETCH DOES NOT REPRESENT A BOUNDARY SURVEY.
- THE DATUM FOR THE LATITUDES AND LONGITUDES ON THIS SKETCH IS NAD83.

